

FEE \$ 10.00
TCP \$ 1539.00
SIF \$ 460.00

**PLANNING CLEARANCE**  
 (Single Family Residential and Accessory Structures)  
**Community Development Department**

BLDG PERMIT NO. \_\_\_\_\_

Building Address 578 1/2 Belhaven Way No. of Existing Bldgs \_\_\_\_\_ No. Proposed 1  
 Parcel No. 2943-071-00-0053-020 Sq. Ft. of Existing Bldgs \_\_\_\_\_ Sq. Ft. Proposed 1601 #  
 Subdivision Belhaven Sq. Ft. of Lot / Parcel 3615 #  
 Filing 1 Block 3 Lot 20 Sq. Ft. Coverage of Lot by Structures & Impervious Surface  
 (Total Existing & Proposed) +545 # 1601 #  
 Height of Proposed Structure 19'

**OWNER INFORMATION:**

Name Belhaven LLC  
 Address 2350 G Road  
 City / State / Zip Grand Junction, CO 81505

**DESCRIPTION OF WORK & INTENDED USE:**

New Single Family Home (\*check type below)  
 Interior Remodel  Addition  
 Other (please specify): \_\_\_\_\_

**APPLICANT INFORMATION:**

Name Sonshine II  
 Address 2350 G Road  
 City / State / Zip Grand Junction, CO 81506  
 Telephone 255-8853

**\*TYPE OF HOME PROPOSED:**

Site Built  Manufactured Home (UBC)  
 Manufactured Home (HUD)  
 Other (please specify): \_\_\_\_\_

NOTES: \_\_\_\_\_

**REQUIRED: One plot plan, on 8 1/2" x 11" paper, showing all existing & proposed structure location(s), parking, setbacks to all property lines, ingress/egress to the property, driveway location & width & all easements & rights-of-way which abut the parcel.**

THIS SECTION TO BE COMPLETED BY COMMUNITY DEVELOPMENT DEPARTMENT STAFF	
ZONE <u>RMF-8</u>	Maximum coverage of lot by structures <u>70%</u>
SETBACKS: Front <u>20'</u> from property line (PL)	Permanent Foundation Required: YES <input checked="" type="checkbox"/> NO <input type="checkbox"/>
Side <u>5'</u> from PL Rear <u>10'</u> from PL	Parking Requirement <u>2</u>
Maximum Height of Structure(s) <u>35'</u>	Special Conditions _____
Voting District <u>"D"</u> Driveway Location Approval <u>RAJ</u> (Engineer's Initials)	_____

Modifications to this Planning Clearance must be approved, in writing, by the Community Development Department. The structure authorized by this application cannot be occupied until a final inspection has been completed and a Certificate of Occupancy has been issued, if applicable, by the Building Department (Section 305, Uniform Building Code).

I hereby acknowledge that I have read this application and the information is correct; I agree to comply with any and all codes, ordinances, laws, regulations or restrictions which apply to the project. I understand that failure to comply shall result in legal action, which may include but not necessarily be limited to non-use of the building(s).


Applicant Signature [Signature] Date 10/2/06  
 Department Approval [Signature] Date 12/12/06

Additional water and/or sewer tap fee(s) are required: YES <input checked="" type="checkbox"/> NO <input type="checkbox"/>	W/O No. <u>Pd @ LGV</u>
Utility Accounting <u>[Signature]</u>	Date <u>12/12/06</u>

VALID FOR SIX MONTHS FROM DATE OF ISSUANCE (Section 2.2.C.1 Grand Junction Zoning & Development Code)  
 (White: Planning) (Yellow: Customer) (Pink: Building Department) (Goldenrod: Utility Accounting)

**NOTICE:**

- IT IS THE RESPONSIBILITY OF THE BUILDER OR OWNER TO VERIFY ALL DETAILS AND DIMENSIONS PRIOR TO CONSTRUCTION.
- USE OF THIS PLAN CONSTITUTES BUILDER AND OR HOME OWNERS ACCEPTANCE OF THESE TERMS.
- ALL DIMENSIONS ARE TO EDGE OF FOUNDATION UNLESS OTHERWISE NOTED.
- BUILDER AND OR OWNER TO VERIFY ALL SETBACKS AND EASEMENTS.
- THIS PLAN HAS NOT BEEN ENGINEERED BY AUTODRAFT. SEE SEPARATE DRAWINGS BY OTHERS FOR ENGINEERING DATA.

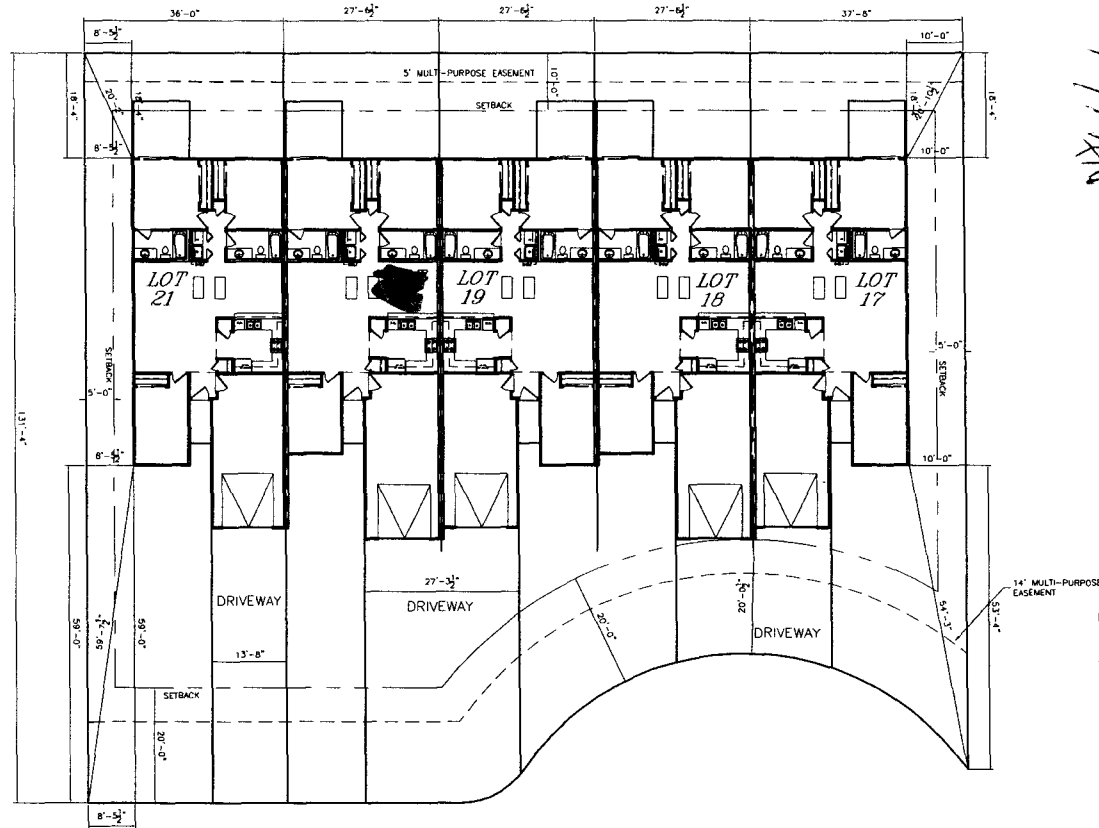

*Delishia Chagn 12/12/05*

**ACCEPTED**

**ANY CHANGES TO SETBACKS MUST BE APPROVED BY PLANNING DEPARTMENT**


**EASEMENTS**

*Jan 24 2006*

**NOTE:**  
GRADE MUST SLOPE AWAY FROM HOUSE 6" OF FALL IN THE FIRST 10' OF DISTANCE PER LOCAL BUILDING CODE.


**NOTE:**  
DIMENSION LINES ARE PULLED FROM EDGE OF BRICK LEDGE IF NO BRICK LEDGE EXISTS. DIMENSIONS WILL BE FROM EDGE OF FOUNDATION.

**NOTE:**  
BUILDER TO VERIFY ALL SETBACK AND EASEMENT ENCROACHMENTS PRIOR TO CONSTRUCTION

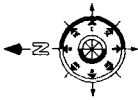

REVISIONS	
NO.	DATE

**Autodraft**  
 COMPUTER AIDED DRAFTING  
 GRAND JUNCTION, CO (970) 241-8782

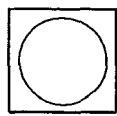

**SONSHINE II**  
**BLOCK 3, LOTS 17-21**

**Drawn By**  
**AUTODRAFT**  
**FILE NAME**

**DATE**  
 10-31-05

**SCALE**  
 1" = 10'-0"

**SITE**

**BELHAVEN WAY**

UNIT INFORMATION		UNIT INFORMATION		UNIT INFORMATION		UNIT INFORMATION		UNIT INFORMATION	
LOT NUMBER	21	LOT NUMBER	20	LOT NUMBER	19	LOT NUMBER	18	LOT NUMBER	17
BLOCK NUMBER	3	BLOCK NUMBER	3	BLOCK NUMBER	3	BLOCK NUMBER	3	BLOCK NUMBER	3
STREET ADDRESS	7	STREET ADDRESS	7	STREET ADDRESS	7	STREET ADDRESS	7	STREET ADDRESS	7
GARAGE SQ. FT.	371 SF	GARAGE SQ. FT.	383 SF	GARAGE SQ. FT.	365 SF	GARAGE SQ. FT.	383 SF	GARAGE SQ. FT.	365 SF
LIVING SQ. FT.	1228 SF	LIVING SQ. FT.	1208 SF	LIVING SQ. FT.	1229 SF	LIVING SQ. FT.	1208 SF	LIVING SQ. FT.	1228 SF
LOT SIZE	4728 SF	LOT SIZE	3615 SF	LOT SIZE	3424 SF	LOT SIZE	2962 SF	LOT SIZE	4191 SF

**SCALE: 1" = 10'-0"**

SITE PLAN INFORMATION	
SUBDIVISION NAME	BELHAVEN
FILE NUMBER	1
COUNTY	MESA
SETBACKS USED	FRONT 20' SIDES 5' REAR 10'