

FEE \$	10.00
TCP \$	1539.00
SIF \$	460.00

**PLANNING CLEARANCE**  
 (Single Family Residential and Accessory Structures)  
**Community Development Department**

BLDG PERMIT NO. \_\_\_\_\_

Building Address 585 BELHAVEN WAY No. of Existing Bldgs 0 No. Proposed 1  
 Parcel No. 2943-011-00-0053-006 Sq. Ft. of Existing Bldgs 0 Sq. Ft. Proposed 1593  
 Subdivision Belhaven Sq. Ft. of Lot / Parcel 2853  
 Filing 1 Block 3 Lot 6 Sq. Ft. Coverage of Lot by Structures & Impervious Surface (Total Existing & Proposed) 1593  
 Height of Proposed Structure 19'

**OWNER INFORMATION:**

Name Belhaven LLC  
 Address 2350 G Road  
 City / State / Zip Grand Junction, CO 81505

**DESCRIPTION OF WORK & INTENDED USE:**

New Single Family Home (\*check type below)  
 Interior Remodel  Addition  
 Other (please specify): \_\_\_\_\_

**APPLICANT INFORMATION:**

Name Sonshine II  
 Address 2350 G Road  
 City / State / Zip Grand Junction, CO 81505  
 Telephone 255-8853

**\*TYPE OF HOME PROPOSED:**

Site Built  Manufactured Home (UBC)  
 Manufactured Home (HUD)  
 Other (please specify): \_\_\_\_\_

NOTES: \_\_\_\_\_

**REQUIRED: One plot plan, on 8 1/2" x 11" paper, showing all existing & proposed structure location(s), parking, setbacks to all property lines, ingress/egress to the property, driveway location & width & all easements & rights-of-way which abut the parcel.**

<b>THIS SECTION TO BE COMPLETED BY COMMUNITY DEVELOPMENT DEPARTMENT STAFF</b>	
ZONE <u>RMF-8</u>	Maximum coverage of lot by structures <u>70%</u>
SETBACKS: Front <u>20'</u> from property line (PL)	Permanent Foundation Required: YES <input checked="" type="checkbox"/> NO <input type="checkbox"/>
Side <u>5'</u> from PL Rear <u>10'</u> from PL	Parking Requirement <u>2</u>
Maximum Height of Structure(s) <u>35'</u>	Special Conditions _____
Voting District <u>"D"</u> Driveway Location Approval <u>[Signature]</u> (Engineer's Initials)	

Modifications to this Planning Clearance must be approved, in writing, by the Community Development Department. The structure authorized by this application cannot be occupied until a final inspection has been completed and a Certificate of Occupancy has been issued, if applicable, by the Building Department (Section 305, Uniform Building Code).

I hereby acknowledge that I have read this application and the information is correct; I agree to comply with any and all codes, ordinances, laws, regulations or restrictions which apply to the project. I understand that failure to comply shall result in legal action, which may include but not necessarily be limited to non-use of the building(s).


Applicant Signature [Signature] Date 12/21/05  
 Department Approval [Signature] Date 10/5/06

Additional water and/or sewer tap fee(s) are required:	YES <input checked="" type="checkbox"/> NO <input type="checkbox"/>	W/O No. <u>Paid OREGV</u>
Utility Accounting <u>[Signature]</u>	Date <u>10/11/06</u>	

VALID FOR SIX MONTHS FROM DATE OF ISSUANCE (Section 2.2.C.1 Grand Junction Zoning & Development Code)  
 (White: Planning) (Yellow: Customer) (Pink: Building Department) (Goldenrod: Utility Accounting)

A
B
C
D
E
F
G
H

**AutoDRAFT**  
 COMPUTER AIDED DRAFTING  
 GRAND JUNCTION, CO (970) 241-6782


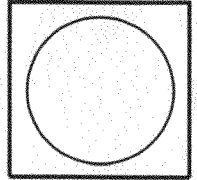


SONSHINE II  
 BLOCK 3, LOTS 5-8

DRAWN BY  
 AUTODRAFT  
 FILE NAME  
 DATE  
 10-31-05  
 SCALE  
 1" = 10'-0"

**NOTICE:**  
 1. IT IS THE RESPONSIBILITY OF THE BUILDER OR OWNER TO VERIFY ALL DETAILS AND DIMENSIONS PRIOR TO CONSTRUCTION.  
 2. USE OF THIS PLAN CONSTITUTES BUILDER AND OR HOME OWNERS ACCEPTANCE OF THESE TERMS.  
 3. ALL DIMENSIONS ARE TO EDGE OF FOUNDATION UNLESS OTHERWISE NOTED.  
 4. BUILDER AND OR OWNER TO VERIFY ALL SETBACKS AND EASEMENTS.  
 5. THIS PLAN HAS NOT BEEN ENGINEERED BY AUTODRAFT. SEE SEPARATE DRAWINGS BY OTHERS FOR ENGINEERING DATA.

ACCEPTED  
 BY *Julien A. De*  
 ANY CHANGE OF SETBACKS MUST APPROVED BY THE CITY PLANNING DEPT. IT IS THE APPLICANTS RESPONSIBILITY TO PROPERLY LOCATE AND IDENTIFY EASEMENT AND PROPERTY LINES.

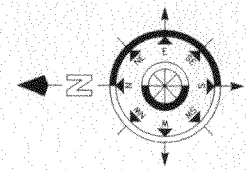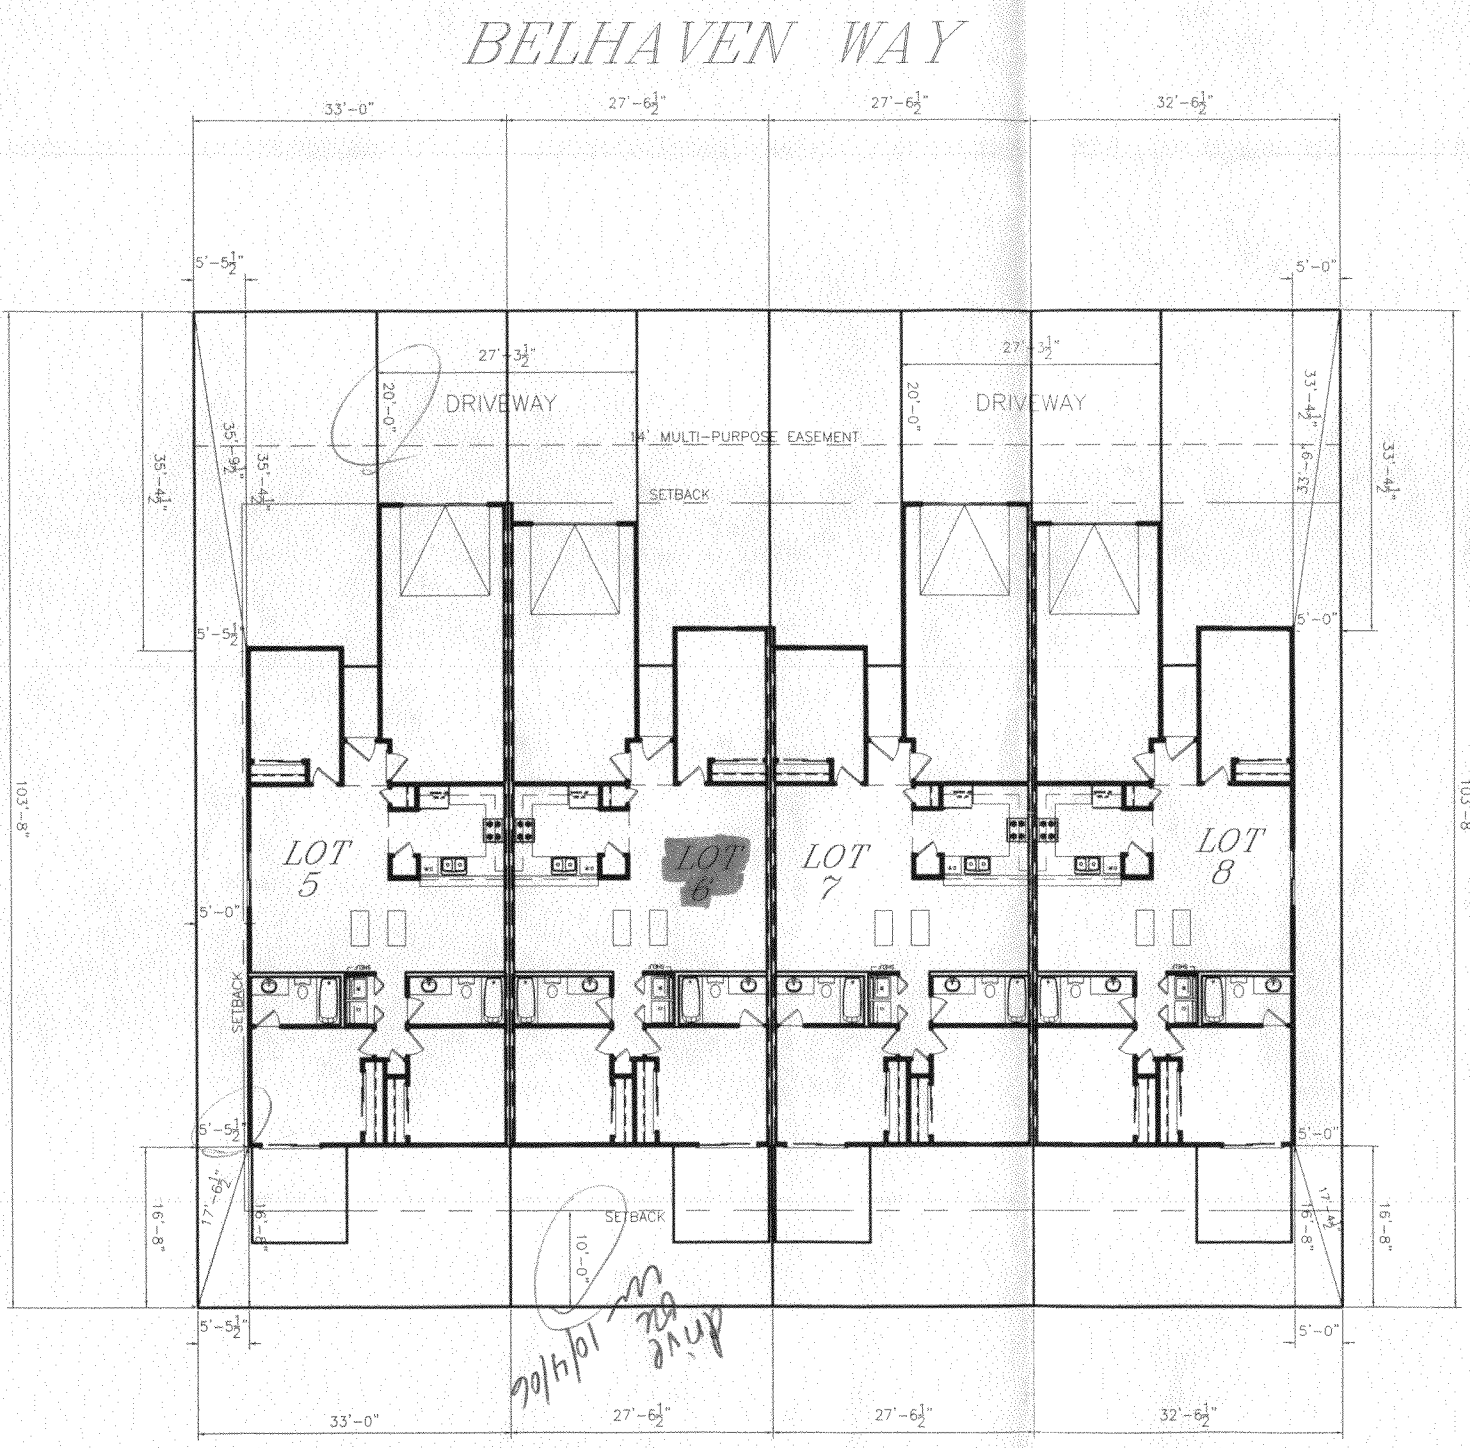

NOTE:  
 GRADE MUST SLOPE AWAY FROM HOUSE 6" OF FALL IN THE FIRST 10' OF DISTANCE PER LOCAL BUILDING CODE.

NOTE:  
 DIMENSION LINES ARE PULLED FROM EDGE OF BRICK LEDGE. IF NO BRICK LEDGE EXISTS, DIMENSIONS WILL BE FROM EDGE OF FOUNDATION.

NOTE:  
 BUILDER TO VERIFY ALL SETBACK AND EASEMENT ENCROACHMENTS PRIOR TO CONSTRUCTION

UNIT INFORMATION	
LOT NUMBER	5
BLOCK NUMBER	3
STREET ADDRESS	?
GARAGE SQ. FT.	393 SF
LIVING SQ. FT.	1208 SF
LOT SIZE	3421 SF

UNIT INFORMATION	
LOT NUMBER	6
BLOCK NUMBER	3
STREET ADDRESS	?
GARAGE SQ. FT.	365 SF
LIVING SQ. FT.	1229 SF
LOT SIZE	2853 SF

UNIT INFORMATION	
LOT NUMBER	7
BLOCK NUMBER	3
STREET ADDRESS	?
GARAGE SQ. FT.	393 SF
LIVING SQ. FT.	1208 SF
LOT SIZE	2853 SF

UNIT INFORMATION	
LOT NUMBER	8
BLOCK NUMBER	3
STREET ADDRESS	?
GARAGE SQ. FT.	365 SF
LIVING SQ. FT.	1228 SF
LOT SIZE	3372 SF

SITE PLAN INFORMATION	
SUBDIVISION NAME	BELHAVEN
FILING NUMBER	1
COUNTY	MESA