

FEE \$ 10.00
 TCP \$ 1539.00
 SIF \$ 460.00

PLANNING CLEARANCE
 (Single Family Residential and Accessory Structures)
Community Development Department

BLDG PERMIT NO. _____

Building Address 589 1/2 BELHAVEN
 Parcel No. 2943-071-00-005
 Subdivision Belhaven
 Filing 1 Block 2 Lot 10

No. of Existing Bldgs _____ No. Proposed 1
 Sq. Ft. of Existing Bldgs _____ Sq. Ft. Proposed 1601 #
 Sq. Ft. of Lot / Parcel 2873 #
 Sq. Ft. Coverage of Lot by Structures & Impervious Surface
 (Total Existing & Proposed) 1545 # 1601 #
 Height of Proposed Structure 19'

OWNER INFORMATION:

Name Belhaven, LLC
 Address 2350 G Road
 City / State / Zip Grand Junction, CO 81505

DESCRIPTION OF WORK & INTENDED USE:

New Single Family Home (*check type below)
 Interior Remodel Addition
 Other (please specify): _____

APPLICANT INFORMATION:

Name Sonshine II
 Address 2350 G Road
 City / State / Zip Grand Junction, CO 81505
 Telephone 255-8853

***TYPE OF HOME PROPOSED:**

Site Built Manufactured Home (UBC)
 Manufactured Home (HUD)
 Other (please specify): _____

NOTES: _____

REQUIRED: One plot plan, on 8 1/2" x 11" paper, showing all existing & proposed structure location(s), parking, setbacks to all property lines, ingress/egress to the property, driveway location & width & all easements & rights-of-way which abut the parcel.

THIS SECTION TO BE COMPLETED BY COMMUNITY DEVELOPMENT DEPARTMENT STAFF	
ZONE <u>Bmf-8</u>	Maximum coverage of lot by structures <u>70%</u>
SETBACKS: Front <u>20'</u> from property line (PL)	Permanent Foundation Required: YES <u>X</u> NO _____
Side <u>5'</u> from PL Rear <u>10'</u> from PL	Parking Requirement <u>2</u>
Maximum Height of Structure(s) <u>35'</u>	Special Conditions _____
Voting District _____	Driveway Location Approval <u>[Signature]</u> (Engineer's Initials)

Modifications to this Planning Clearance must be approved, in writing, by the Community Development Department. The structure authorized by this application cannot be occupied until a final inspection has been completed and a Certificate of Occupancy has been issued, if applicable, by the Building Department (Section 305, Uniform Building Code).

I hereby acknowledge that I have read this application and the information is correct; I agree to comply with any and all codes, ordinances, laws, regulations or restrictions which apply to the project. I understand that failure to comply shall result in legal action, which may include but not necessarily be limited to non-use of the building(s).

Applicant Signature [Signature] Date 12/21/05
 Department Approval [Signature] Date 6/5/06


Additional water and/or sewer tap fee(s) are required:	YES	NO <u>[initials]</u>	W/O No. <u>[initials]</u>
Utility Accounting <u>[Signature]</u>	Date <u>6/5/06</u>		

VALID FOR SIX MONTHS FROM DATE OF ISSUANCE (Section 2.2.C.1 Grand Junction Zoning & Development Code)
 (White: Planning) (Yellow: Customer) (Pink: Building Department) (Goldenrod: Utility Accounting)


REVISIONS	
A	
B	
C	
D	
E	
F	
G	
H	

NOTICE:
 1. IT IS THE RESPONSIBILITY OF THE BUILDER OR OWNER TO VERIFY ALL DETAILS AND DIMENSIONS PRIOR TO CONSTRUCTION.
 2. USE OF THIS PLAN CONSTITUTES BUILDER AND OR HOME OWNERS ACCEPTANCE OF THESE TERMS.
 3. ALL DIMENSIONS ARE TO EDGE OF FOUNDATION UNLESS OTHERWISE NOTED.
 4. BUILDER AND OR OWNER TO VERIFY ALL SETBACKS AND EASEMENTS.
 5. THIS PLAN HAS NOT BEEN ENGINEERED BY AUTODRAFT. SEE SEPARATE DRAWINGS BY OTHERS FOR ENGINEERING DATA.

BELHAVEN WAY

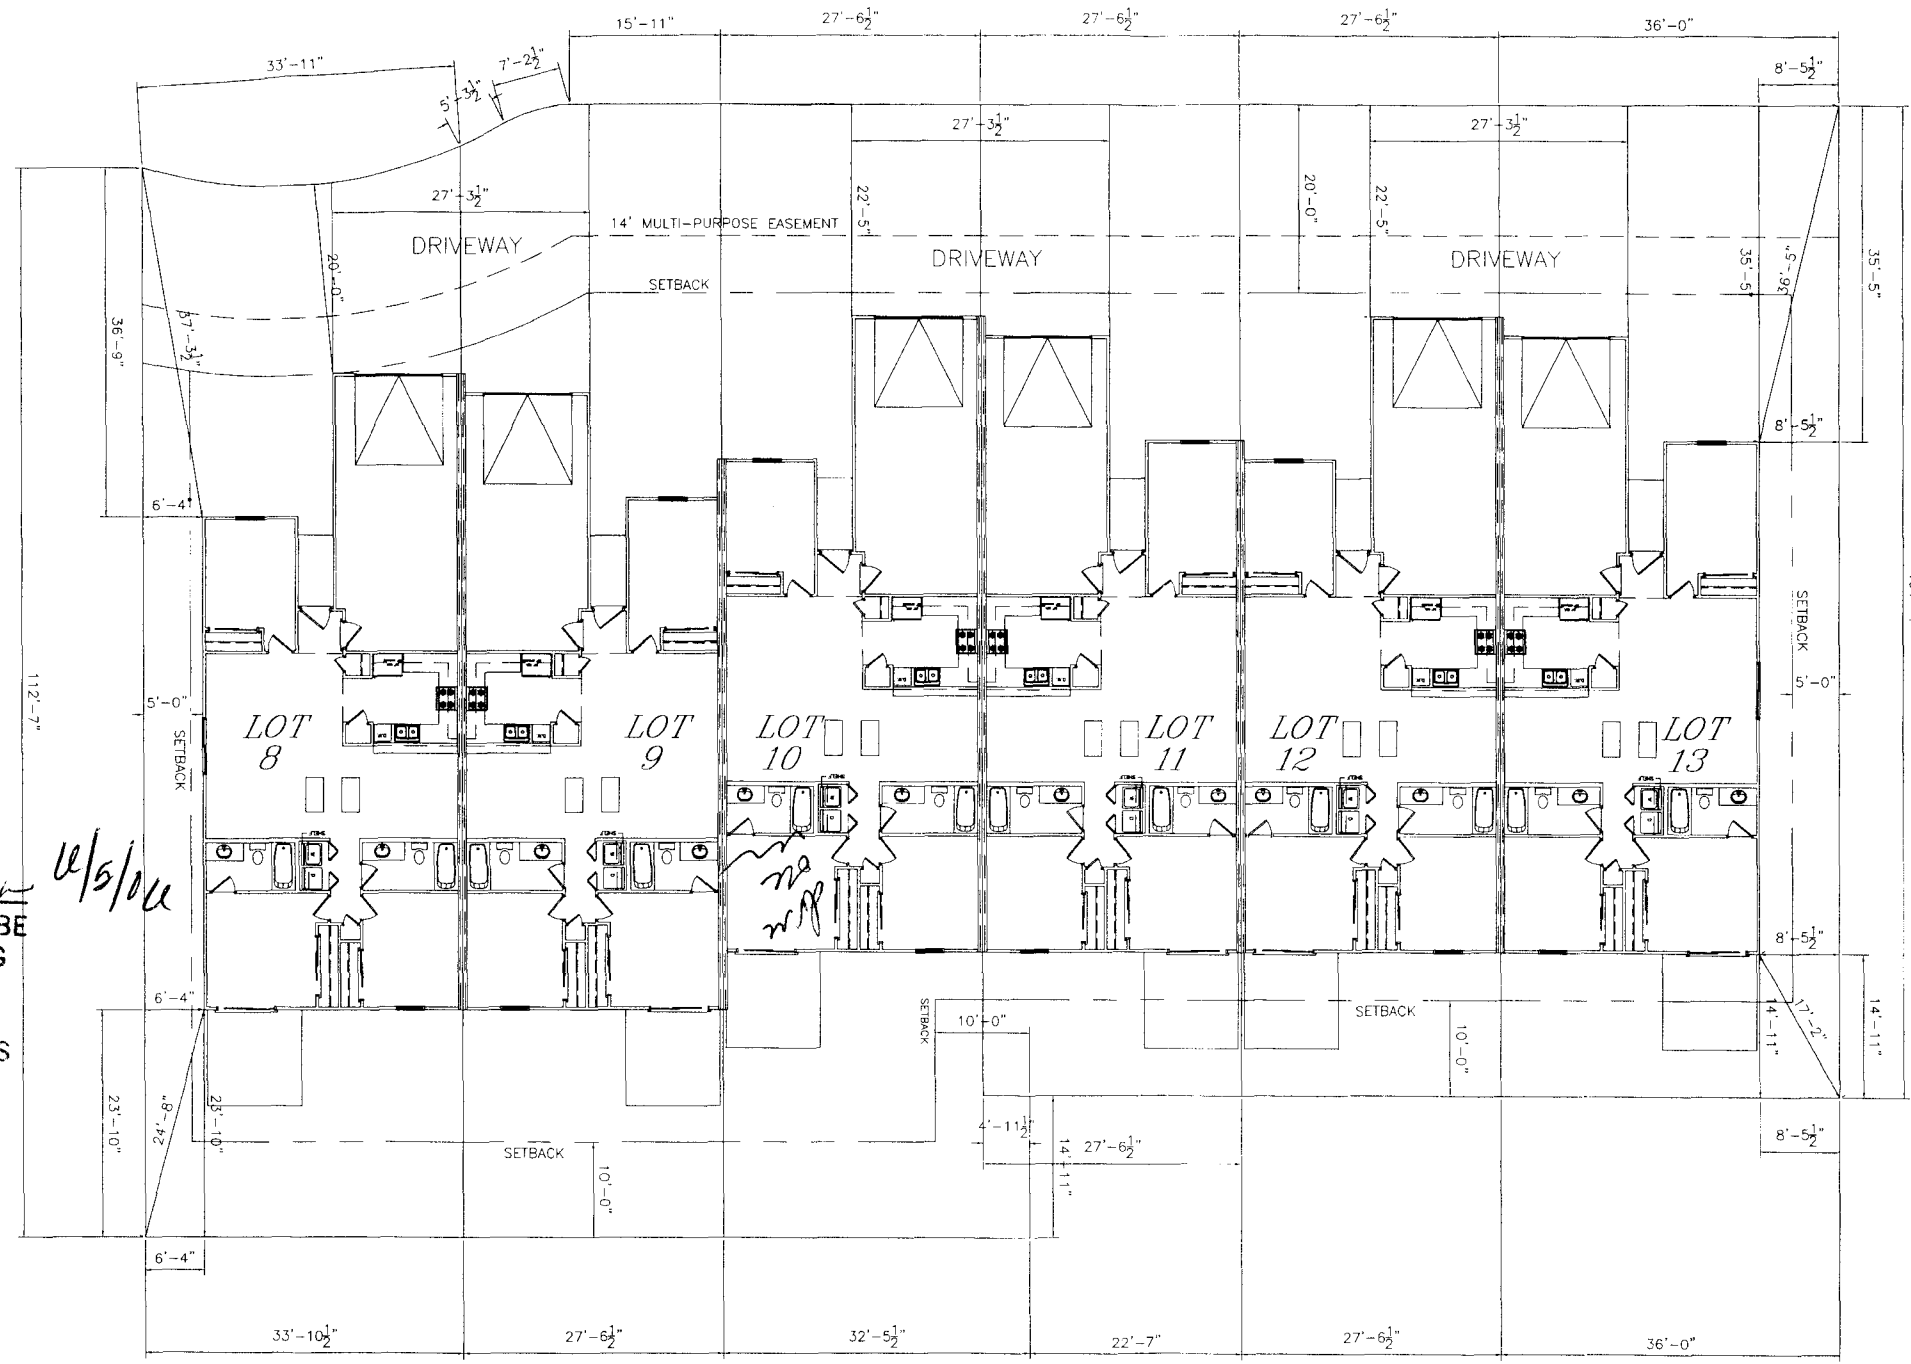

ACCEPTED *M. J. H. / 12/5/00*
 CHANGE OF SETBACKS MUST BE APPROVED BY THE CITY PLANNING DEPARTMENT. THE APPLICANT'S RESPONSIBILITY TO PROPERLY DETERMINE AND IDENTIFY EASEMENTS AND PROPERTY LINES.

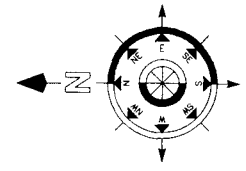


NOTE:
 GRADE MUST SLOPE AWAY FROM HOUSE 6" OF FALL IN THE FIRST 10' OF DISTANCE PER LOCAL BUILDING CODE.

NOTE:
 DIMENSION LINES ARE PULLED FROM EDGE OF BRICK LEDGE. IF NO BRICK LEDGE EXISTS, DIMENSIONS WILL BE FROM EDGE OF FOUNDATION.

NOTE:
 BUILDER TO VERIFY ALL SETBACK AND EASEMENT ENCROACHMENTS PRIOR TO CONSTRUCTION

Autodraft
 COMPUTER AIDED DRAFTING
 GRAND JUNCTION, CO (970) 241-6782

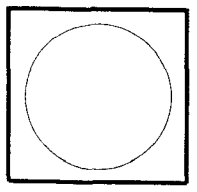

SONSHINE II
BLOCK 2, LOTS 8-13

UNIT INFORMATION		UNIT INFORMATION		UNIT INFORMATION		UNIT INFORMATION		UNIT INFORMATION		UNIT INFORMATION	
NUMBER	8	LOT NUMBER	9	LOT NUMBER	10	LOT NUMBER	11	LOT NUMBER	12	LOT NUMBER	13
BLOCK NUMBER	2	BLOCK NUMBER	2	BLOCK NUMBER	2	BLOCK NUMBER	2	BLOCK NUMBER	2	BLOCK NUMBER	2
STREET ADDRESS	?	STREET ADDRESS	?	STREET ADDRESS	?	STREET ADDRESS	?	STREET ADDRESS	?	STREET ADDRESS	?
GARAGE SQ. FT.	393 SF	GARAGE SQ. FT.	365 SF	GARAGE SQ. FT.	393 SF	GARAGE SQ. FT.	365 SF	GARAGE SQ. FT.	393 SF	GARAGE SQ. FT.	365 SF
LIVING SQ. FT.	1208 SF	LIVING SQ. FT.	1231 SF	LIVING SQ. FT.	1209 SF	LIVING SQ. FT.	1229 SF	LIVING SQ. FT.	1208 SF	LIVING SQ. FT.	1228 SF
TOTAL SQ. FT.	3780 SF	LOT SIZE	3263 SF	LOT SIZE	3357 SF	LOT SIZE	2873 SF	LOT SIZE	2873 SF	LOT SIZE	3757 SF

SCALE: 1" = 10'-0"

SITE PLAN INFORMATION	
SUBDIVISION NAME	BELHAVEN
FILING NUMBER	1
COUNTY	MESA
FRONT SETBACK	20'

DRAWN BY AUTODRAFT	
DATE	10-31-05
SCALE	1" = 10'-0"
SHEET	