

FEE \$ <u>10.00</u>
TCP \$
SIF \$

PLANNING CLEARANCE

BLDG PERMIT NO.

(Single Family Residential and Accessory Structures)
Community Development Department

Building Address 292 CEDAR ST
 Parcel No. 2945 252 00 103
 Subdivision _____
 Filing _____ Block _____ Lot _____

#X1
 No. of Existing Bldgs 3 No. Proposed STORAGE
 Sq. Ft. of Existing Bldgs 2768 Sq. Ft. Proposed 170 **SHED 50 FT**
 Sq. Ft. of Lot / Parcel 21120 **32 FT**
 Sq. Ft. Coverage of Lot by Structures & Impervious Surface (Total Existing & Proposed) _____
 Height of Proposed Structure 12 FT

OWNER INFORMATION:

Name TIM RICHTER
 Address 292 CEDAR ST
 City / State / Zip GJ CO 81503

DESCRIPTION OF WORK & INTENDED USE:
 New Single Family Home (*check type below)
 Interior Remodel Addition **STORAGE SHED**
 Other (please specify): _____

APPLICANT INFORMATION:

Name TIM RICHTER
 Address 292 CEDAR ST
 City / State / Zip GJ CO 81503
 Telephone 970 250 6886

*TYPE OF HOME PROPOSED:
 Site Built Manufactured Home (UBC)
 Manufactured Home (HUD)
 Other (please specify): _____

NOTES: _____

REQUIRED: One plot plan, on 8 1/2" x 11" paper, showing all existing & proposed structure location(s), parking, setbacks to all property lines, ingress/egress to the property, driveway location & width & all easements & rights-of-way which abut the parcel.

THIS SECTION TO BE COMPLETED BY COMMUNITY DEVELOPMENT DEPARTMENT STAFF	
ZONE <u>RMF-8</u>	Maximum coverage of lot by structures <u>70%</u>
SETBACKS: Front <u>25'</u> from property line (PL)	Permanent Foundation Required: YES _____ NO <u>X</u>
Side <u>3'</u> from PL Rear <u>5'</u> from PL	Parking Requirement <u>2</u>
Maximum Height of Structure(s) <u>35'</u>	Special Conditions _____
Voting District _____	Driveway Location Approval _____ (Engineer's Initials)

Modifications to this Planning Clearance must be approved, in writing, by the Community Development Department. The structure authorized by this application cannot be occupied until a final inspection has been completed and a Certificate of Occupancy has been issued, if applicable, by the Building Department (Section 305, Uniform Building Code).

I hereby acknowledge that I have read this application and the information is correct; I agree to comply with any and all codes, ordinances, laws, regulations or restrictions which apply to the project. I understand that failure to comply shall result in legal action, which may include but not necessarily be limited to non-use of the building(s).

Applicant Signature Tim Richter Date 7/17/06
 Department Approval Utshu Magan Date 7/17/06

Additional water and/or sewer tap fee(s) are required:	YES	NO <u>✓</u>	W/O No.
Utility Accounting <u>Waterbury</u>	Date <u>7/17/06</u>		

VALID FOR SIX MONTHS FROM DATE OF ISSUANCE (Section 2.2.C.1 Grand Junction Zoning & Development Code)
 (White: Planning) (Yellow: Customer) (Pink: Building Department) (Goldenrod: Utility Accounting)

IMPROVEMENT LOCATION CERTIFICATE

292 CEDAR STREET


FIRST AMERICAN TITLE #124770
RICHTER ACCT.

ACCEPTED *Althea Crayton 5/2/00*
ANY CHANGE OF SETBACKS MUST BE APPROVED BY THE CITY PLANNING DEPARTMENT. THE APPLICANT'S RESPONSIBILITY TO PROPERLY LOCATE AND IDENTIFY EASEMENTS AND PROPERTY LINES.

ACCEPTED *Althea Crayton 7/17/00*
ANY CHANGE OF SETBACKS MUST BE APPROVED BY THE CITY PLANNING DEPARTMENT. THE APPLICANT'S RESPONSIBILITY TO PROPERLY LOCATE AND IDENTIFY EASEMENTS AND PROPERTY LINES.

NOTE: A LAND SURVEY IS RECOMMENDED TO MORE ACCURATELY DETERMINE BUILDING SETBACKS.

SCALE: 1" = 30'

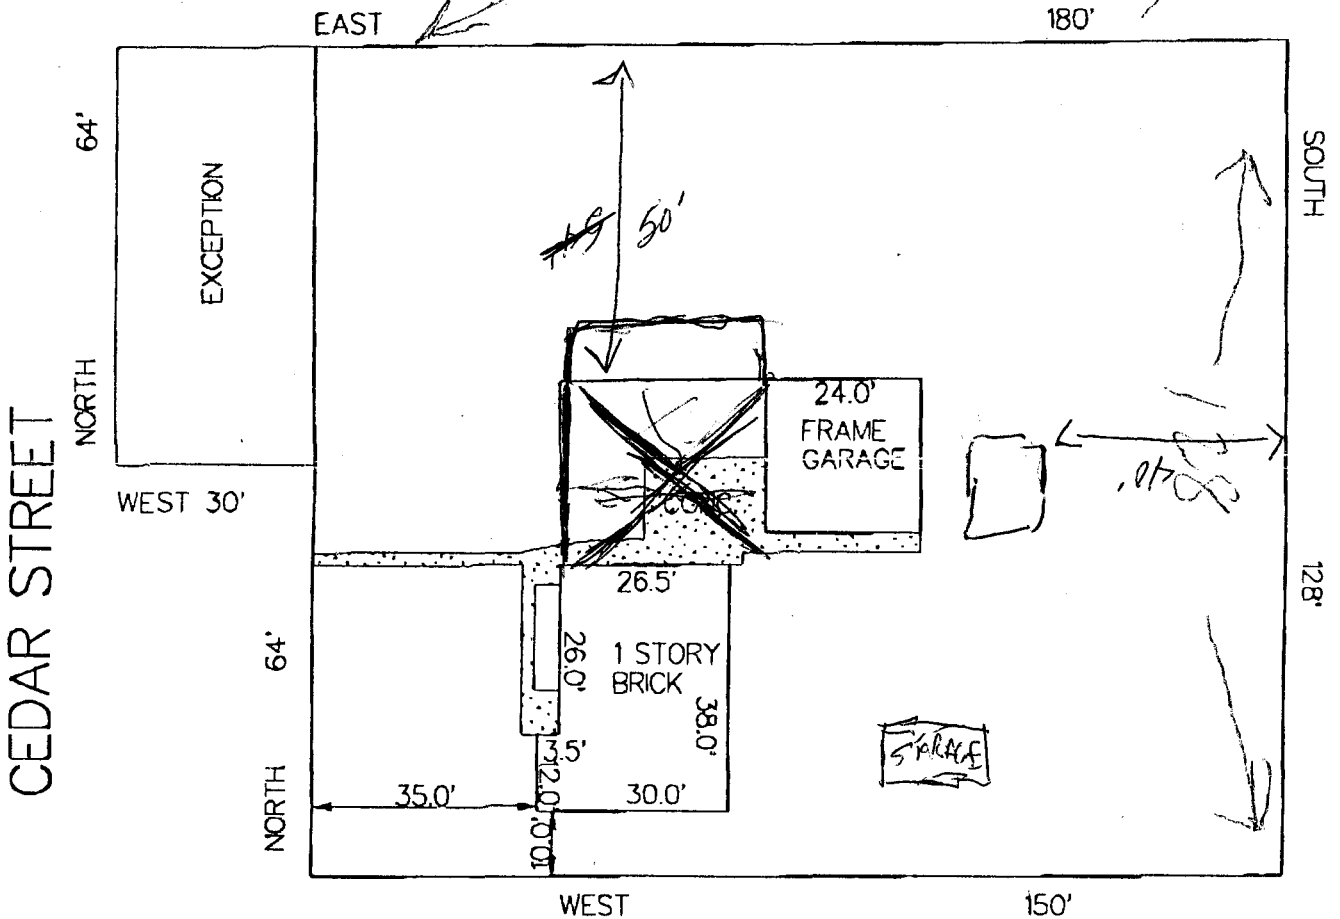


NOTE: THIS PROPERTY DOES NOT FALL WITHIN ANY 100 YEAR FLOODPLAIN.

HEREBY CERTIFY THAT THIS IMPROVEMENT LOCATION CERTIFICATE WAS PREPARED FOR FIRST WESTERN MORTGAGE, THAT IT IS NOT A LAND SURVEY PLAT OR IMPROVEMENT SURVEY PLAT, AND THAT IT IS NOT TO BE RELIED UPON FOR THE ESTABLISHMENT OF FENCE, BUILDING OR OTHER FUTURE IMPROVEMENT LINES. I FURTHER CERTIFY THE IMPROVEMENTS ON THE ABOVE DESCRIBED PARCEL ON THIS DATE, 10/30/96 EXCEPT UTILITY CONNECTIONS, ARE ENTIRELY WITHIN THE BOUNDARIES OF THE PARCEL, EXCEPT AS SHOWN, THAT THERE ARE NO ENCROACHMENTS UPON THE DESCRIBED PREMISES BY IMPROVEMENTS ON ANY ADJOINING PREMISES, EXCEPT AS INDICATED, AND THAT THERE IS NO EVIDENCE OR SIGN OF ANY EASEMENT CROSSING OR BORDENING ANY PART OF SAID PARCEL, EXCEPT AS NOTED.

● = FOUND PIN

Kenneth L. Glenn
KENNETH L. GLENN R.L.S. 12770

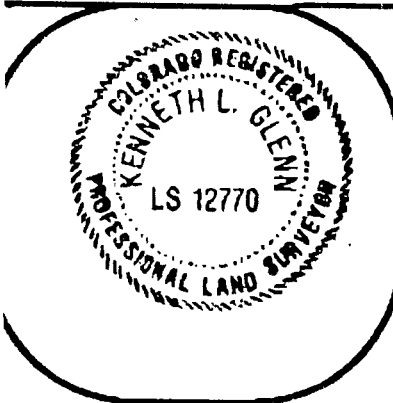

SURVEYIT		MAILING: 2754 COMPASS DRIVE SUITE 195 GRAND JUNCTION, CO. 81506	
PHONE: 970-245-3777	FAX: 241-4847	by GLENN	
SURVEYED BY: K.G.		DATE SURVEYED: 10/30/96	
DRAWN BY: S.S.		DATE DRAWN: 10/30/96	
REVISION:		SCALE: 1" = 30'	