

FEE \$ 10.^{00/}
 TCP \$ 1539.^{00/}
 SIF \$ 460.^{00/}

PLANNING CLEARANCE

(Single Family Residential and Accessory Structures)

Community Development Department

BLDG PERMIT NO. _____

Building Address 2819 Columbine Park Ct No. of Existing Bldgs e No. Proposed 1
 Parcel No. 2943-073-48-003 Sq. Ft. of Existing Bldgs e Sq. Ft. Proposed 1364
 Subdivision Columbine Park Sq. Ft. of Lot / Parcel 4567
 Filing _____ Block 2 Lot 3 Sq. Ft. Coverage of Lot by Structures & Impervious Surface (Total Existing & Proposed) _____
 Height of Proposed Structure _____

OWNER INFORMATION:

Name Tim Brady
 Address 514 28 1/2 Rd Suite 1
 City / State / Zip Grand Junction 81501

DESCRIPTION OF WORK & INTENDED USE:
 New Single Family Home (*check type below)
 Interior Remodel Addition
 Other (please specify): _____

APPLICANT INFORMATION:

Name Frontline Properties LLC
 Address 420 Montera St
 City / State / Zip Grand Jct 81503
 Telephone 970 ~~303~~ - 250-0156

*TYPE OF HOME PROPOSED:
 Site Built Manufactured Home (UBC)
 Manufactured Home (HUD)
 Other (please specify): _____

NOTES: _____

REQUIRED: One plot plan, on 8 1/2" x 11" paper, showing all existing & proposed structure location(s), parking, setbacks to all property lines, ingress/egress to the property, driveway location & width & all easements & rights-of-way which abut the parcel.

THIS SECTION TO BE COMPLETED BY COMMUNITY DEVELOPMENT DEPARTMENT STAFF

ZONE RMF-8 Maximum coverage of lot by structures 70%
 SETBACKS: Front 20 from property line (PL) Permanent Foundation Required: YES x NO _____
 Side 5 from PL Rear 10 from PL Parking Requirement 2
 Maximum Height of Structure(s) 35 Special Conditions Engineered foundation shall be required for each lot in this subdivision
 Voting District C Driveway Location Approval lu (Engineer's Initials)

Modifications to this Planning Clearance must be approved, in writing, by the Community Development Department. The structure authorized by this application cannot be occupied until a final inspection has been completed and a Certificate of Occupancy has been issued, if applicable, by the Building Department (Section 305, Uniform Building Code).

I hereby acknowledge that I have read this application and the information is correct; I agree to comply with any and all codes, ordinances, laws, regulations or restrictions which apply to the project. I understand that failure to comply shall result in legal action, which may include but not necessarily be limited to non-use of the building(s).

Applicant Signature [Signature] Date 9-13-06

Department Approval [Signature] Date 9/13/06 9/14/2006

Additional water and/or sewer tap fee(s) are required: YES NO W/O No 9475
 Utility Accounting [Signature] Date 9/14/06


VALID FOR SIX MONTHS FROM DATE OF ISSUANCE (Section 2.2.C.1 Grand Junction Zoning & Development Code)
 (White: Planning) (Yellow: Customer) (Pink: Building Department) (Goldenrod: Utility Accounting)

NOTICE:
 1. IT IS THE RESPONSIBILITY OF THE OWNER OR OWNER TO VERIFY ALL DETAILS AND DIMENSIONS PRIOR TO CONSTRUCTION.
 2. USE OF THIS PLAN CONSTITUTES BURDEN AND OR HOLDS OWNERS ACCEPTANCE OF THESE TERMS.
 3. ALL DIMENSIONS ARE TO EDGE OF FOUNDATION UNLESS OTHERWISE NOTED.
 4. BUILDER AND OR OWNER TO VERIFY ALL SETBACKS AND EASEMENTS.
 5. THIS PLAN HAS NOT BEEN ENGINEERED BY AUTODRAFT SEE SEPARATE DRAWINGS BY OTHERS FOR ENGINEERING DATA.

drive on
 9/13/06

2819 Columbine Park Ct


COLUMBINE PARK COURT

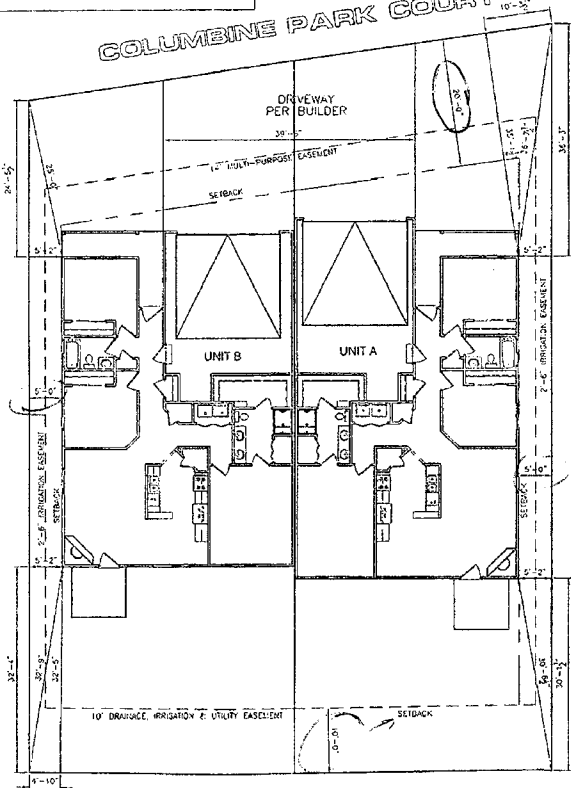

NOTE:
 GRADE MUST SLOPE AWAY FROM HOUSE 6" OF FALL IN THE FIRST 10' OF DISTANCE PER LOCAL BUILDING CODE

NOTE:
 DIMENSION LINES ARE PULLED FROM EDGE OF BRICK LEDGE IF NO BRICK LEDGE EXISTS. DIMENSIONS WILL BE FROM EDGE OF FOUNDATION.

NOTE:
 BUILDER TO VERIFY ALL SETBACK AND EASEMENT ENCROACHMENTS PRIOR TO CONSTRUCTION.

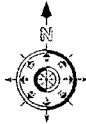


SITE PLAN INFORMATION	
SUBDIVISION NAME	COLUMBINE PARK SUBDIVISION
FILING NUMBER	N/A
LOT NUMBER	4
BLOCK NUMBER	2
STREET ADDRESS	2819 COLUMBINE PARK COURT
COUNTY	MESA
GARAGE SQ. FT.	478 SF
LIVING SQ. FT.	1350 SF
LOT SIZE	4543 SF
FRONT 20'	
SETBACKS USED	SIDES 5' FRONT 10'

SITE PLAN INFORMATION	
SUBDIVISION NAME	COLUMBINE PARK SUBDIVISION
FILING NUMBER	N/A
LOT NUMBER	3
BLOCK NUMBER	2
STREET ADDRESS	2819 COLUMBINE PARK COURT
COUNTY	MESA
GARAGE SQ. FT.	475 SF
LIVING SQ. FT.	1364 SF
LOT SIZE	4562 SF
FRONT 20'	
SETBACKS USED	SIDES 5' FRONT 10'

ACCEPTED FOR RECORD 9/13/06
 TONY PERY
 ANY ENCROACHMENTS MUST BE REMOVED
 BEFORE CONSTRUCTION
 VERIFY ALL PROPERTY EASEMENTS
 AND PROPERTY LINES

REVISIONS	
A	12/18/04 - PCS 1, 2
B	
C	
D	
E	
F	

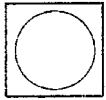

TONY PERY
 BRADY GROUP DUPLEX
 LOTS 3 & 4

CHECK BY	
AUTODRAFT	BY DATE
DATE	7/6/06
SCALE	1/8" = 1'-0"
SITE	