

FEE \$	10.00
TCP \$	1539.00
SIF \$	460.00

PLANNING CLEARANCE

(Single Family Residential and Accessory Structures)
Community Development Department

BLDG PERMIT NO. _____

Building Address 2925 F 1/4 ROAD
 Parcel No. 2943-053-77-001
 Subdivision FOREST ESTATES
 Filing 1 Block 1 Lot 1

No. of Existing Bldgs 0 No. Proposed 1
 Sq. Ft. of Existing Bldgs 0 Sq. Ft. Proposed 1890 ~~1926~~
 Sq. Ft. of Lot / Parcel 8240 ~~8240~~
 Sq. Ft. Coverage of Lot by Structures & Impervious Surface (Total Existing & Proposed) 3400 ~~3400~~
 Height of Proposed Structure 20'

OWNER INFORMATION:

Name MAX F. SNEDDON
 Address 2450 HOME RANCH CT.
 City / State / Zip G.T. / C.O 81505

DESCRIPTION OF WORK & INTENDED USE:

New Single Family Home (*check type below)
 Interior Remodel Addition
 Other (please specify): _____

APPLICANT INFORMATION:

Name SNEDDON CONSTRUCTION INC.
 Address _____
 City / State / Zip _____
 Telephone 970-201-9098

***TYPE OF HOME PROPOSED:**

Site Built Manufactured Home (UBC)
 Manufactured Home (HUD)
 Other (please specify): _____

NOTES: SINGLE FAMILY RESIDENTIAL

REQUIRED: One plot plan, on 8 1/2" x 11" paper, showing all existing & proposed structure location(s), parking, setbacks to all property lines, ingress/egress to the property, driveway location & width & all easements & rights-of-way which abut the parcel.

THIS SECTION TO BE COMPLETED BY COMMUNITY DEVELOPMENT DEPARTMENT STAFF	
ZONE <u>RMF-5</u>	Maximum coverage of lot by structures <u>60%</u>
SETBACKS: Front <u>20</u> from property line (PL)	Permanent Foundation Required: YES <input checked="" type="checkbox"/> NO <input type="checkbox"/>
Side <u>5'</u> from PL Rear <u>25'</u> from PL	Parking Requirement <u>2</u>
Maximum Height of Structure(s) <u>35'</u>	Special Conditions _____
Voting District <u>D</u> Driveway Location Approval <u>as noted</u> <u>UL</u> (Engineer's Initials)	_____


Modifications to this Planning Clearance must be approved, in writing, by the Community Development Department. The structure authorized by this application cannot be occupied until a final inspection has been completed and a Certificate of Occupancy has been issued, if applicable, by the Building Department (Section 305, Uniform Building Code).

I hereby acknowledge that I have read this application and the information is correct; I agree to comply with any and all codes, ordinances, laws, regulations or restrictions which apply to the project. I understand that failure to comply shall result in legal action, which may include but not necessarily be limited to non-use of the building(s).

Applicant Signature [Signature] Date 2-5/06
 Department Approval [Signature] Date 2/27/06

Additional water and/or sewer tap fee(s) are required:	YES <input checked="" type="checkbox"/>	NO <input type="checkbox"/>	W/O No. <u>18861</u>
Utility Accounting <u>[Signature]</u>	Date <u>2/27/06</u>		

VALID FOR SIX MONTHS FROM DATE OF ISSUANCE (Section 2.2.C.1 Grand Junction Zoning & Development Code)
 (White: Planning) (Yellow: Customer) (Pink: Building Department) (Goldenrod: Utility Accounting)

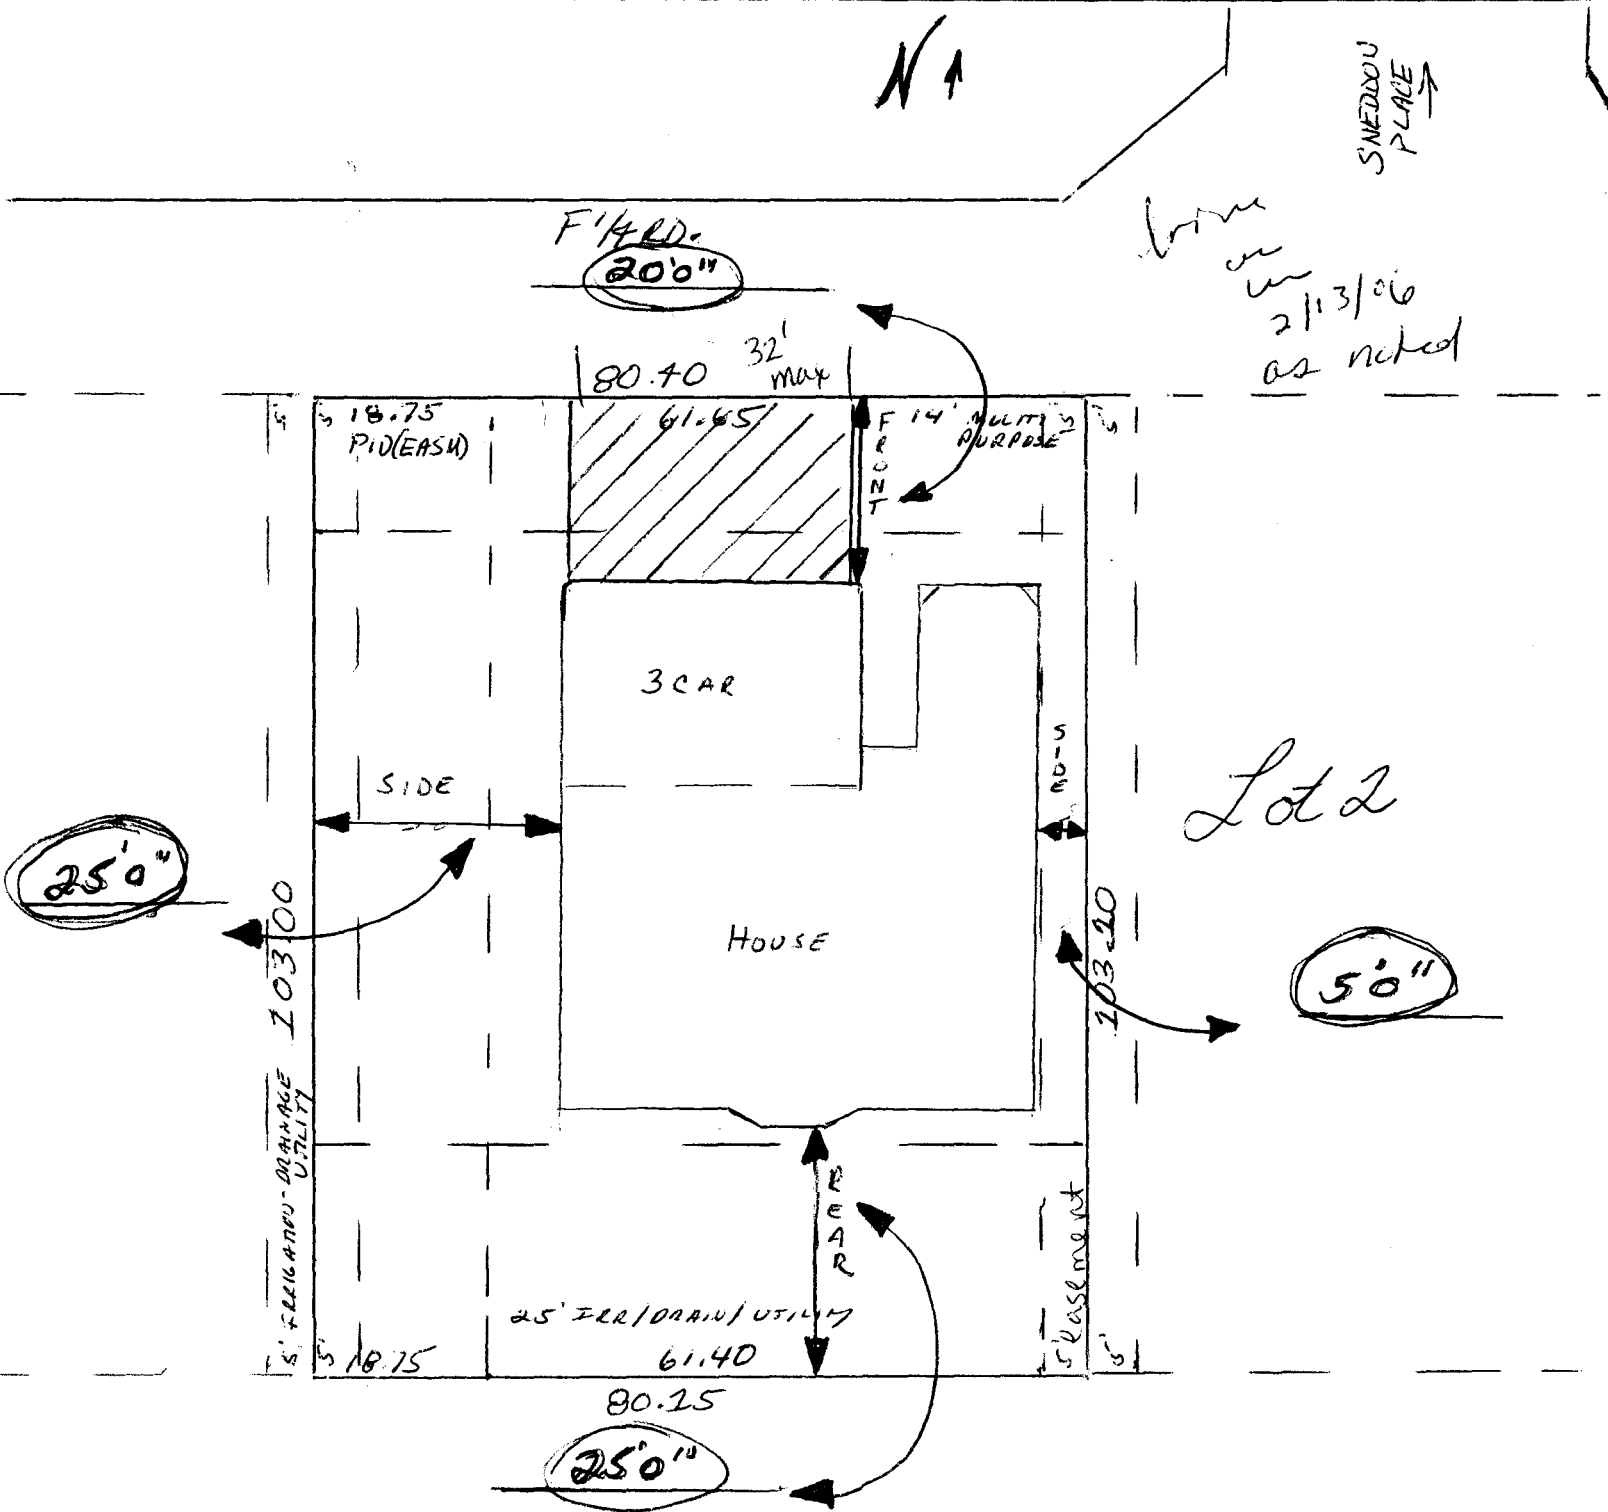

Home on 2/13/06 as noted

STH
 ACCEPTED C. Geyer Hall
 ANY CHANGE OF DIMENSIONS MUST BE
 APPROVED BY THE PLANNING
 DEPARTMENT. THE PLANNING
 DEPARTMENT IS NOT RESPONSIBLE FOR
 LOCAL ORDINANCES, ZONING ORDINANCES
 AND REGULATIONS.