

FEE \$	10.00
TCP \$	1539.00
SIF \$	400.00

PLANNING CLEARANCE

(Single Family Residential and Accessory Structures)
Community Development Department

BLDG PERMIT NO. _____

Building Address 2828 South Forest Ln.
 Parcel No. 2943-192-47-010
 Subdivision Summer Glen
 Filing _____ Block 2 Lot 10

No. of Existing Bldgs 0 No. Proposed 1
 Sq. Ft. of Existing Bldgs N/A Sq. Ft. Proposed 1272
 Sq. Ft. of Lot / Parcel 4844
 Sq. Ft. Coverage of Lot by Structures & Impervious Surface
 (Total Existing & Proposed) 1528
 Height of Proposed Structure _____

OWNER INFORMATION:

Name Darter LLC
 Address 788 Valley Ct.
 City / State / Zip 65 CO 81505

DESCRIPTION OF WORK & INTENDED USE:
 New Single Family Home (*check type below)
 Interior Remodel Addition
 Other (please specify): _____

APPLICANT INFORMATION:

Name Grace Hanes
 Address 786 Valley Ct.
 City / State / Zip 65 CO 81505
 Telephone 248-8522

*TYPE OF HOME PROPOSED:
 Site Built Manufactured Home (UBC)
 Manufactured Home (HUD)
 Other (please specify): _____

NOTES: _____

REQUIRED: One plot plan, on 8 1/2" x 11" paper, showing all existing & proposed structure location(s), parking, setbacks to all property lines, ingress/egress to the property, driveway location & width & all easements & rights-of-way which abut the parcel.

THIS SECTION TO BE COMPLETED BY COMMUNITY DEVELOPMENT DEPARTMENT STAFF	
ZONE <u>RMF-8</u>	Maximum coverage of lot by structures <u>70%</u>
SETBACKS: Front <u>20</u> from property line (PL)	Permanent Foundation Required: YES <input checked="" type="checkbox"/> NO <input type="checkbox"/>
Side <u>5</u> from PL Rear <u>10</u> from PL	Parking Requirement <u>2</u>
Maximum Height of Structure(s) <u>35</u>	Special Conditions <u>slab cannot be covered in 10' setback rear area</u>
Voting District <u>"E"</u> Driveway Location Approval _____ (Engineer's Initials)	

Modifications to this Planning Clearance must be approved, in writing, by the Community Development Department. The structure authorized by this application cannot be occupied until a final inspection has been completed and a Certificate of Occupancy has been issued, if applicable, by the Building Department (Section 305, Uniform Building Code).


I hereby acknowledge that I have read this application and the information is correct; I agree to comply with any and all codes, ordinances, laws, regulations or restrictions which apply to the project. I understand that failure to comply shall result in legal action, which may include but not necessarily be limited to non-use of the building(s).

Applicant Signature [Signature] Agent Date 6/13/06
 Department Approval [Signature] Date 6/30/06


Additional water and/or sewer tap fee(s) are required: YES <input checked="" type="checkbox"/> NO <input type="checkbox"/>	W/O No. <u>19270</u>
Utility Accounting <u>[Signature]</u>	Date <u>6/30/06</u>

VALID FOR SIX MONTHS FROM DATE OF ISSUANCE (Section 2.2.C.1 Grand Junction Zoning & Development Code)
 (White: Planning) (Yellow: Customer) (Pink: Building Department) (Goldenrod: Utility Accounting)

*drive SW noted
as 6/30/06*

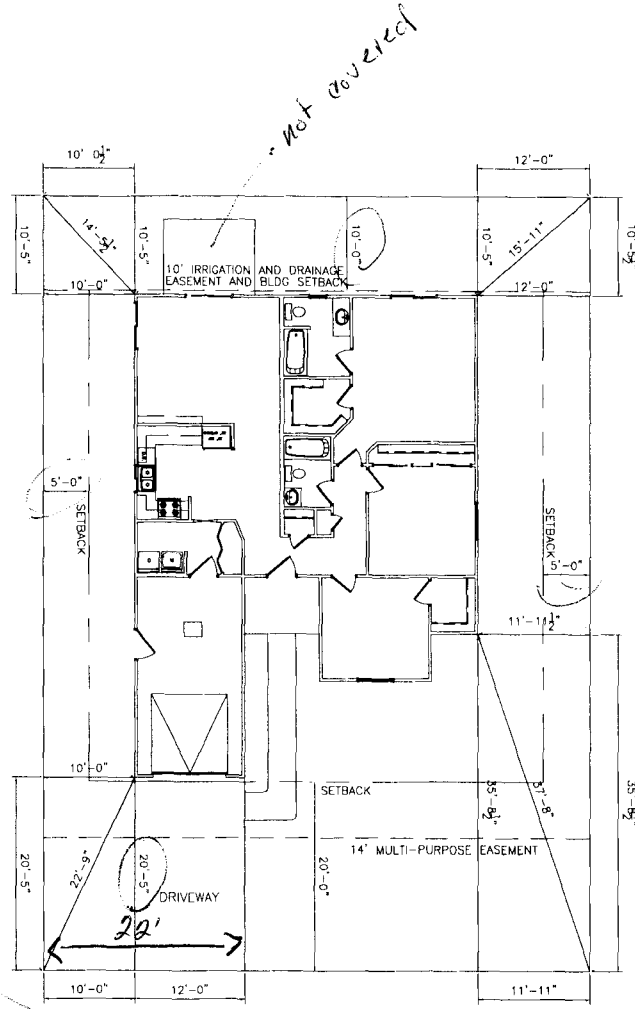

2828 So. Forest Ln

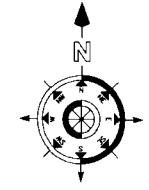

NOTE:
DIMENSION LINES ARE PULLED FROM
EDGE OF BRICK LEDGE. IF NO BRICK LEDGE
EXISTS, DIMENSIONS WILL BE FROM EDGE
OF FOUNDATION.

NOTICE:
1. IT IS THE RESPONSIBILITY OF THE BUILDER OR OWNER TO VERIFY ALL DETAILS
AND DIMENSIONS PRIOR TO CONSTRUCTION.
2. USE OF THIS PLAN CONSTITUTES BUILDER AND OR HOME OWNERS ACCEPTANCE OF THESE TERMS.
3. ALL DIMENSIONS ARE TO EDGE OF FOUNDATION UNLESS OTHER WISE NOTED.
4. BUILDER AND OR OWNER TO VERIFY ALL SETBACKS AND EASEMENTS.
5. THIS PLAN HAS NOT BEEN ENGINEERED BY AUTOCAD. SEE SEPARATE DRAWINGS BY OTHERS
FOR ENGINEERING DATA.

NOTE:
GRADE MUST SLOPE AWAY FROM HOUSE 6" OF FALL IN
THE FIRST 10' OF DISTANCE PER LOCAL BUILDING CODE.

NOTE:
BUILDER TO VERIFY
ALL SETBACK AND EASEMENT
ENCROACHMENTS PRIOR
TO CONSTRUCTION

SITE PLAN INFORMATION	
SUBDIVISION NAME	SUMMER GLEN
PLAN NAME	SYCAMORE
FILING NUMBER	1
LOT NUMBER	10
BLOCK NUMBER	4
STREET ADDRESS	2828 SOUTH FOREST LN.
COUNTY	MESA
GARAGE SQ. FT.	256
COVERED ENTRY SQ. FT.	48
COVERED PATIO SQ. FT.	N/A
LIVING SQ. FT.	1272
LOT SIZE	4844.8 SQ. FT.
SETBACKS USED	FRONT 20' SIDES 5' REAR 10'

SCALE: 1" = 20'-0"

SOUTH FOREST LANE

*4/6/06
4/30/06
BACKS MUST BE
PLANNING*

PROPERTY EASEMENTS
PROPERTY LINES