

FEE \$	10.00
TCP \$	1539.00
SIF \$	460.00

PLANNING CLEARANCE

(Single Family Residential and Accessory Structures)
Community Development Department

BLDG PERMIT NO. _____

Building Address 386 Kathleen Circle
 Parcel No. 2943-192-49-004
 Subdivision Summer Glen
 Filing _____ Block 4 Lot 4

No. of Existing Bldgs 0 No. Proposed 1
 Sq. Ft. of Existing Bldgs N/A Sq. Ft. Proposed 1379
 Sq. Ft. of Lot / Parcel 6401
 Sq. Ft. Coverage of Lot by Structures & Impervious Surface
 (Total Existing & Proposed) 1379
 Height of Proposed Structure _____

OWNER INFORMATION:

Name Datsco LLC
 Address 786 Valley Ct.
 City / State / Zip CO CO 81505

DESCRIPTION OF WORK & INTENDED USE:

New Single Family Home (*check type below)
 Interior Remodel Addition
 Other (please specify): _____

APPLICANT INFORMATION:

Name Grace Homes
 Address 786 Valley Ct.
 City / State / Zip CO CO 81505
 Telephone 748-8522

***TYPE OF HOME PROPOSED:**

Site Built Manufactured Home (UBC)
 Manufactured Home (HUD)
 Other (please specify): _____

NOTES: _____

REQUIRED: One plot plan, on 8 1/2" x 11" paper, showing all existing & proposed structure location(s), parking, setbacks to all property lines, ingress/egress to the property, driveway location & width & all easements & rights-of-way which abut the parcel.

THIS SECTION TO BE COMPLETED BY COMMUNITY DEVELOPMENT DEPARTMENT STAFF			
ZONE <u>RMF-8</u>		Maximum coverage of lot by structures <u>70%</u>	
SETBACKS: Front <u>20</u> from property line (PL)		Permanent Foundation Required: YES <u>X</u> NO _____	
Side <u>5</u> from PL Rear <u>10</u> from PL		Parking Requirement <u>2</u>	
Maximum Height of Structure(s) <u>35</u>		Special Conditions _____	
Voting District <u>E</u>	Driveway Location Approval <u>UK</u> <small>(Engineer's Initials)</small>		

Modifications to this Planning Clearance must be approved, in writing, by the Community Development Department. The structure authorized by this application cannot be occupied until a final inspection has been completed and a Certificate of Occupancy has been issued, if applicable, by the Building Department (Section 305, Uniform Building Code).

I hereby acknowledge that I have read this application and the information is correct; I agree to comply with any and all codes, ordinances, laws, regulations or restrictions which apply to the project. I understand that failure to comply shall result in legal action, which may include, but not necessarily be limited to non-use of the building(s).

Applicant Signature [Signature] Date 7/24/06
 Department Approval JAR [Signature] Date 8/27/06



Additional water and/or sewer tap fee(s) are required:	YES	NO	W/O No. <u>19598</u>
Utility Accounting <u>[Signature]</u>	Date <u>10/20/06</u>		

VALID FOR SIX MONTHS FROM DATE OF ISSUANCE (Section 2.2.C.1 Grand Junction Zoning & Development Code)
 (White: Planning) (Yellow: Customer) (Pink: Building Department) (Goldenrod: Utility Accounting)

KATHLEEN
CIRCLE

also top

drive drive

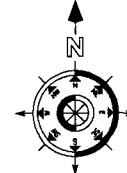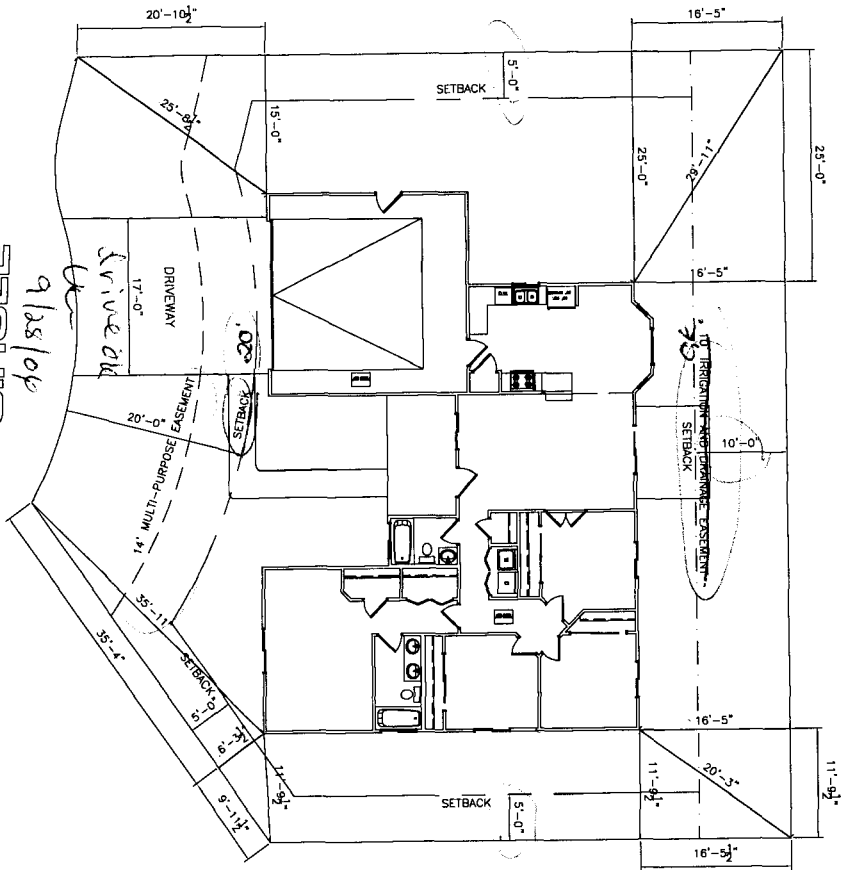

NOTE:
DIMENSION LINES ARE PULLED FROM
EDGE OF BRICK LEDGE. IF NO BRICK LEDGE
EXISTS, DIMENSIONS WILL BE FROM EDGE
OF FOUNDATION.

NOTE:
1. IT IS THE RESPONSIBILITY OF THE BUILDER OR OTHER TO VERIFY ALL DETAILS
AND DIMENSIONS PRIOR TO CONSTRUCTION.
2. USE OF THIS PLAN CONSTITUTES BUILDER AND OR HOME OWNERS ACCEPTANCE OF THESE TERMS.
3. ALL DIMENSIONS ARE TO EDGE OF FOUNDATION UNLESS OTHER WISE NOTED.
4. BUILDER AND OR OWNER TO VERIFY ALL SETBACKS AND ENCROACHMENTS.
5. THIS PLAN HAS NOT BEEN ENGINEERED BY AN ARCHITECT. SEE SEPARATE DRAWINGS BY OTHERS
FOR ENGINEERING DATA.

NOTE:
GRADE MUST SLOPE AWAY FROM HOUSE 6" OF FALL IN
THE FIRST 10' OF DISTANCE PER LOCAL BUILDING CODE.

NOTE:
BUILDER TO VERIFY
ALL SETBACK AND EASEMENT
ENCROACHMENTS PRIOR
TO CONSTRUCTION

SITE PLAN INFORMATION	
SUBDIVISION NAME	SUMMER GLEN
PLAN NAME	JUNIPER
FILING NUMBER	1
LOT NUMBER	4
BLOCK NUMBER	4
STREET ADDRESS	386 KATHLEEN CIRCLE
COUNTY	MESA
GARAGE SQ. FT.	479
COVERED ENTRY SQ. FT.	98
COVERED PATIO SQ. FT.	N/A
LIVING SQ. FT.	1379
LOT SIZE	6401.2 SQ. FT.
SETBACKS USED	FRONT 20'
	SIDES 5'
	REAR 10'

SCALE: 1" = 20'-0"

386 Kathleen Cir.

ACCEPTED JAR Gayleen Holden
SETBACKS MUST BE
CITY PLANNING
APPLICANTS
LOCAL TO VERIFY TO PROPERLY
AND IDENTIFY EASEMENTS
AND SETBACK LINES.