





# IMPROVEMENT LOCATION CERTIFICATE

2835 Margo Court, Grand Junction, Colorado 81501

Lot 6 in Block 2 of Summer Glen Subdivision, Mesa County, Colorado.

*RmFZ  
Setbacks  
Front 20  
Side 5  
Back 10*

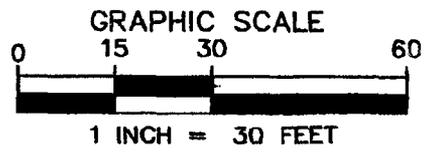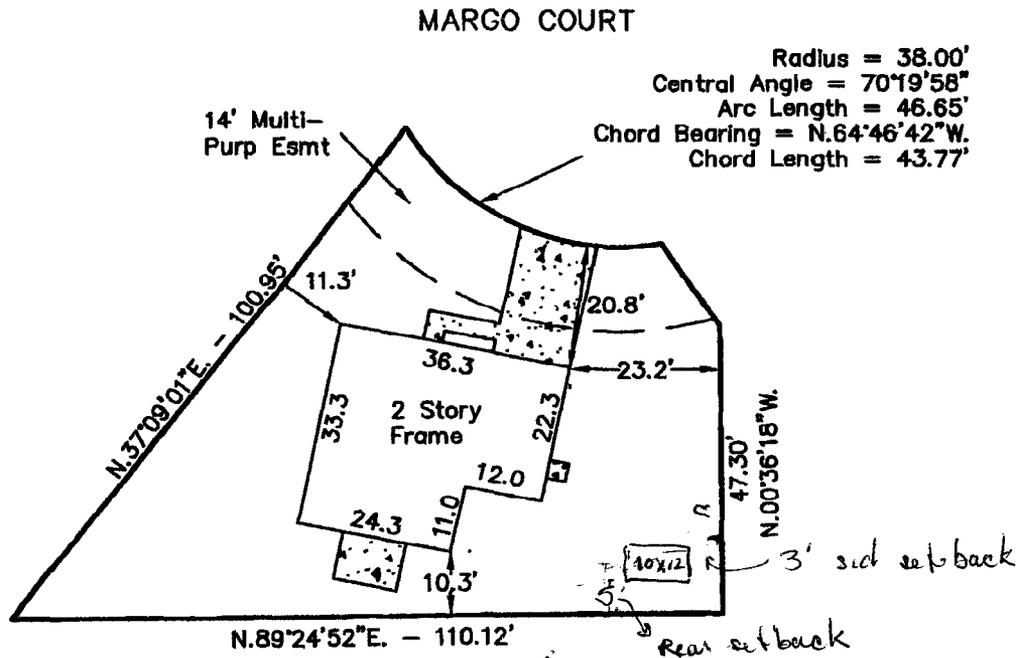

TITLE INFORMATION  
 PROVIDED BY:  
 Meridian Land Title  
 FILE NO 80815  
 BORROWER Buddecke

I HEREBY CERTIFY THAT THIS IMPROVEMENT LOCATION CERTIFICATE WAS PREPARED FOR Unifirst Mortgage, THAT THIS IS NOT A LAND SURVEY PLAT OR IMPROVEMENT SURVEY PLAT, AND THAT IT IS NOT TO BE RELIED UPON FOR THE ESTABLISHMENT OF FENCES, BUILDINGS, OR OTHER FUTURE IMPROVEMENTS LINES. I FURTHER CERTIFY THE IMPROVEMENTS ON THE ABOVE DESCRIBED PARCEL ON THIS DATE 08/07/06, EXCEPT UTILITY CONNECTIONS ARE ENTIRELY WITHIN THE BOUNDARIES OF THE PARCEL, EXCEPT AS SHOWN, THAT THERE ARE NO ENCROACHMENTS UPON THE DESCRIBED PREMISES BY IMPROVEMENTS OF ANY ADJOINING PREMISES, EXCEPT AS INDICATED, AND THAT THERE IS NO APPARENT EVIDENCE OR SIGN OF ANY EASEMENT CROSSING OR BURDENING ANY PART OF SAID PARCEL, EXCEPT AS NOTED.

*11-11-06*