

FEE \$ 10.00  
 TCP \$ 1539.00  
 SIF \$ 4100.00

**PLANNING CLEARANCE**  
 (Single Family Residential and Accessory Structures)  
**Community Development Department**

BLDG PERMIT NO. \_\_\_\_\_

Building Address 721 Metate  
 Parcel No. 2701-333-41-003  
 Subdivision Spanish Trail  
 Filing 4 Block 11 Lot 3

No. of Existing Bldgs 0 No. Proposed 1  
 Sq. Ft. of Existing Bldgs 0 Sq. Ft. Proposed 1978  
 Sq. Ft. of Lot / Parcel 5227<sup>±</sup>  
 Sq. Ft. Coverage of Lot by Structures & Impervious Surface  
 (Total Existing & Proposed) 1978  
 Height of Proposed Structure 15'

**OWNER INFORMATION:**

Name Hunter Construction + Development LLC  
 Address PO Box 55403  
 City / State / Zip Emel Jctn CO 81505

**DESCRIPTION OF WORK & INTENDED USE:**

New Single Family Home (\*check type below)  
 Interior Remodel  Addition  
 Other (please specify): \_\_\_\_\_

**APPLICANT INFORMATION:**

Name Same  
 Address \_\_\_\_\_  
 City / State / Zip \_\_\_\_\_  
 Telephone 241 5059

**\*TYPE OF HOME PROPOSED:**

Site Built  Manufactured Home (UBC)  
 Manufactured Home (HUD)  
 Other (please specify): \_\_\_\_\_

NOTES: \_\_\_\_\_

**REQUIRED: One plot plan, on 8 1/2" x 11" paper, showing all existing & proposed structure location(s), parking, setbacks to all property lines, ingress/egress to the property, driveway location & width & all easements & rights-of-way which abut the parcel.**

THIS SECTION TO BE COMPLETED BY COMMUNITY DEVELOPMENT DEPARTMENT STAFF			
ZONE <u>PD</u>	Maximum coverage of lot by structures <u>60%</u>		
SETBACKS: Front <u>15' house 20' garage from street</u> from property line (PL)	Permanent Foundation Required: YES <u>X</u> NO _____		
Side <u>5'</u> from PL Rear <u>10'</u> from PL	Parking Requirement <u>2</u>		
Maximum Height of Structure(s) <u>32'</u>	Special Conditions <u>Letter from</u>		
Voting District <u>B</u> Driveway Location Approval <u>im</u> (Engineer's Initials)	<u>licensed Engineer Required</u>		

Modifications to this Planning Clearance must be approved, in writing, by the Community Development Department. The structure authorized by this application cannot be occupied until a final inspection has been completed and a Certificate of Occupancy has been issued, if applicable, by the Building Department (Section 305, Uniform Building Code).


I hereby acknowledge that I have read this application and the information is correct; I agree to comply with any and all codes, ordinances, laws, regulations or restrictions which apply to the project. I understand that failure to comply shall result in legal action, which may include but not necessarily be limited to non-use of the building(s).

Applicant Signature [Signature] Date 2/15/04

Department Approval [Signature] Date 2/28/04

Additional water and/or sewer tap fee(s) are required	<input checked="" type="checkbox"/> YES	<input type="checkbox"/> NO	W/O No. <u>11869</u>
Utility Accounting <u>Katlelsberg</u>	Date <u>2/28/04</u>		

VALID FOR SIX MONTHS FROM DATE OF ISSUANCE (Section 2.2.C.1 Grand Junction Zoning & Development Code)  
 (White: Planning) (Yellow: Customer) (Pink: Building Department) (Goldenrod: Utility Accounting)

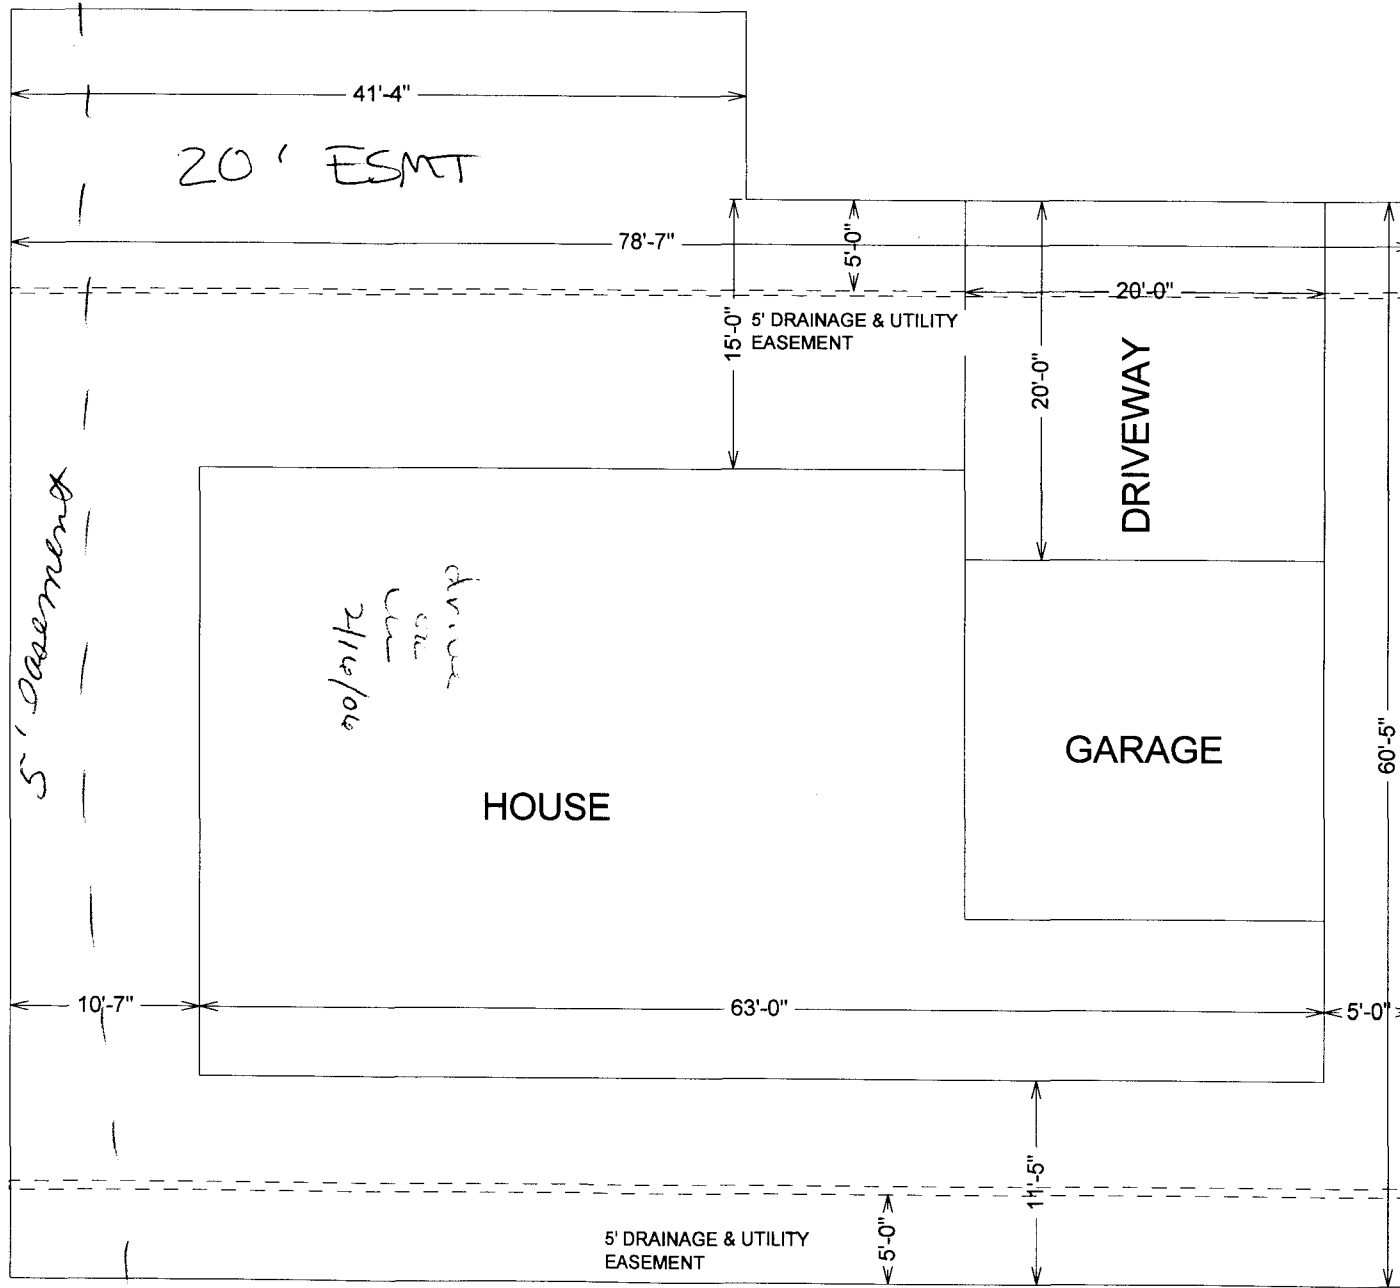

2/28/06  
 JH [Signature]

ACCEPTED  
 ANY CHANGE OF RECORDS MUST BE APPROVED BY THE CITY PLANNING DEPT. IT IS THE APPLICANT'S RESPONSIBILITY TO PROPERLY LOCATE AND IDENTIFY EASEMENTS AND PROPERTY LINES.

↑  
 NORTH

BLOCK 11  
 LOT 3  
 721 METATE COURT  
 SPANISH TRAILS SUB.

"The El Monte"