

FEE \$	10.00
TCP \$	1539.00
SIF \$	460.00

PLANNING CLEARANCE
(Single Family Residential and Accessory Structures)
Community Development Department

BLDG PERMIT NO. _____

Building Address 3027 Mohawk Ave No. of Existing Bldgs 0 No. Proposed 1
 Parcel No. 2943-162-92-003 Sq. Ft. of Existing Bldgs 0 Sq. Ft. Proposed 1404
 Subdivision Prairie View Sq. Ft. of Lot / Parcel 8364
 Filing 1 Block 2 Lot 3 Sq. Ft. Coverage of Lot by Structures & Impervious Surface (Total Existing & Proposed) 1404
 Height of Proposed Structure 13'

OWNER INFORMATION:

Name Koos TRÉ STAR LLC
 Address 600 White Ave
 City / State / Zip G.J., CO 81501

DESCRIPTION OF WORK & INTENDED USE:

New Single Family Home (*check type below)
 Interior Remodel Addition
 Other (please specify): _____

APPLICANT INFORMATION:

Name Koos Const. Inc
 Address 600 White Ave
 City / State / Zip G.J. CO 81501
 Telephone 242-8779

***TYPE OF HOME PROPOSED:**

Site Built Manufactured Home (UBC)
 Manufactured Home (HUD)
 Other (please specify): _____

NOTES: New Residence

REQUIRED: One plot plan, on 8 1/2" x 11" paper, showing all existing & proposed structure location(s), parking, setbacks to all property lines, ingress/egress to the property, driveway location & width & all easements & rights-of-way which abut the parcel.

THIS SECTION TO BE COMPLETED BY COMMUNITY DEVELOPMENT DEPARTMENT STAFF	
ZONE <u>Rmf-5</u>	Maximum coverage of lot by structures <u>60%</u>
SETBACKS: Front <u>20'</u> from property line (PL)	Permanent Foundation Required: YES <input checked="" type="checkbox"/> NO <input type="checkbox"/>
Side <u>5'</u> from PL Rear <u>25'</u> from PL	Parking Requirement <u>2</u>
Maximum Height of Structure(s) <u>35'</u>	Special Conditions _____
Voting District <u>C</u> Driveway Location Approval <u>[Signature]</u> (Engineer's Initials)	

Modifications to this Planning Clearance must be approved, in writing, by the Community Development Department. The structure authorized by this application cannot be occupied until a final inspection has been completed and a Certificate of Occupancy has been issued, if applicable, by the Building Department (Section 305, Uniform Building Code).

I hereby acknowledge that I have read this application and the information is correct; I agree to comply with any and all codes, ordinances, laws, regulations or restrictions which apply to the project. I understand that failure to comply shall result in legal action, which may include but not necessarily be limited to non-use of the building(s).

Applicant Signature [Signature] Date 4-3-06



Department Approval [Signature] Date 4-11-06

Additional water and/or sewer tap fee(s) are required: YES NO W/O No. 19011

Utility Accounting [Signature] Date 4/11/06

VALID FOR SIX MONTHS FROM DATE OF ISSUANCE (Section 2.2.C.1 Grand Junction Zoning & Development Code)
 (White: Planning) (Yellow: Customer) (Pink: Building Department) (Goldenrod: Utility Accounting)

3027 MOHAWK AVENUE

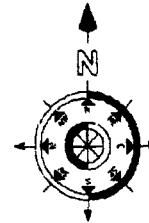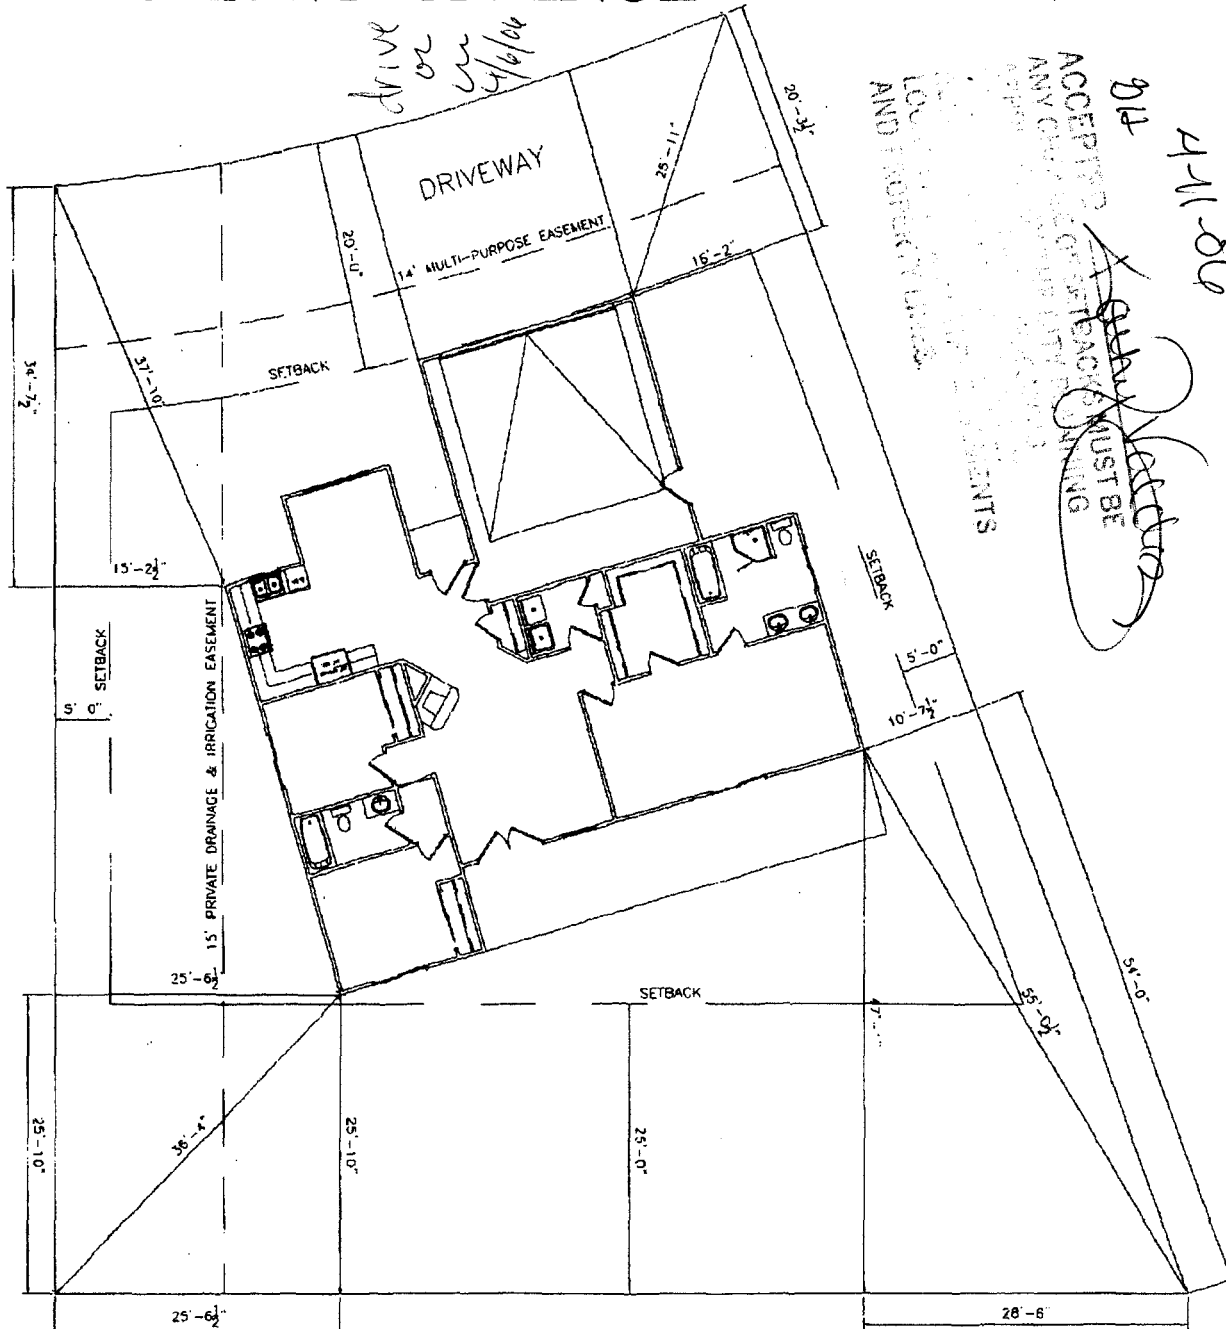

NOTES:

- IT IS THE RESPONSIBILITY OF THE BUILDER OR OWNER TO VERIFY ALL DETAILS AND DIMENSIONS PRIOR TO CONSTRUCTION.
- USE OF THIS PLAN CONSTITUTES WAIVER AND OR HOME OWNERS ACCEPTANCE OF THESE TERMS.
- ALL DIMENSIONS ARE TO EDGE OF FOUNDATION UNLESS OTHER WISE NOTED.
- BUILDER AND OR OWNER TO VERIFY ALL SETBACKS AND EASEMENTS.
- THIS PLAN HAS NOT BEEN ENGINEERED BY ANYONE. SEE SEPARATE DRAWINGS BY OTHERS FOR ENGINEERING DATA.

NOTE:
GRADE MUST SLOPE AWAY FROM HOUSE 6" OF FALL IN THE FIRST 10' OF DISTANCE PER LOCAL BUILDING CODE.

NOTE:
DIMENSION LINES ARE PULLED FROM EDGE OF BRICK LEDGE. IF NO BRICK LEDGE EXISTS, DIMENSIONS WILL BE FROM EDGE OF FOUNDATION.

NOTE:
BUILDER TO VERIFY ALL SETBACK AND EASEMENT ENCROACHMENTS PRIOR TO CONSTRUCTION

SITE PLAN INFORMATION	
SUBDIVISION NAME	PRIARIE VIEW
FILING NUMBER	1
LOT NUMBER	3
BLOCK NUMBER	2
STREET ADDRESS	3027 MOHAWK AVE.
COUNTY	MESA
GARAGE SQ. FT.	439.00 S.F.
COVERED ENTRY SQ. FT.	20.00 S.F.
LIVING SQ. FT.	1404.00
LOT SIZE	8364.00 S.F.
SETBACKS USED	FRONT 20'
	SIDES 5' & 15'
	REAR 25'

2:\CAD DWGS\ALL PLATS\PRIARIE VIEW\PRIARIE VIEW 7.dwg, 04/03/2006 11:11:26 AM, shawn
HP LaserJet 1100 (MS).pc3

SCALE: 1/16" = 1'-0"