

FEE \$:	10.00
TCP \$	1539.00
SIF \$	460.00

PLANNING CLEARANCE
 (Single Family Residential and Accessory Structures)
Community Development Department

BLDG PERMIT NO. _____

Building Address 636 Mount Julian
 Parcel No. 2945-053-83-012
 Subdivision Forrest Run
 Filing 1 Block 1 Lot 12

No. of Existing Bldgs 0 No. Proposed 1
 Sq. Ft. of Existing Bldgs 0 Sq. Ft. Proposed 1997
 Sq. Ft. of Lot / Parcel 9204
 Sq. Ft. Coverage of Lot by Structures & Impervious Surface (Total Existing & Proposed) _____
 Height of Proposed Structure _____

OWNER INFORMATION:

Name Melanie Hoch
 Address 702 Silverplume Dr.
 City / State / Zip Fruita CO 81521

DESCRIPTION OF WORK & INTENDED USE:

New Single Family Home (*check type below)
 Interior Remodel Addition
 Other (please specify): _____

APPLICANT INFORMATION:

Name owner
 Address _____
 City / State / Zip _____
 Telephone _____

***TYPE OF HOME PROPOSED:**

Site Built Manufactured Home (UBC)
 Manufactured Home (HUD)
 Other (please specify): _____

NOTES: _____

REQUIRED: One plot plan, on 8 1/2" x 11" paper, showing all existing & proposed structure location(s), parking, setbacks to all property lines, ingress/egress to the property, driveway location & width & all easements & rights-of-way which abut the parcel.

THIS SECTION TO BE COMPLETED BY COMMUNITY DEVELOPMENT DEPARTMENT STAFF	
ZONE <u>RMF-5</u>	Maximum coverage of lot by structures <u>60%</u>
SETBACKS: Front <u>20</u> from property line (PL)	Permanent Foundation Required: YES <input checked="" type="checkbox"/> NO <input type="checkbox"/>
Side <u>5</u> from PL Rear <u>25</u> from PL	Parking Requirement <u>2</u>
Maximum Height of Structure(s) <u>35</u>	Special Conditions _____
Voting District <u>"D"</u> Driveway Location Approval <u>ML</u> (Engineer's Initials)	_____

Modifications to this Planning Clearance must be approved, in writing, by the Community Development Department. The structure authorized by this application cannot be occupied until a final inspection has been completed and a Certificate of Occupancy has been issued, if applicable, by the Building Department (Section 305, Uniform Building Code).

I hereby acknowledge that I have read this application and the information is correct; I agree to comply with any and all codes, ordinances, laws, regulations or restrictions which apply to the project. I understand that failure to comply shall result in legal action, which may include but not necessarily be limited to non-use of the building(s).

Applicant Signature Melanie D Hoch Date 6-20-06
 Department Approval JR Ashby Date 6/21/06 7/7/06

Additional water and/or sewer tap fee(s) are required:	YES	NO	W/O No. <u>19280</u>
Utility Accounting <u>0</u>	Date <u>7/7/04</u>		

VALID FOR SIX MONTHS FROM DATE OF ISSUANCE (Section 2.2.C.1 Grand Junction Zoning & Development Code)
 (White: Planning) (Yellow: Customer) (Pink: Building Department) (Goldenrod: Utility Accounting)


ACCEPTED *Y. Hsu* *7/7/06*
 ANY CHANGE OF SETBACKS MUST BE APPROVED BY THE CITY PLANNING DEPARTMENT. THE APPLICANT'S RESPONSIBILITY TO PROPERLY LOCATE AND IDENTIFY EASEMENTS AND PROPERTY LINES.

NOTICE:
 1. IT IS THE RESPONSIBILITY OF THE BUILDER OR OWNER TO VERIFY ALL DETAILS AND DIMENSIONS PRIOR TO CONSTRUCTION.
 2. USE OF THIS PLAN CONSTITUTES BUILDER AND OR HOME OWNERS ACCEPTANCE OF THESE TERMS.
 3. ALL DIMENSIONS ARE TO EDGE OF FOUNDATION UNLESS OTHERWISE NOTED.
 4. BUILDER AND OR OWNER TO VERIFY ALL SETBACKS AND EASEMENTS.
 5. THIS PLAN HAS NOT BEEN ENGINEERED BY AUTODRAFT. SEE SEPARATE DRAWINGS BY OTHERS FOR ENGINEERING DATA.

NOTE:
 GRADE MUST SLOPE AWAY FROM HOUSE 6" OF FALL IN THE FIRST 10' OF DISTANCE PER LOCAL BUILDING CODE.

NOTE:
 BUILDER TO VERIFY ALL SETBACK AND EASEMENT ENCROACHMENTS PRIOR TO CONSTRUCTION


NOTE:
 DIMENSION LINES ARE PULLED FROM EDGE OF BRICK LEDGE. IF NO BRICK LEDGE EXISTS, DIMENSIONS WILL BE FROM EDGE OF FOUNDATION.

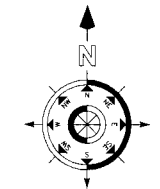

SITE PLAN INFORMATION	
SUBDIVISION NAME	FORREST RUN SUBDIVISION
FILING NUMBER	1
LOT NUMBER	12
STREET ADDRESS	637 MOUNT JULIAN DR.
COUNTY	MESA
GARAGE SQ. FT.	663 SF
LIVING SQ. FT.	1997 SF
LOT SIZE	9204 SF
SETBACKS USED	FRONT 20' SIDES 5' REAR 25'

636

MOUNT JULIAN DR.

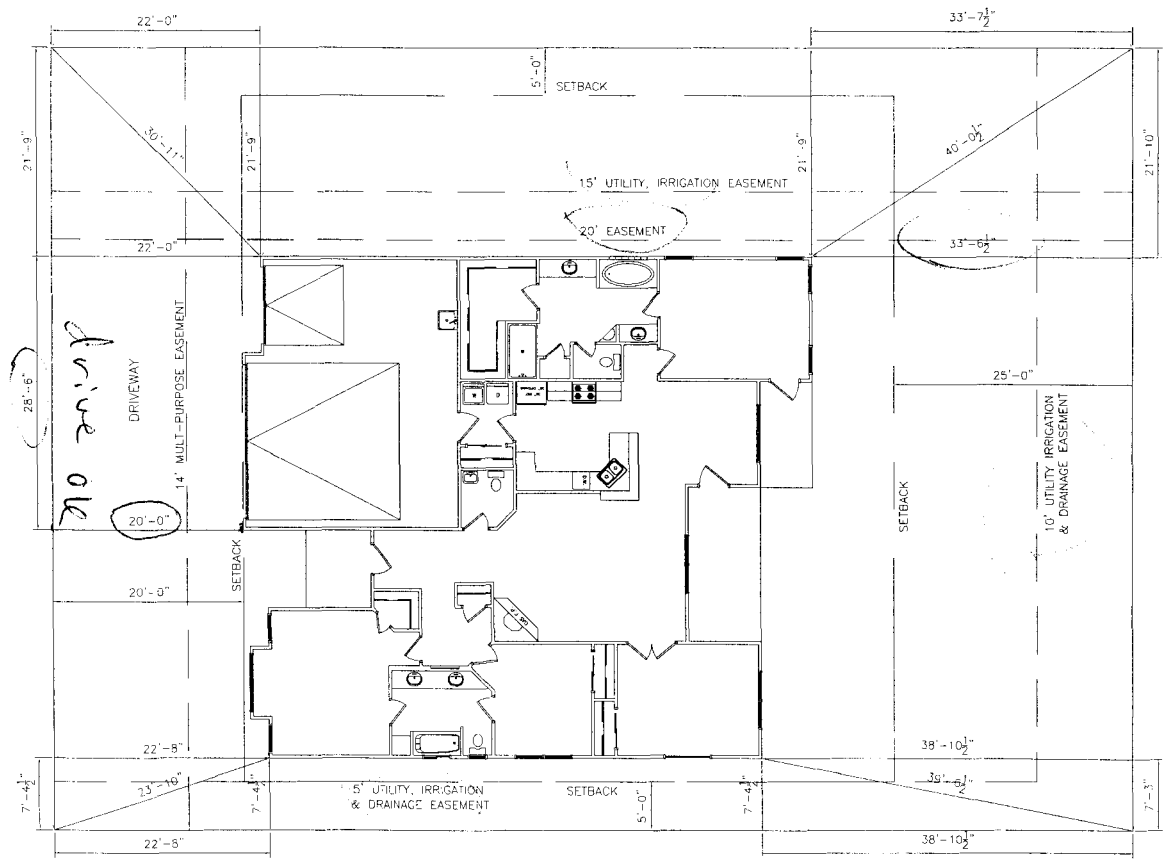

SCALE: 1"=20'

6/23/04
WR