

FEE \$	10.00
TCP \$	1539.00
SIF \$	460.00

# PLANNING CLEARANCE

(Single Family Residential and Accessory Structures)

Community Development Department

BLDG PERMIT NO. \_\_\_\_\_

Building Address 626 1/2 Mount Julian  
 Parcel No. 2945-053-83-004  
 Subdivision Forrest Run  
 Filing 2 Block 1 Lot 4

No. of Existing Bldgs 0 No. Proposed 1  
 Sq. Ft. of Existing Bldgs — Sq. Ft. Proposed 1820  
 Sq. Ft. of Lot / Parcel 6717  
 Sq. Ft. Coverage of Lot by Structures & Impervious Surface (Total Existing & Proposed) \_\_\_\_\_  
 Height of Proposed Structure \_\_\_\_\_

**OWNER INFORMATION:**

Name ~~Infinity Builders~~ Snow River  
 Address 202 North Avenue #164  
 City / State / Zip Grand Jct. CO 81501

**DESCRIPTION OF WORK & INTENDED USE:**

New Single Family Home (\*check type below)  
 Interior Remodel  Addition  
 Other (please specify): \_\_\_\_\_

**APPLICANT INFORMATION:**

Name ~~Infinity Builders~~ Snow River  
 Address 202 North Avenue #164  
 City / State / Zip Grand Jct. CO 81501  
 Telephone 248-9708

**\*TYPE OF HOME PROPOSED:**

Site Built  Manufactured Home (UBC)  
 Manufactured Home (HUD)  
 Other (please specify): \_\_\_\_\_

NOTES: \_\_\_\_\_

**REQUIRED: One plot plan, on 8 1/2" x 11" paper, showing all existing & proposed structure location(s), parking, setbacks to all property lines, ingress/egress to the property, driveway location & width & all easements & rights-of-way which abut the parcel.**

THIS SECTION TO BE COMPLETED BY COMMUNITY DEVELOPMENT DEPARTMENT STAFF	
ZONE <u>RMF-5</u>	Maximum coverage of lot by structures <u>60%</u>
SETBACKS: Front <u>20'</u> from property line (PL)	Permanent Foundation Required: YES <input checked="" type="checkbox"/> NO <input type="checkbox"/>
Side <u>5'</u> from PL Rear <u>25'</u> from PL	Parking Requirement <u>2</u>
Maximum Height of Structure(s) <u>35'</u>	Special Conditions _____
Voting District <u>D</u> Driveway Location Approval <u>WL</u> (Engineer's Initials)	_____

Modifications to this Planning Clearance must be approved, in writing, by the Community Development Department. The structure authorized by this application cannot be occupied until a final inspection has been completed and a Certificate of Occupancy has been issued, if applicable, by the Building Department (Section 305, Uniform Building Code).

I hereby acknowledge that I have read this application and the information is correct; I agree to comply with any and all codes, ordinances, laws, regulations or restrictions which apply to the project. I understand that failure to comply shall result in legal action, which may include but not necessarily be limited to non-use of the building(s).

Applicant Signature Melanie D'Hoja Date 6-20-06  
 Department Approval Adam Olse Date 5-11-06 6/20/06

Additional water and/or sewer tap fee(s) are required:	YES	NO	W/O No.
Utility Accounting	Date		


VALID FOR SIX MONTHS FROM DATE OF ISSUANCE (Section 2.2.C.1 Grand Junction Zoning & Development Code)  
 (White: Planning) (Yellow: Customer) (Pink: Building Department) (Goldenrod: Utility Accounting)

NOTE:  
DIMENSION LINES ARE PULLED FROM  
EDGE OF BRICK LEDGE IF NO BRICK LEDGE  
EXISTS, DIMENSIONS WILL BE FROM EDGE  
OF FOUNDATION.

NOTE:  
BUILDER TO VERIFY  
ALL SETBACK AND EASEMENT  
ENCROACHMENTS PRIOR  
TO CONSTRUCTION

NOTE:  
GRADE MUST SLOPE AWAY FROM HOUSE 2" OF FALL IN  
THE FIRST 10' OF DISTANCE PER LOCAL BUILDING CODE.

NOTICE:  
1. IT IS THE RESPONSIBILITY OF THE BUILDER OR OWNER TO VERIFY ALL DETAILS  
AND DIMENSIONS PRIOR TO CONSTRUCTION.  
2. USE OF THIS PLAN CONSTITUTES BUILDER AND OR HOME OWNERS ACCEPTANCE OF THESE TERMS.  
3. ALL DIMENSIONS ARE TO EDGE OF FOUNDATION UNLESS OTHER WISE NOTED.  
4. BUILDER AND OR OWNER TO VERIFY ALL SETBACKS AND EASEMENTS.  
5. THIS PLAN HAS NOT BEEN ENGINEERED BY AUTODRAFT. SEE SEPARATE DRAWINGS BY OTHERS  
FOR ENGINEERING DATA.

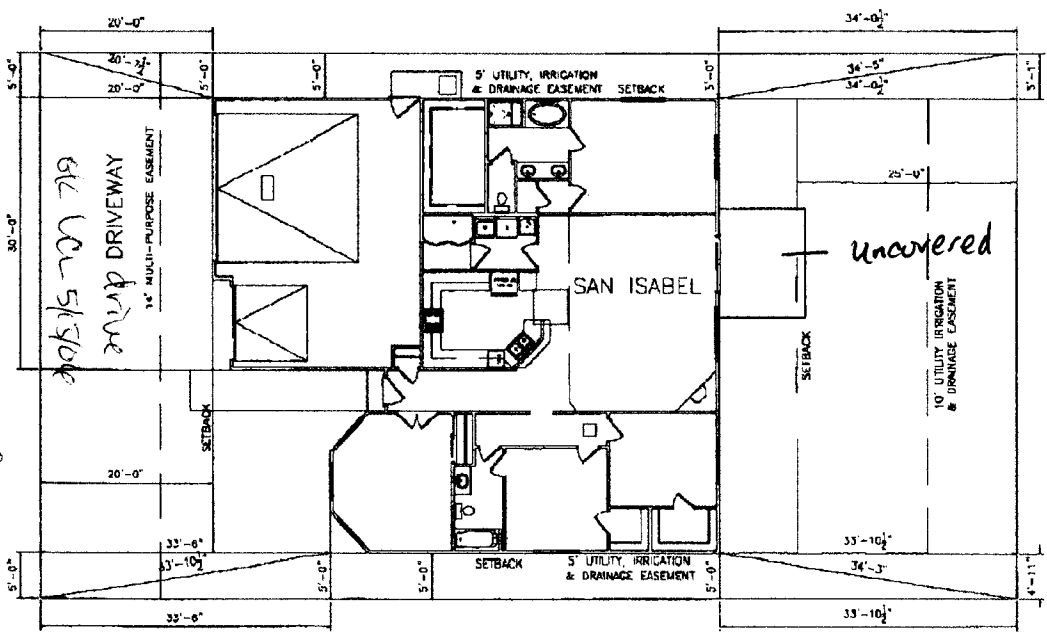

SCALE: 1"=20'

SITE PLAN INFORMATION	
SUBDIVISION NAME	FORREST RUN SUBDIVISION
PLING NUMBER	1
LOT NUMBER	4
STREET ADDRESS	? MT. JULIAN DR.
COUNTY	MESA
GARAGE SQ. FT.	731 SF
LIVING SQ. FT.	1820 SF
LOT SIZE	6717 SF
SETBACKS USED	FRONT 20'
	SIDES 5'
	REAR 25'

ACCEPTED  
NA  
DR. NATHAN J. ANTON  
5-11-06  
\$2900  
OK  
LOCAL REGULATORY REQUIREMENTS  
AND PROJECT INFORMATION

THIS DRAWING IS UNLESS OTHERWISE SPECIFIED TO BE IN ACCORDANCE WITH THE 2000 INTERNATIONAL RESIDENTIAL CODE