

FEE \$	10.00
TCP \$	1539.00
SIF \$	400.00

PLANNING CLEARANCE

(Single Family Residential and Accessory Structures)
Community Development Department

BLDG PERMIT NO.

Building Address 2164 PEREGRINE CT No. of Existing Bldgs 0 No. Proposed 1
 Parcel No. 2949-262-34-02 Sq. Ft. of Existing Bldgs 0 Sq. Ft. Proposed 3300
 Subdivision PEREGRINE ESTATE Sq. Ft. of Lot / Parcel 3542
 Filing _____ Block _____ Lot _____
 Sq. Ft. Coverage of Lot by Structures & Impervious Surface (Total Existing & Proposed) 41800
 Height of Proposed Structure 22-64

OWNER INFORMATION:

Name LEO LANDRY
 Address 2164 PEREGRINE CT
 City / State / Zip GRAND JCT CO

DESCRIPTION OF WORK & INTENDED USE:

- New Single Family Home (*check type below)
- Interior Remodel Addition
- Other (please specify): _____

APPLICANT INFORMATION:

Name PRVETT HOMES LLLC
 Address 3310 C RD
 City / State / Zip PALISADE, CO 81526
 Telephone 434-1862

***TYPE OF HOME PROPOSED:**

- Site Built Manufactured Home (UBC)
- Manufactured Home (HUD)
- Other (please specify): NEW HOME

NOTES: _____

REQUIRED: One plot plan, on 8 1/2" x 11" paper, showing all existing & proposed structure location(s), parking, setbacks to all property lines, ingress/egress to the property, driveway location & width & all easements & rights-of-way which abut the parcel.

THIS SECTION TO BE COMPLETED BY COMMUNITY DEVELOPMENT DEPARTMENT STAFF			
ZONE <u>RSF-2</u>		Maximum coverage of lot by structures <u>30%</u>	
SETBACKS: Front <u>20'</u> from property line (PL)		Permanent Foundation Required: YES <input checked="" type="checkbox"/> NO <input type="checkbox"/>	
Side <u>15'</u> from PL Rear <u>30'</u> from PL		Parking Requirement <u>2</u>	
Maximum Height of Structure(s) <u>35'</u>		Special Conditions _____	
Voting District <u>A</u>	Driveway Location Approval <u>as noted</u> (Engineer's Initials)		

Modifications to this Planning Clearance must be approved, in writing, by the Community Development Department. The structure authorized by this application cannot be occupied until a final inspection has been completed and a Certificate of Occupancy has been issued, if applicable, by the Building Department (Section 305, Uniform Building Code).

I hereby acknowledge that I have read this application and the information is correct; I agree to comply with any and all codes, ordinances, laws, regulations or restrictions which apply to the project. I understand that failure to comply shall result in legal action, which may include but not necessarily be limited to non-use of the building(s).


Applicant Signature M. Brumby Date 7/27/06
 Department Approval NA Judith A. P... Date 7/31/06 8/25/06

Additional water and/or sewer tap fee(s) are required:	YES <input checked="" type="checkbox"/>	NO <input type="checkbox"/>	W/O No. <u>19416</u>
Utility Accounting <u>[Signature]</u>	Date <u>8/25/06</u>		

VALID FOR SIX MONTHS FROM DATE OF ISSUANCE (Section 2.2.C.1 Grand Junction Zoning & Development Code)
 (White: Planning) (Yellow: Customer) (Pink: Building Department) (Goldenrod: Utility Accounting)

2164 PEREGRINE CT
 294-262-34-020
 drive or as noted
 CA
 7/28/04

8/25/04

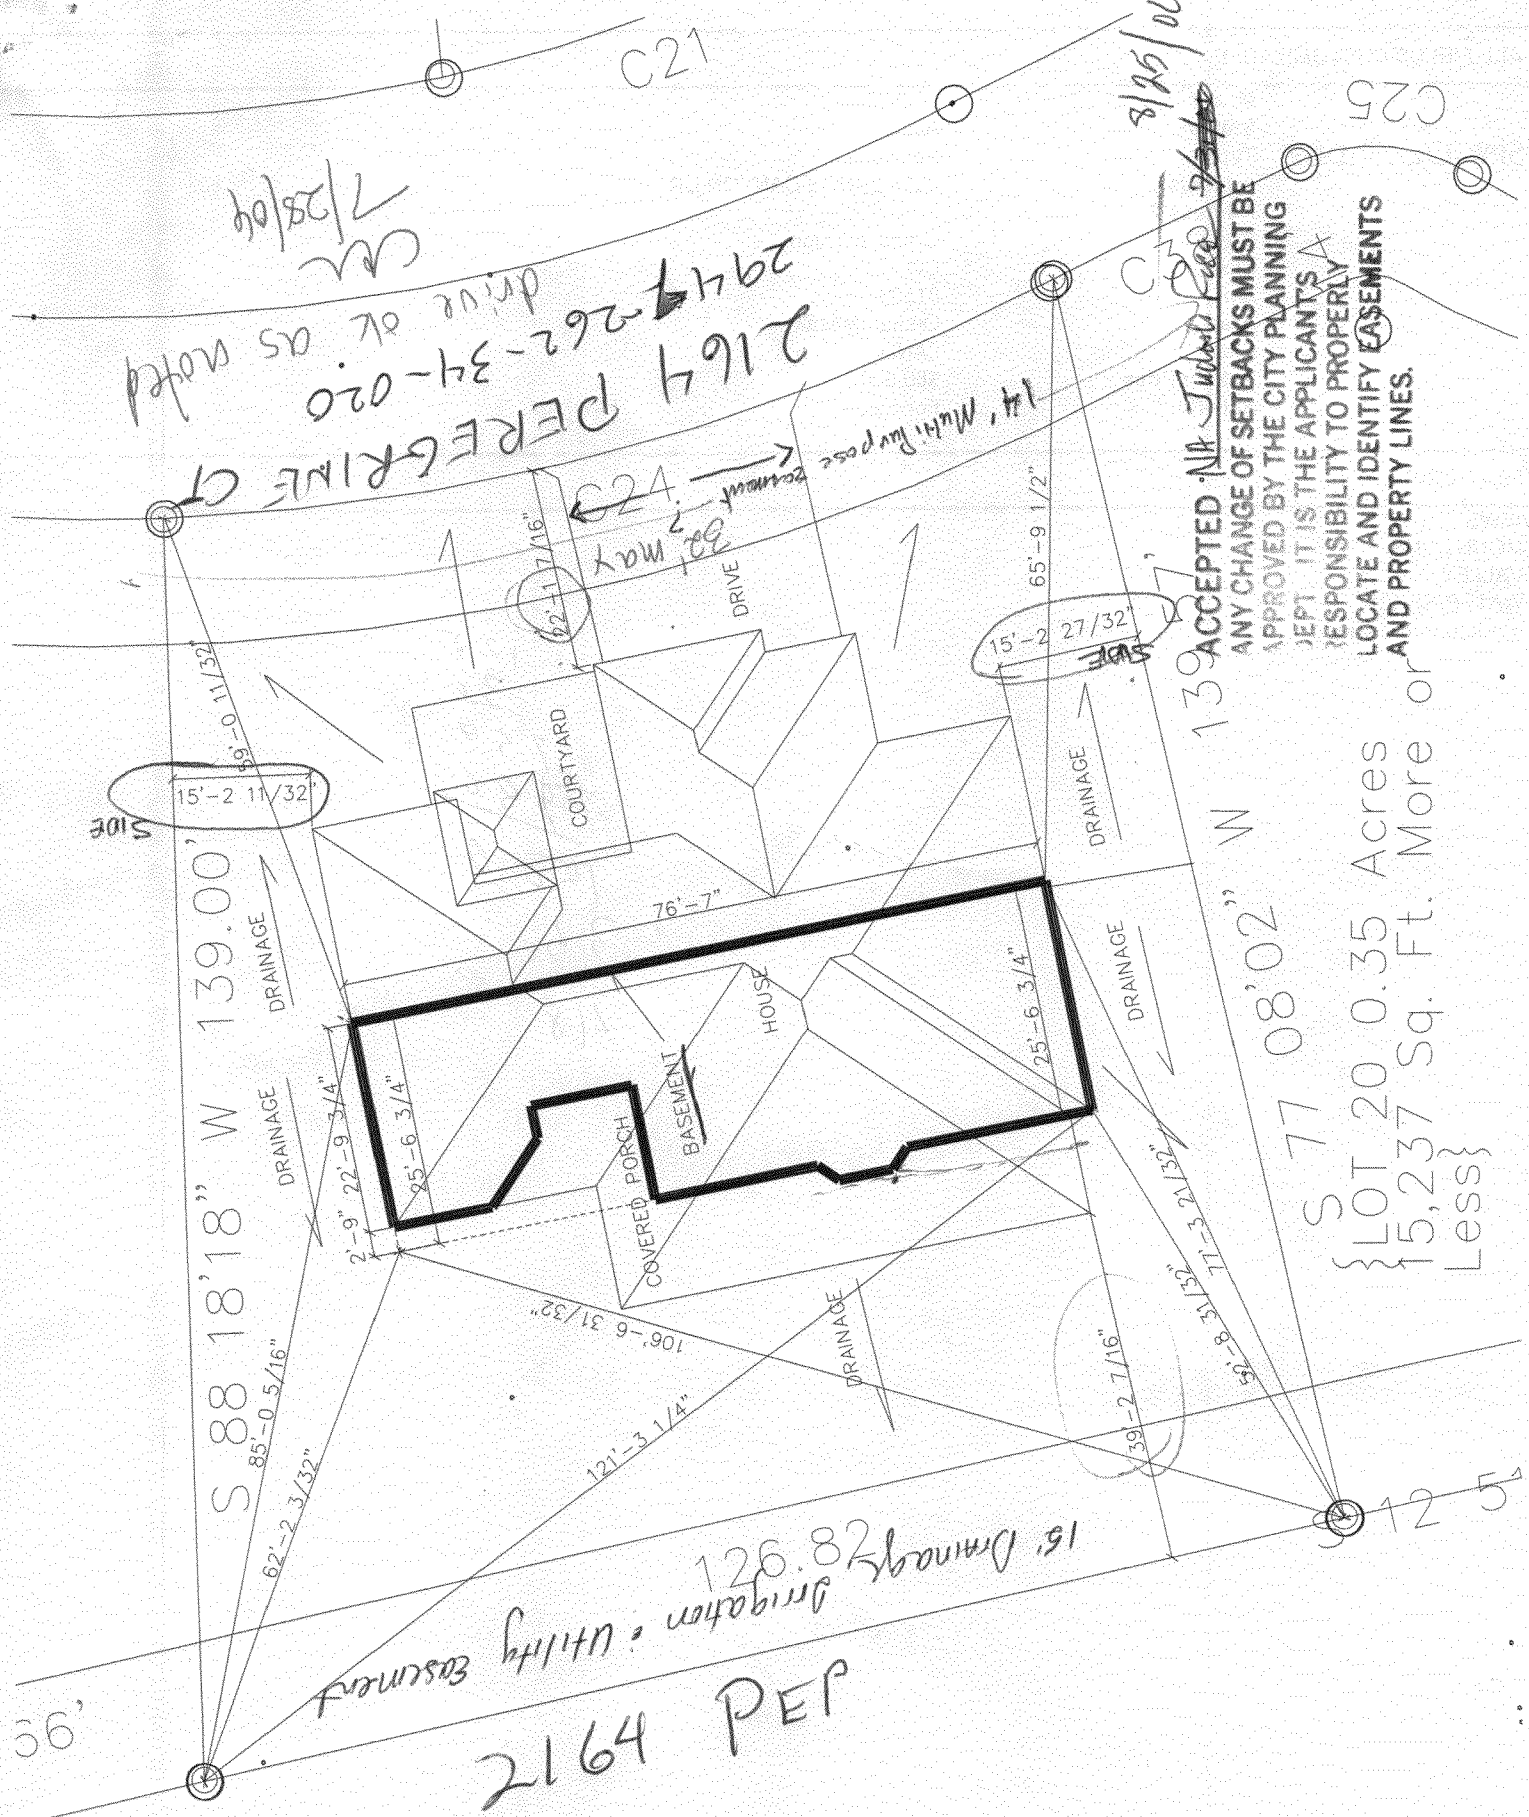

ACCEPTED NA
 ANY CHANGE OF SETBACKS MUST BE APPROVED BY THE CITY PLANNING DEPT. IT IS THE APPLICANTS RESPONSIBILITY TO PROPERLY LOCATE AND IDENTIFY EASEMENTS AND PROPERTY LINES.

139
 S 77 08'02" W
 { LOT 20 0.35 Acres
 { 15,237 Sq. Ft. More or
 Less }

15' Drainage
 28.92
 Irrigation = Utility Easement

2164 PEP

C21

C25

C25

SIDE

36'