

FEE \$ 10.00
 TCP \$ 1539.00
 SIF \$ 460.00

PLANNING CLEARANCE
 (Single Family Residential and Accessory Structures)
Community Development Department

BLDG PERMIT NO. _____

Building Address 625 SNEEDON PLACE No. of Existing Bldgs 0 No. Proposed 1
 Parcel No. 2943-053-77-044 Sq. Ft. of Existing Bldgs 0 Sq. Ft. Proposed 1926
 Subdivision FORREST ESTATES Sq. Ft. of Lot / Parcel 7280
 Filing 1 Block 1 Lot _____
 Sq. Ft. Coverage of Lot by Structures & Impervious Surface (Total Existing & Proposed) 3400
 Height of Proposed Structure 20'

OWNER INFORMATION:

Name MAX F. SNEEDON
 Address 2452 HOME RANCH CT.
 City / State / Zip G.T / CO / 81005

DESCRIPTION OF WORK & INTENDED USE:

New Single Family Home (*check type below)
 Interior Remodel Addition
 Other (please specify): _____

APPLICANT INFORMATION:

Name SNEEDON CONSTRUCTION INC.
 Address CC 21
 City / State / Zip " "
 Telephone 970-201-9098

***TYPE OF HOME PROPOSED:**

Site Built Manufactured Home (UBC)
 Manufactured Home (HUD)
 Other (please specify): _____

NOTES: _____

REQUIRED: One plot plan, on 8 1/2" x 11" paper, showing all existing & proposed structure location(s), parking, setbacks to all property lines, ingress/egress to the property, driveway location & width & all easements & rights-of-way which abut the parcel.

THIS SECTION TO BE COMPLETED BY COMMUNITY DEVELOPMENT DEPARTMENT STAFF	
ZONE <u>RMF-5</u>	Maximum coverage of lot by structures <u>60%</u>
SETBACKS: Front <u>20'</u> from property line (PL)	Permanent Foundation Required: YES <input checked="" type="checkbox"/> NO <input type="checkbox"/>
Side <u>5'</u> from PL Rear <u>25'</u> from PL	Parking Requirement <u>2</u>
Maximum Height of Structure(s) <u>35'</u>	Special Conditions _____
Voting District <u>D</u>	Driveway Location Approval <u>[Signature]</u> (Engineer's Initials)

Modifications to this Planning Clearance must be approved, in writing, by the Community Development Department. The structure authorized by this application cannot be occupied until a final inspection has been completed and a Certificate of Occupancy has been issued, if applicable, by the Building Department (Section 305, Uniform Building Code).

I hereby acknowledge that I have read this application and the information is correct; I agree to comply with any and all codes, ordinances, laws, regulations or restrictions which apply to the project. I understand that failure to comply shall result in legal action, which may include but not necessarily be limited to non-use of the building(s).


Applicant Signature [Signature] Date 2-5-06
 Department Approval [Signature] Date 2/27/06

Additional water and/or sewer tap fee(s) are required: YES <input checked="" type="checkbox"/> NO <input type="checkbox"/> W/O No.
Utility Accounting <u>[Signature]</u> Date <u>1/8/06</u>

VALID FOR SIX MONTHS FROM DATE OF ISSUANCE (Section 2.2.C.1 Grand Junction Zoning & Development Code)
 (White: Planning) (Yellow: Customer) (Pink: Building Department) (Goldenrod: Utility Accounting)

625 SNEDDON PLACE / LOT 44 - DOUGLAS - 2 CAR -

SITE / PLOT PLAN - DOUGLAS MODEL - FORREST ESTATES SUBDIVISION - 20 SCALE

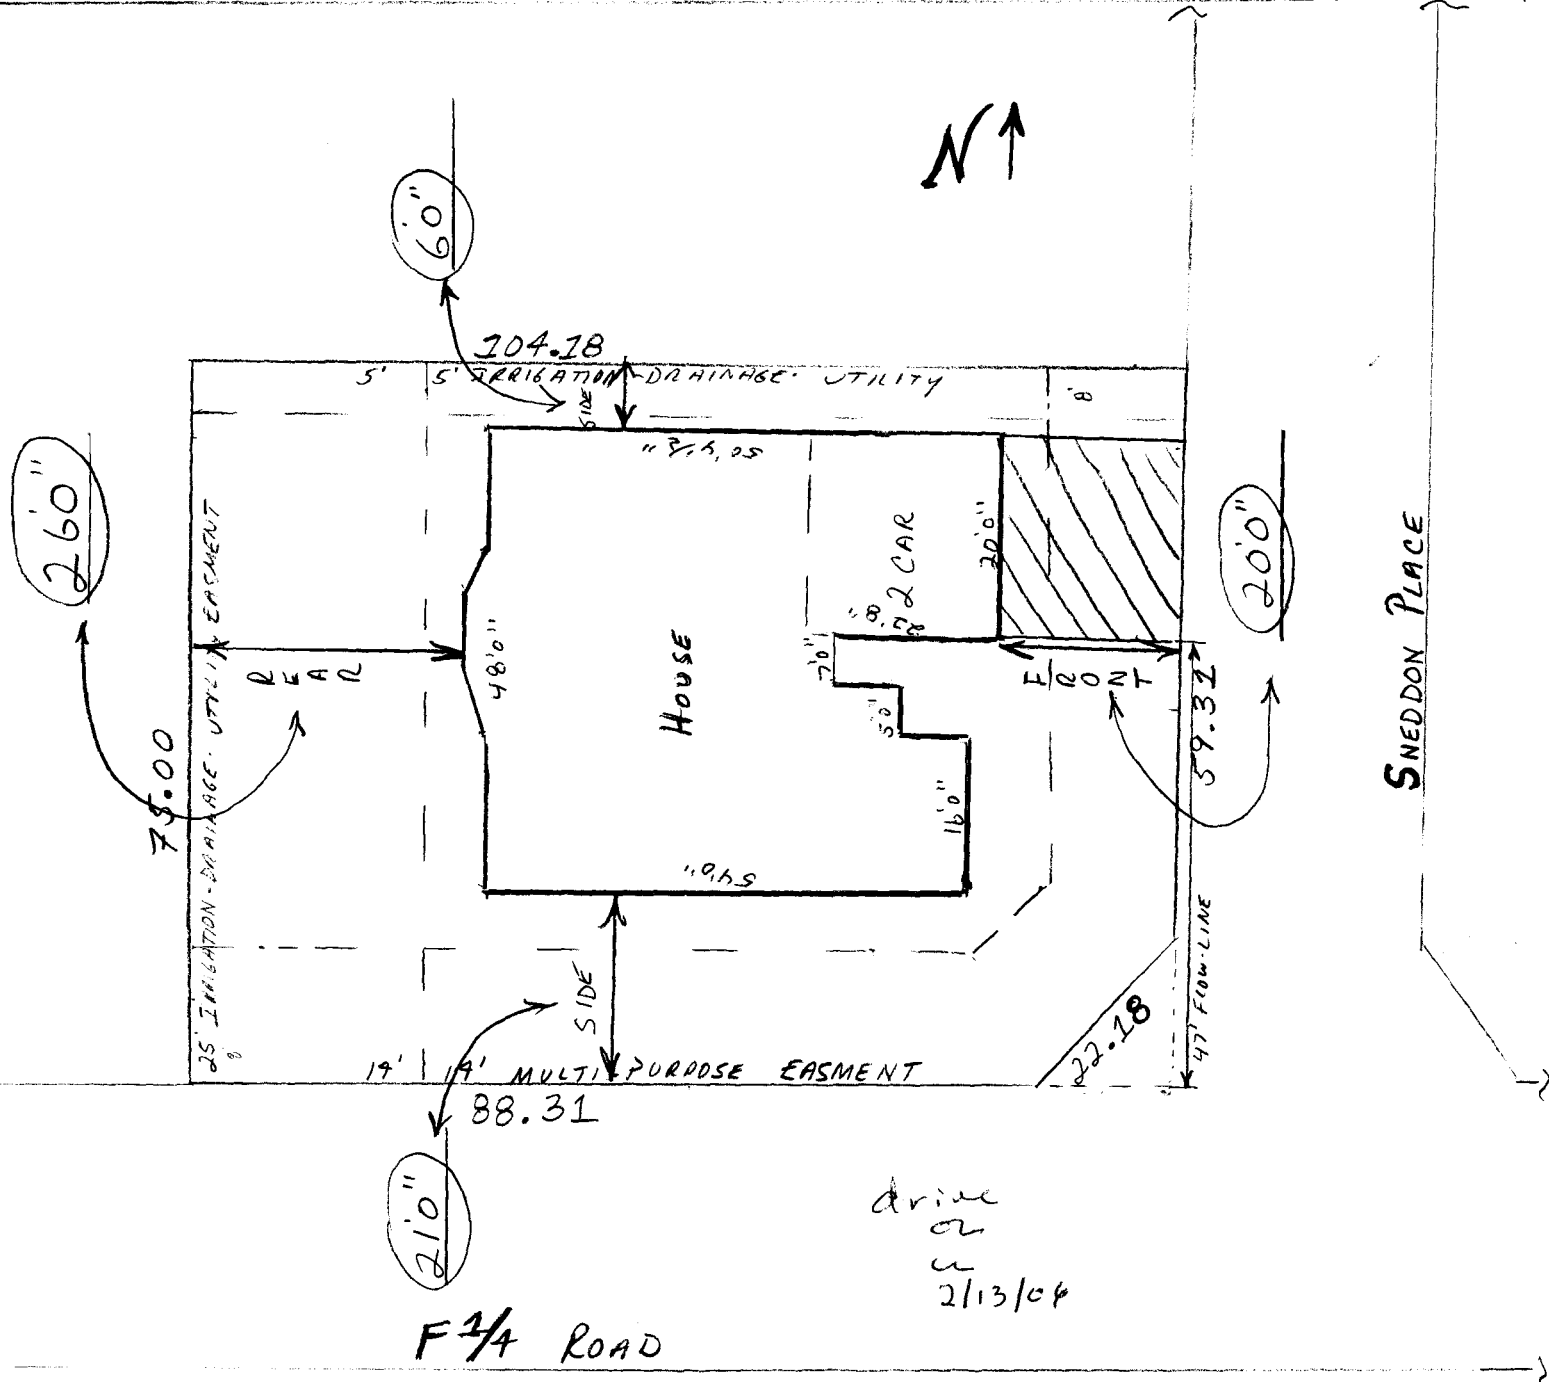

drive
or
u
2/13/04

F 1/4 ROAD

214
 ACCEPTED C. J. Hall
 ANY CHANGE OF SETBACKS MUST BE
 APPROVED BY THE CITY PLANNING
 DEPARTMENT. SEE CITY CODE
 FOR SETBACK REQUIREMENTS.
 LOCAL ORDINANCES.
 APPROVED

PREPARED BY: SNEDDON CONSTRUCTION INC.