FEE\$	10.00
TCP \$	1539.00
SIF\$	4/120.00

PLANNING CLEARANCE

BLDG PERMIT NO.	

(Goldenrod: Utility Accounting)

(Single Family Residential and Accessory Structures)


Community Development Department

Building Address 2057 Snow Mesa Ln	No. of Existing Bldgs No. Proposed
Parcel No. 2947-271-14-008	Sq. Ft. of Existing Bldgs Sq. Ft. Proposed 3500
Subdivision The Seasons	Sq. Ft. of Lot / Parcel 9759
Filing Block Lot	Sq. Ft. Coverage of Lot by Structures & Impervious Surface
OWNER INFORMATION:	(Total Existing & Proposed)
Name Ken C + Karen L Havining	DESCRIPTION OF WORK & INTENDED USE:
Address 255412 F Road	New Single Family Home (*check type below) Interior Remodel Addition
City/State/Zip Grand Jct Colo 81505	Other (please specify):
APPLICANT INFORMATION:	*TYPE OF HOME PROPOSED:
Name Same	Site Built Manufactured Home (UBC) Manufactured Home (HUD)
Address	Other (please specify):
City / State / Zip	NOTES See attacked 1-mail /415 and inc of
Telephone 970-245-2704	from Snow Mesa Court - as proposed
REQUIRED: One plot plan, on 8 1/2" x 11" paper, showing all exproperty lines, ingress/egress to the property, driveway location	isting & proposed structure location(s), parking, setbacks to all a width & all easements & rights-of-way which abut the parcel.
THIS SECTION TO BE COMPLETED BY COMM	
ZONE PD	Maximum coverage of lot by structures
SETBACKS: Front 70 from property line (PL)	Permanent Foundation Required: YESNO
Side 4' from PL Rear 10 from PL	Parking Requirement
Maximum Height of Structure(s) 18 wished for	Special Conditions Engraver fundation
Д Driveway (♣4	for basement
Voting District Location Approval (Engineer's Initials)	
Occupancy has been issued, if applicable, by the Building De	in writing, by the Community Development Department. The ntil a final inspection has been completed and a Certificate of partment (Section 305, Uniform Building Code).
Occupancy has been issued, if applicable, by the Building De I hereby acknowledge that I have read this application and the	ntil a final inspection has been completed and a Certificate of partment (Section 305, Uniform Building Code). information is correct; I agree to comply with any and all codes, project. I understand that failure to comply shall result in legal n-use of the building(s).
Occupancy has been issued, if applicable, by the Building De I hereby acknowledge that I have read this application and the ordinances, laws, regulations or restrictions which apply to the	ntil a final inspection has been completed and a Certificate of partment (Section 305, Uniform Building Code). information is correct; I agree to comply with any and all codes, project. I understand that failure to comply shall result in legal
Occupancy has been issued, if applicable, by the Building De I hereby acknowledge that I have read this application and the ordinances, laws, regulations or restrictions which apply to the action, which may include but not necessarily be limited to not	ntil a final inspection has been completed and a Certificate of partment (Section 305, Uniform Building Code). information is correct; I agree to comply with any and all codes, project. I understand that failure to comply shall result in legal n-use of the building(s).
Occupancy has been issued, if applicable, by the Building De I hereby acknowledge that I have read this application and the ordinances, laws, regulations or restrictions which apply to the action, which may include but not necessarily be limited to not Applicant Signature	ntil a final inspection has been completed and a Certificate of partment (Section 305, Uniform Building Code). information is correct; I agree to comply with any and all codes, project. I understand that failure to comply shall result in legal n-use of the building(s). Date 9-22-04
Occupancy has been issued, if applicable, by the Building De I hereby acknowledge that I have read this application and the ordinances, laws, regulations or restrictions which apply to the action, which may include but not necessarily be limited to not Applicant Signature Department Approval	ntil a final inspection has been completed and a Certificate of partment (Section 305, Uniform Building Code). information is correct; I agree to comply with any and all codes, project. I understand that failure to comply shall result in legal n-use of the building(s). Date 9-22-04

(Pink: Building Department)

(Yellow: Customer)

(White: Planning)

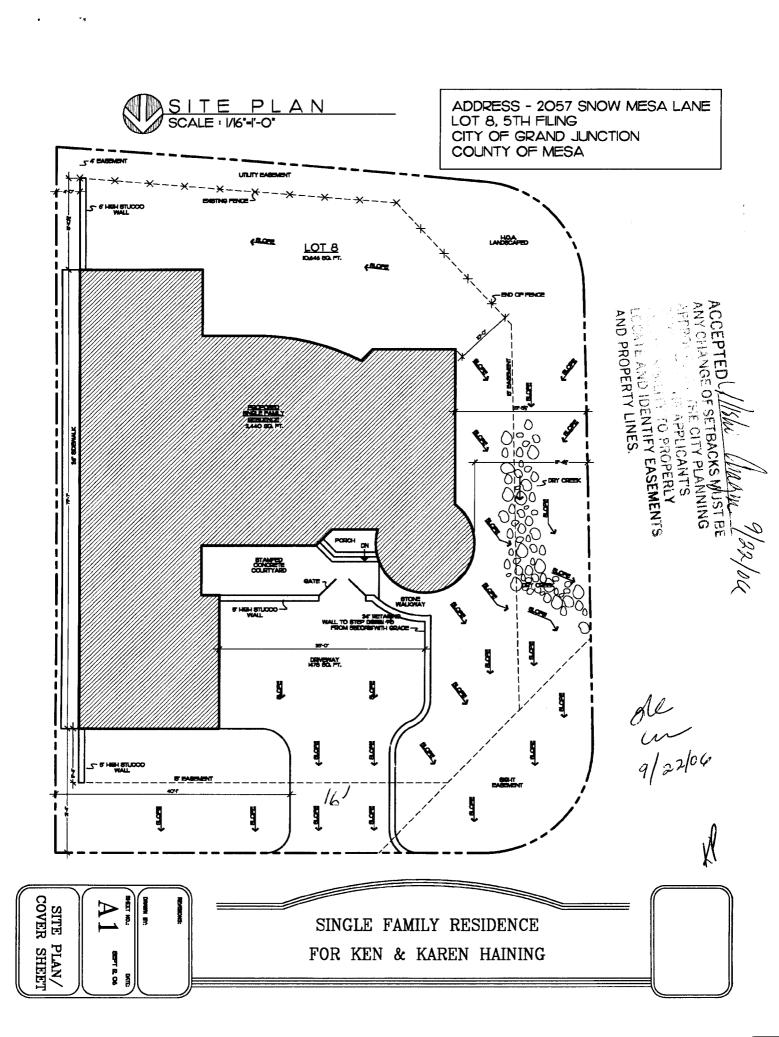

From:

"JACK ACUFF" < jpacuff@bresnan.net>

To:

<kathyp@ci.grandjct.co.us>

Date:

9/21/2006 2:19 PM

Subject:

Lot 8, Filing 5, The Seasons at Tiara Rado - Side building setback

HI Kathy, I am sending this e-mail at the request of Ken and Karen Haining in regards to one of their building setbacks for the above referenced home site.

On Tuesday, Sept 19th, the Hainings submitted their house plans to the Design Review Committee (DRC) for The Seasons at Tiara Rado Subdivision. I chair the DRC. The other members present were John Bonella, Carol Kissinger and Meredith Aldrich – all home owners in The Seasons.

The DRC noted a conflict on the recorded Site Plan for The Seasons Filing No. 5 with regard to the westerly setback. The table of values on the Site Plan indicates a 15 foot setback on the west side for all Lots 1 through 13. However, if one scales the building envelope on the west side of Lot 8, it scales to 20 feet. All other lots, including Lot 7 which is also on a corner, scale to 15 feet. As the developer and Declarant for Filing 5, it was my intent that all of the lots 1 through 13 have a 15 foot westerly setback. How the setback was drawn at 20 feet, I do not know.

At the above referenced DRC meeting, the committee voted to recommend the value set forth in the table (15 foot) since it is most readily apparent as compared to someone scaling the setbacks on the Site Plan. Also, this setback is consistent with the other 1-13 lots. Furthermore,, the DRC would not permit an owner to use the west side as the front of their house because the address has been set on Snow Mesa Lane (the west side is Snow Mesa Ct); and we have a drive over curb on Snow Mesa Lane and a vertical curb on Snow Mesa Court. We would not want the vertical curb cut for a driveway.

I hope that this adequately explains my position and intent as the developer as well as that of the Seasons' Design Review Committee. Accordingly, I hope that the City will accept the 15 foot westerly setback for Lot 8, Filing 5, as well.

Jack Acuff

Internal Virus Database is out-of-date. Checked by AVG Free Edition.

Version: 7.1.392 / Virus Database: 268.10.4/401 - Release Date: 7/26/2006