

FEE \$ 10.00
TCP \$ 1539.00
SIF \$ ~~242.00~~ 460.00

PLANNING CLEARANCE

BLDG PERMIT NO. _____

(Single Family Residential and Accessory Structures)

Community Development Department

Building Address 392 Summer Glen Drive
Parcel No. TBD 2943-192-00-163
Subdivision Summerglen
Filing _____ Block 2 Lot 1

No. of Existing Bldgs 0 No. Proposed 1
Sq. Ft. of Existing Bldgs NA Sq. Ft. Proposed 1116
Sq. Ft. of Lot / Parcel 6206 Sqft
Sq. Ft. Coverage of Lot by Structures & Impervious Surface (Total Existing & Proposed) 1116
Height of Proposed Structure _____

OWNER INFORMATION:

Name Darter LLC
Address 786 Valley Ct.
City / State / Zip GJ CO 81505

DESCRIPTION OF WORK & INTENDED USE:

New Single Family Home (*check type below)
 Interior Remodel Addition
 Other (please specify): _____

APPLICANT INFORMATION:

Name Darter LLC
Address 786 Valley Ct.
City / State / Zip GJ, CO 81505
Telephone 523-5555

*TYPE OF HOME PROPOSED:

Site Built Manufactured Home (UBC)
 Manufactured Home (HUD)
 Other (please specify): _____

NOTES: _____

REQUIRED: One plot plan, on 8 1/2" x 11" paper, showing all existing & proposed structure location(s), parking, setbacks to all property lines, ingress/egress to the property, driveway location & width & all easements & rights-of-way which abut the parcel.

THIS SECTION TO BE COMPLETED BY COMMUNITY DEVELOPMENT DEPARTMENT STAFF

ZONE RMF-8 Maximum coverage of lot by structures 70%
SETBACKS: Front 20' from property line (PL) Permanent Foundation Required: YES NO
Side 5' from PL Rear 10' from PL Parking Requirement 2
Maximum Height of Structure(s) 35' Special Conditions _____
Voting District E Driveway Location Approval RAID
(Engineer's Initials)

Modifications to this Planning Clearance must be approved, in writing, by the Community Development Department. The structure authorized by this application cannot be occupied until a final inspection has been completed and a Certificate of Occupancy has been issued, if applicable, by the Building Department (Section 305, Uniform Building Code).



I hereby acknowledge that I have read this application and the information is correct; I agree to comply with any and all codes, ordinances, laws, regulations or restrictions which apply to the project. I understand that failure to comply shall result in legal action, which may include but not necessarily be limited to non-use of the building(s).

Applicant Signature [Signature] Date 12/13/05
Department Approval [Signature] Date 1-17-06

Additional water and/or sewer tap fee(s) are required. YES NO W/O No. 18766
Utility Accounting [Signature] Date 1/17/06

VALID FOR SIX MONTHS FROM DATE OF ISSUANCE (Section 2.2.C.1 Grand Junction Zoning & Development Code)
(White: Planning) (Yellow: Customer) (Pink: Building Department) (Goldenrod: Utility Accounting)

Handwritten notes and signature:
Summer Glen
1-11-00
K. Nasser

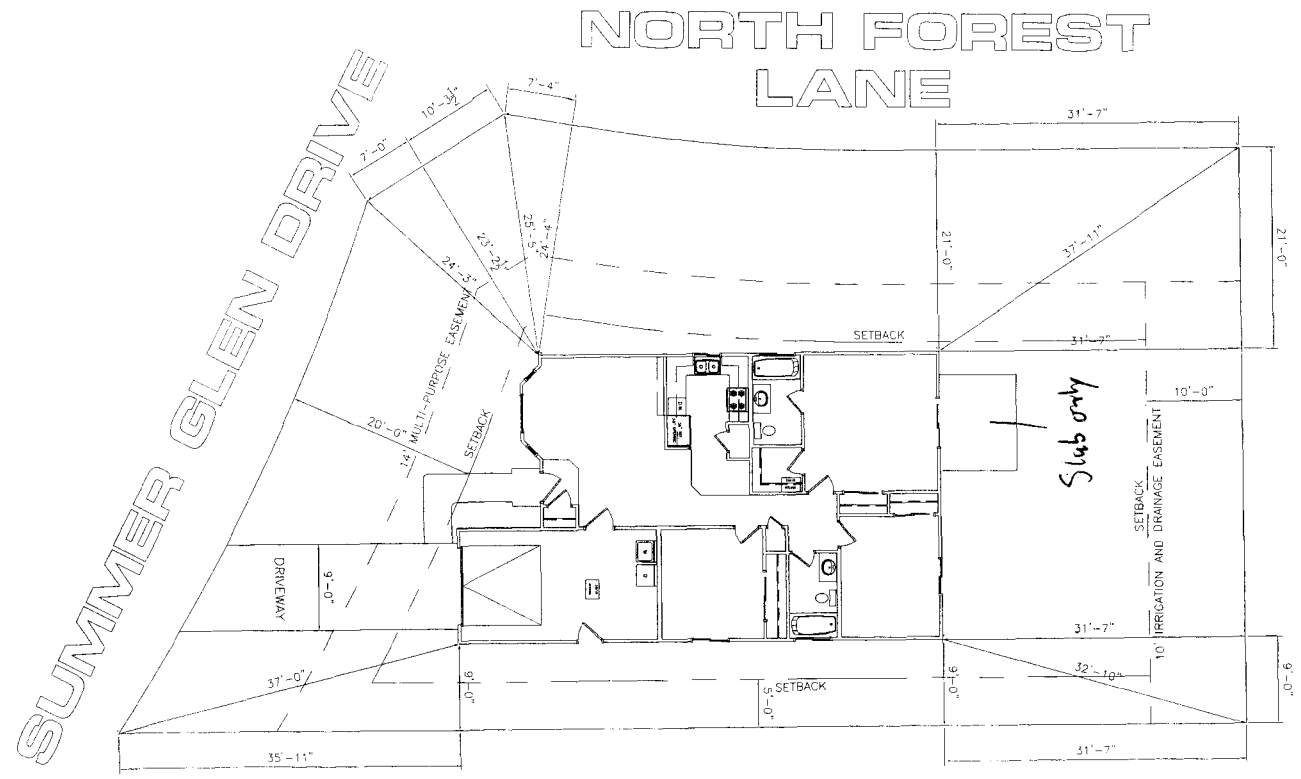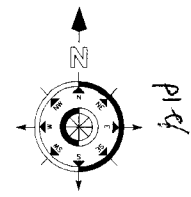

NOTE:
 DIMENSION LINES ARE PULLED FROM EDGE OF BRICK LEDGE. IF NO BRICK LEDGE EXISTS, DIMENSIONS WILL BE FROM EDGE OF FOUNDATION.

NOTE:
 1. IT IS THE RESPONSIBILITY OF THE BUILDER OR OWNER TO VERIFY ALL DETAILS AND DIMENSIONS PRIOR TO CONSTRUCTION.
 2. USE OF THIS PLAN CONSTITUTES BUILDER AND OR HOME OWNERS ACCEPTANCE OF THESE TERMS.
 3. ALL DIMENSIONS ARE TO EDGE OF FOUNDATION UNLESS OTHER WISE NOTED.
 4. BUILDER AND OR OWNER TO VERIFY ALL SETBACKS AND EASEMENTS.
 5. THIS PLAN HAS NOT BEEN ENGINEERED BY AUTOCAD. SEE SEPARATE DRAWINGS BY OTHERS FOR ENGINEERING DATA.

NOTE:
 GRADE MUST SLOPE AWAY FROM HOUSE 5" OF FALL IN THE FIRST 10' OF DISTANCE PER LOCAL BUILDING CODE.

NOTE:
 BUILDER TO VERIFY ALL SETBACK AND EASEMENT ENCROACHMENTS PRIOR TO CONSTRUCTION

SITE PLAN INFORMATION	
SUBDIVISION NAME	SUMMER GLEN
FILING NUMBER	1
LOT NUMBER	1
BLOCK NUMBER	2
STREET ADDRESS	392 SUMMER GLEN DR.
COUNTY	MESA
GARAGE SQ. FT.	252
COVERED ENTRY SQ. FT.	N/A
COVERED PATIO SQ. FT.	N/A
LIVING SQ. FT.	1132
LOT SIZE	6206.1 SQ. FT.
SETBACKS USED	FRONT 20'
	SIDES 5'
	REAR 10'

SCALE: 1" = 20'-0"