

FEE \$10.00  
 TCP \$1539.00  
 SIF \$400.00

**PLANNING CLEARANCE**  
 (Single Family Residential and Accessory Structures)  
 Community Development Department

BLDG PERMIT NO. \_\_\_\_\_

Building Address 396 Summer Glen Dr.  
 Parcel No. TBD 2943-192 00-163  
 Subdivision Summer Glen  
 Filing 1 Block 1 Lot 2

No. of Existing Bldgs 0 No. Proposed 1  
 Sq. Ft. of Existing Bldgs N/A Sq. Ft. Proposed 1135  
 Sq. Ft. of Lot / Parcel 4953  
 Sq. Ft. Coverage of Lot by Structures & Impervious Surface  
 (Total Existing & Proposed) 1135  
 Height of Proposed Structure \_\_\_\_\_

**OWNER INFORMATION:**

Name Darter LLC  
 Address 786 Valley Ct.  
 City / State / Zip GJ CO 81505

**DESCRIPTION OF WORK & INTENDED USE:**

New Single Family Home (\*check type below)  
 Interior Remodel  Addition  
 Other (please specify): \_\_\_\_\_

**APPLICANT INFORMATION:**

Name Grace Homes  
 Address 786 Valley Ct.  
 City / State / Zip GJ CO 81505  
 Telephone 523-5555

**\*TYPE OF HOME PROPOSED:**

Site Built  Manufactured Home (UBC)  
 Manufactured Home (HUD)  
 Other (please specify): \_\_\_\_\_

NOTES: \_\_\_\_\_

**REQUIRED: One plot plan, on 8 1/2" x 11" paper, showing all existing & proposed structure location(s), parking, setbacks to all property lines, ingress/egress to the property, driveway location & width & all easements & rights-of-way which abut the parcel.**

**THIS SECTION TO BE COMPLETED BY COMMUNITY DEVELOPMENT DEPARTMENT STAFF**

ZONE RMF-8 Maximum coverage of lot by structures 70%  
 SETBACKS: Front 20' from property line (PL) Permanent Foundation Required: YES  NO \_\_\_\_\_  
 Side 5' from PL Rear 10' from PL Parking Requirement \_\_\_\_\_  
 Maximum Height of Structure(s) 35' Special Conditions \_\_\_\_\_  
 Voting District E Driveway Location Approval W \_\_\_\_\_  
 (Engineer's Initials)

PAID  
 JAN 27 2006  
 TR

Modifications to this Planning Clearance must be approved, in writing, by the Community Development Department. The structure authorized by this application cannot be occupied until a final inspection has been completed and a Certificate of Occupancy has been issued, if applicable, by the Building Department (Section 305, Uniform Building Code).

I hereby acknowledge that I have read this application and the information is correct; I agree to comply with any and all codes, ordinances, laws, regulations or restrictions which apply to the project. I understand that failure to comply shall result in legal action, which may include but not necessarily be limited to non-use of the building(s).



Applicant Signature [Signature] - Agent Date 1/25/06  
 Department Approval K.V. Gaylen Henderson Date 1-27-06

Additional water and/or sewer tap fee(s) are required: YES  NO \_\_\_\_\_ W/O No. 18787  
 Utility Accounting [Signature] Date 1/27/06

VALID FOR SIX MONTHS FROM DATE OF ISSUANCE (Section 2.2.C.1 Grand Junction Zoning & Development Code)  
 (White: Planning) (Yellow: Customer) (Pink: Building Department) (Goldenrod: Utility Accounting)

ACCEPTED *KV* *Stephen Williams*  
 ANY CHANGE OF SETBACKS MUST BE APPROVED BY THE PLANNING DEPT. IT IS THE OWNER'S RESPONSIBILITY TO PROPERLY LOCATE AND IDENTIFY EASEMENTS AND PROPERTY LINES.

1-27-06 396 SUMMER GLEN DRIVE

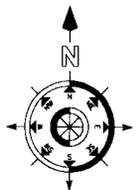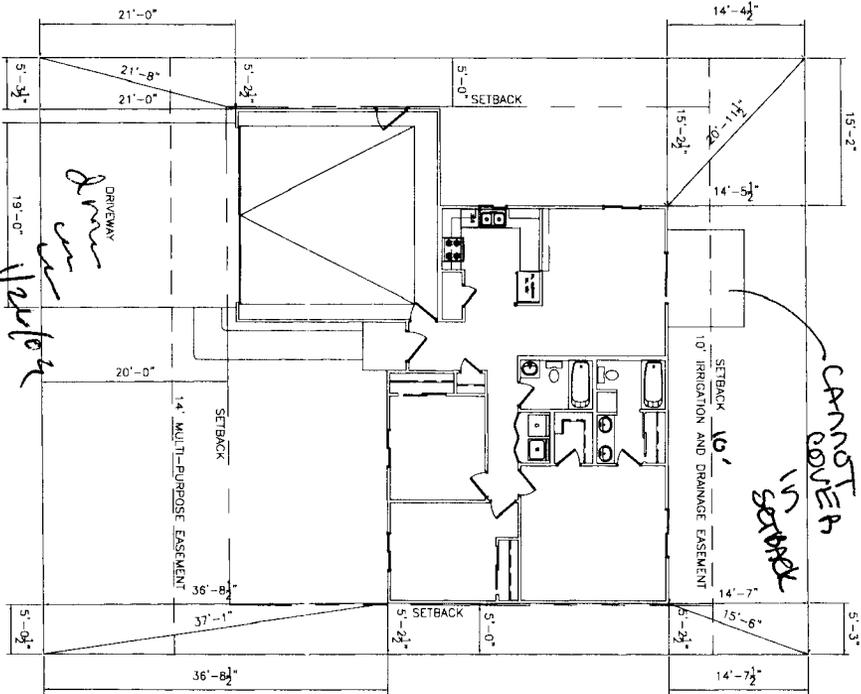

NOTE:  
 DIMENSION LINES ARE PULLED FROM EDGE OF BRICK LEDGE. IF NO BRICK LEDGE EXISTS, DIMENSIONS WILL BE FROM EDGE OF FOUNDATION.

- NOTE:
1. IT IS THE RESPONSIBILITY OF THE BUILDER OR OWNER TO VERIFY ALL DETAILS AND DIMENSIONS PRIOR TO CONSTRUCTION.
  2. USE OF THIS PLAN CONSTITUTES BUILDER AND OR HOME OWNERS ACCEPTANCE OF THESE TERMS.
  3. ALL DIMENSIONS ARE TO EDGE OF FOUNDATION UNLESS OTHER WISE NOTED.
  4. BUILDER AND OR OWNER TO VERIFY ALL SETBACKS AND EASEMENTS.
  5. THIS PLAN HAS NOT BEEN ENGINEERED BY AUTOMAT. SEE SEPARATE DRAWINGS BY OTHERS FOR ENGINEERING DATA.

NOTE:  
 GRADE MUST SLOPE AWAY FROM HOUSE 6" OF FALL IN THE FIRST 10' OF DISTANCE PER LOCAL BUILDING CODE.

NOTE:  
 BUILDER TO VERIFY ALL SETBACK AND EASEMENT ENCROACHMENTS PRIOR TO CONSTRUCTION

SITE PLAN INFORMATION	
SUBDIVISION NAME	SUMMER GLEN
FILING NUMBER	1
LOT NUMBER	2
BLOCK NUMBER	1
STREET ADDRESS	396 SUMMER GLEN DR.
COUNTY	MESA
GARAGE SQ. FT.	470
COVERED ENTRY SQ. FT.	10
COVERED PATIO SQ. FT.	N/A
LIVING SQ. FT.	1136
LOT SIZE	4963.6 SQ. FT.
SETBACKS USED	FRONT 20' SIDES 5' REAR 10'

SCALE: 1" = 20'-0"