

10.00  
 TCP \$ 1539.00  
 SIF \$ ~~292.00~~  
 460.00

BLDG PERMIT NO. \_\_\_\_\_

# PLANNING CLEARANCE

(Single Family Residential and Accessory Structures)  
Community Development Department

Building Address 399 Summer Glen Dr.  
 Parcel No. 2943-192-00-163  
 Subdivision Summer Glen  
 Filing \_\_\_\_\_ Block 5 Lot 25

No. of Existing Bldgs 0 No. Proposed 1  
 Sq. Ft. of Existing Bldgs NA Sq. Ft. Proposed 1116  
 Sq. Ft. of Lot / Parcel 4846  
 Sq. Ft. Coverage of Lot by Structures & Impervious Surface (Total Existing & Proposed) 1116  
 Height of Proposed Structure \_\_\_\_\_

**OWNER INFORMATION:**

Name Darter LLC  
 Address 786 Valley Ct.  
 City / State / Zip CO, 81504

DESCRIPTION OF WORK & INTENDED USE:  
 New Single Family Home (\*check type below)  
 Interior Remodel  Addition  
 Other (please specify): \_\_\_\_\_

**APPLICANT INFORMATION:**

Name Grace Homes  
 Address 786 Valley Ct.  
 City / State / Zip CO 81504  
 Telephone 523-5555

\*TYPE OF HOME PROPOSED:  
 Site Built  Manufactured Home (UBC)  
 Manufactured Home (HUD)  
 Other (please specify): \_\_\_\_\_

NOTES: \_\_\_\_\_

**REQUIRED: One plot plan, on 8 1/2" x 11" paper, showing all existing & proposed structure location(s), parking, setbacks to all property lines, ingress/egress to the property, driveway location & width & all easements & rights-of-way which abut the parcel.**

THIS SECTION TO BE COMPLETED BY COMMUNITY DEVELOPMENT DEPARTMENT STAFF	
ZONE <u>RMF-8</u>	Maximum coverage of lot by structures <u>70%</u>
SETBACKS: Front <u>20'</u> from property line (PL)	Permanent Foundation Required: YES <input checked="" type="checkbox"/> NO _____
Side <u>5'</u> from PL Rear <u>10'</u> from PL	Parking Requirement <u>2</u>
Maximum Height of Structure(s) <u>35'</u>	Special Conditions _____
Voting District <u>E</u>	Driveway Location Approval _____ (Engineer's Initials)

Modifications to this Planning Clearance must be approved, in writing, by the Community Development Department. The structure authorized by this application cannot be occupied until a final inspection has been completed and a Certificate of Occupancy has been issued, if applicable, by the Building Department (Section 305, Uniform Building Code).



I hereby acknowledge that I have read this application and the information is correct; I agree to comply with any and all codes, ordinances, laws, regulations or restrictions which apply to the project. I understand that failure to comply shall result in legal action, which may include but not necessarily be limited to non-use of the building(s).

Applicant Signature [Signature] - Agent Date 1/3/06  
 Department Approval [Signature] Date 1/25/06

Additional water and/or sewer tap fee(s) are required: YES <input checked="" type="checkbox"/> NO _____	W/O No. <u>18781</u>
Utility Accounting <u>[Signature]</u>	Date <u>1/25/06</u>

VALID FOR SIX MONTHS FROM DATE OF ISSUANCE (Section 2.2.C.1 Grand Junction Zoning & Development Code)  
 (White: Planning) (Yellow: Customer) (Pink: Building Department) (Goldenrod: Utility Accounting)

D ROAD

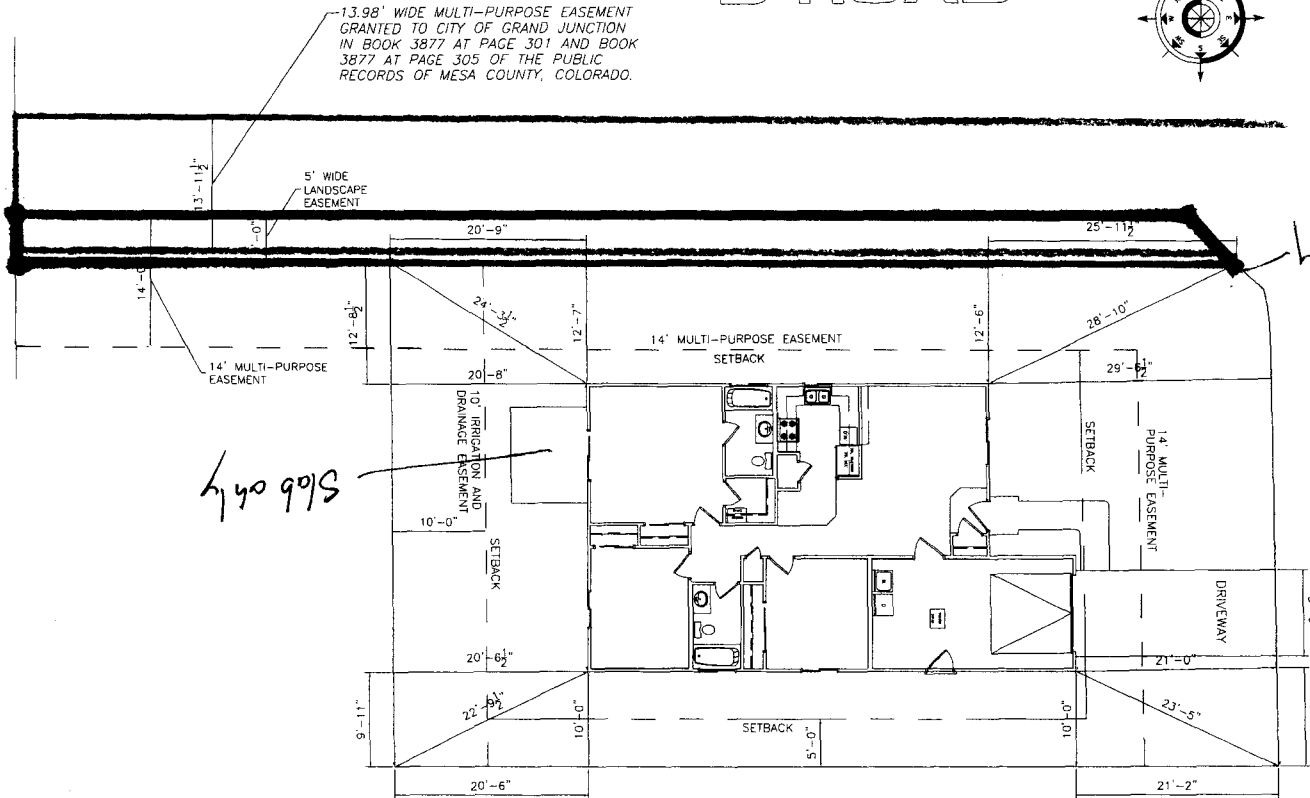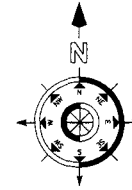

SUMMER GLEN DRIVE

44099S

NOTE:  
DIMENSION LINES ARE PULLED FROM  
EDGE OF BRICK LEDGE. IF NO BRICK LEDGE  
EXISTS, DIMENSIONS WILL BE FROM EDGE  
OF FOUNDATION.

SOURCE:  
1. IT IS THE RESPONSIBILITY OF THE BUILDER OR OWNER TO VERIFY ALL DETAILS  
AND DIMENSIONS PRIOR TO CONSTRUCTION.  
2. USE OF THIS PLAN CONSTITUTES BUILDER AND OR HOME OWNERS ACCEPTANCE OF THESE TERMS.  
3. ALL DIMENSIONS ARE TO EDGE OF FOUNDATION UNLESS OTHER WISE NOTED.  
4. BUILDER AND OR OWNER TO VERIFY ALL SETBACKS AND EASEMENTS.  
5. THIS PLAN HAS NOT BEEN ENGINEERED BY ANYONE. SEE SEPARATE DRAWINGS BY OTHERS  
FOR ENGINEERING DATA.

SITE PLAN INFORMATION	
SUBDIVISION NAME	SUMMER GLEN
FILING NUMBER	1
LOT NUMBER	25
BLOCK NUMBER	5
STREET ADDRESS	399 SUMMER GLEN DR.
COUNTY	MESA
GARAGE SQ. FT.	252
COVERED ENTRY SQ. FT.	N/A
COVERED PATIO SQ. FT.	N/A
LIVING SQ. FT.	1115
LOT SIZE	4846.6 SQ.FT.
FRONT	20'
SIDES	5'
REAR	10'
SETBACKS USED	

NOTE:  
GRADE MUST SLOPE AWAY FROM HOUSE 6" OF FALL IN  
THE FIRST 10' OF DISTANCE PER LOCAL BUILDING CODE.

NOTE:  
BUILDER TO VERIFY  
ALL SETBACK AND EASEMENT  
ENCROACHMENTS PRIOR  
TO CONSTRUCTION

SCALE: 1" = 20'-0"

11' MPE  
13.98' MPE  
5' LANDSCAPE ESMT

ACCEPTED  
ANY CHANGE OF SETBACKS MUST BE  
IMPROVED BY THE PLANNING  
DEPARTMENT.  
RESPONSIBILITY FOR VERIFYING  
LOCAL AND STATE EASEMENTS  
AND PROPERTY LINES.

*Stephan Anderson*

1/25/06