

FEE \$	10 ⁰⁰
TCP \$	1539 ⁰⁰
SIF \$	460 ⁰⁰

PLANNING CLEARANCE
(Single Family Residential and Accessory Structures)
Community Development Department

BLDG PERMIT NO. _____

Building Address 2468 Theresa Ln.
 Parcel No. 2945-041-27-090
 Subdivision Brookwillow
 Filing 1 Block _____ Lot 90

No. of Existing Bldgs 0 No. Proposed 1
 Sq. Ft. of Existing Bldgs NA Sq. Ft. Proposed _____
 Sq. Ft. of Lot / Parcel _____
 Sq. Ft. Coverage of Lot by Structures & Impervious Surface (Total Existing & Proposed) _____
 Height of Proposed Structure _____

OWNER INFORMATION:

Name Darter LLC
 Address 786 Vally Ct.
 City / State / Zip GJ CO 81205

DESCRIPTION OF WORK & INTENDED USE:

New Single Family Home (*check type below)
 Interior Remodel Addition
 Other (please specify): Townhome

APPLICANT INFORMATION:

Name Grace Hows
 Address 786 Vally Ct.
 City / State / Zip GJ CO 81205
 Telephone 248-8522

***TYPE OF HOME PROPOSED:**

Site Built Manufactured Home (UBC)
 Manufactured Home (HUD)
 Other (please specify): _____

NOTES: _____

REQUIRED: One plot plan, on 8 1/2" x 11" paper, showing all existing & proposed structure location(s), parking, setbacks to all property lines, ingress/egress to the property, driveway location & width & all easements & rights-of-way which abut the parcel.

THIS SECTION TO BE COMPLETED BY COMMUNITY DEVELOPMENT DEPARTMENT STAFF

ZONE <u>PD</u>	Maximum coverage of lot by structures <u>per plan</u>
SETBACKS: Front <u>20'</u> from property line (PL)	Permanent Foundation Required: YES <u>X</u> NO _____
Side <u>per plan</u> from PL Rear <u>per plan</u> from PL	Parking Requirement <u>2</u>
Maximum Height of Structure(s) <u>per plan</u>	Special Conditions <u>refer to 12/19/06 site plan</u>
Voting District <u>B</u>	Driveway Location Approval <u>JAR/RMD</u> <u>FP-2005-144</u>
	<u>19.112 \$27.17 Between 90 & 89</u>

Modifications to this Planning Clearance must be approved, in writing, by the Community Development Department. The structure authorized by this application cannot be occupied until a final inspection has been completed and a Certificate of Occupancy has been issued, if applicable, by the Building Department (Section 305, Uniform Building Code).

I hereby acknowledge that I have read this application and the information is correct; I agree to comply with any and all codes, ordinances, laws, regulations or restrictions which apply to the project. I understand that failure to comply shall result in legal action, which may include but not necessarily be limited to non-use of the building(s).

Applicant Signature [Signature] Date 10/24/06

Department Approval [Signature] Date 12/29/06

Additional water and/or sewer tap fee(s) are required: YES <input checked="" type="checkbox"/> NO <input type="checkbox"/> W/O No. <input type="checkbox"/>
Utility Accounting <u>[Signature]</u> Date <u>12/29/06</u>


VALID FOR SIX MONTHS FROM DATE OF ISSUANCE (Section 2.2.C.1 Grand Junction Zoning & Development Code)
 (White: Planning) (Yellow: Customer) (Pink: Building Department) (Goldenrod: Utility Accounting)

2468 THERESA LN

Lot 90

ACCEPTED JAR [Signature] 12/20/02
BY [Signature] OF SETBACKS MUST BE
THE CITY PLANNING
APPLICANTS
TO PROPERTY

LOCATE AND IDENTIFY EASEMENTS
AND PROPERTY LINES

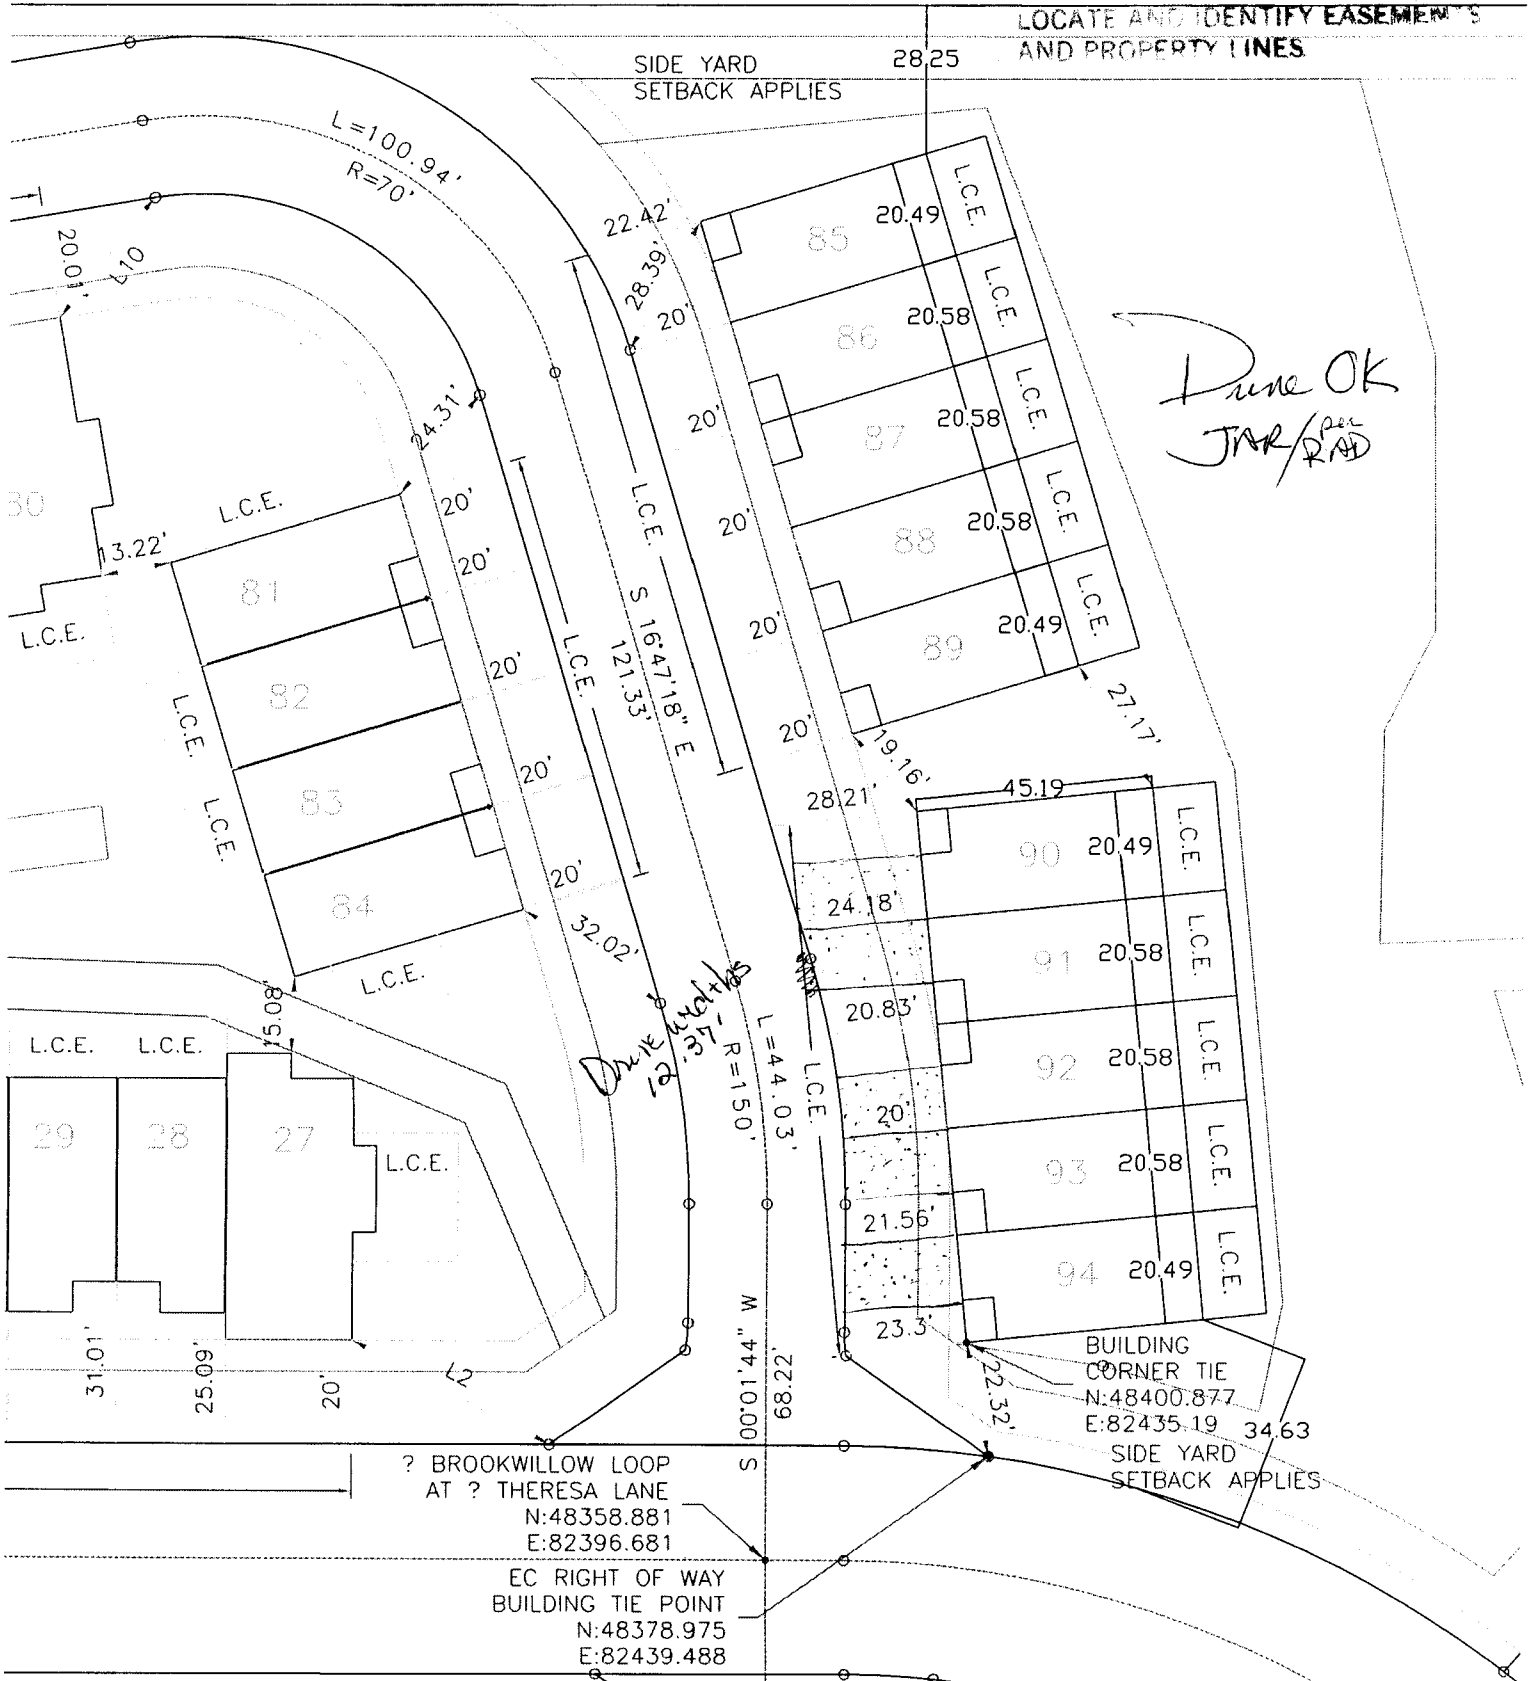

Dune OK
JAR/RAD

? BROOKWILLOW LOOP
AT THERESA LANE
N:48358.881
E:82396.681

EC RIGHT OF WAY
BUILDING TIE POINT
N:48378.975
E:82439.488

BUILDING
CORNER TIE
N:48400.877
E:82435.19