
*								
FEE \$ 10.00/ PLANNING CLEA	BLDG PERMIT NO.							
TCP \$ (Single Family Residential and Ad	-							
SIF \$	nt Department							
Building Address 1730 White Ave	No. of Existing Bldgs No. Proposed							
•								
Parcel No. 2945-133-01-017	Sq. Ft. of Existing Bldgs Sq. Ft. Proposed							
Subdivision	Sq. Ft. of Lot / Parcel 139 ac .							
Filing Block Lot	Sq. Ft. Coverage of Lot by Structures & Impervious Surface (Total Existing & Proposed)							
OWNER INFORMATION:	(Total Existing & Proposed) Height of Proposed Structure							
Name Shawna Schaam	DESCRIPTION OF WORK & INTENDED USE:							
Address 1730 White Ave	New Single Family Home (*check type below) Interior Remodel Addition							
City / State / Zip 65, 681501	Y Other (please specify): <u>abane quict</u> pool							
APPLICANT INFORMATION:	_*TYPE OF HOME PROPOSED:							
Name Shawna Scham	Site Built Manufactured Home (UBC) Manufactured Home (HUD) ✓ Other (please specify):a bow Gmd pool							
Address 1730 White Ave	\checkmark Other (please specify): a bow Gmd pool							
City/State/Zip GJ, Co 81501	NOTES: 12 × 28' above ground pool							
Telephone 985-4084								
REQUIRED: One plot plan, on 8 1/2" x 11" paper, showing all existing & proposed structure location(s), parking, setbacks to all property lines, ingress/egress to the property, driveway location & width & all easements & rights-of-way which abut the parcel.								
THIS SECTION TO BE COMPLETED BY COM	NUNITY DEVELOPMENT DEPARTMENT STAFF							
ZONE EMF 8	Maximum coverage of lot by structures							
SETBACKS: Frontfrom property line (PL)	Permanent Foundation Required: YESNO							
Side from PL Rear from PL	Parking Requirement							
Maximum Height of Structure(s)	Special Conditions							
Voting District Driveway Location Approval (Engineer's Initials)								
	in writing, by the Community Development Department. The ntil a final inspection has been completed and a Certificate of partment (Section 305, Uniform Building Code).							

I hereby acknowledge that I have read this application and the information is correct; I agree to comply with any and all codes, ordinances, laws, regulations or restrictions which apply to the project. I understand that failure to comply shall result in legal action, which may include but not necessarily be limited to non-use of the building(s).

Applicant Signature	na lehan	Date	-22-06
Department Approval	Alaka	Date	22 06
Additional water and/or sewer tap	feels) are required. YES	NQ W/O No.	
Utility Accounting	Bhen 5	Date U	alle -
	1 DATE OF ISSUANCE (Section 2 v: Customer) (Pink: Buildin	.2.C.1 Grand Junction	Zoning & Development Code) (Goldenrod: Utility Accounting)

Vhite:	Planning)	(Yellow: Cu

_	~v	~	•••	•••			-	•••	-			-	~	
/P	in	Ŀ.	R	ni	Ы	ng	n	on	an	fm	on	+		
v		٦.		un	u,	''y		eμ			¢1	4		

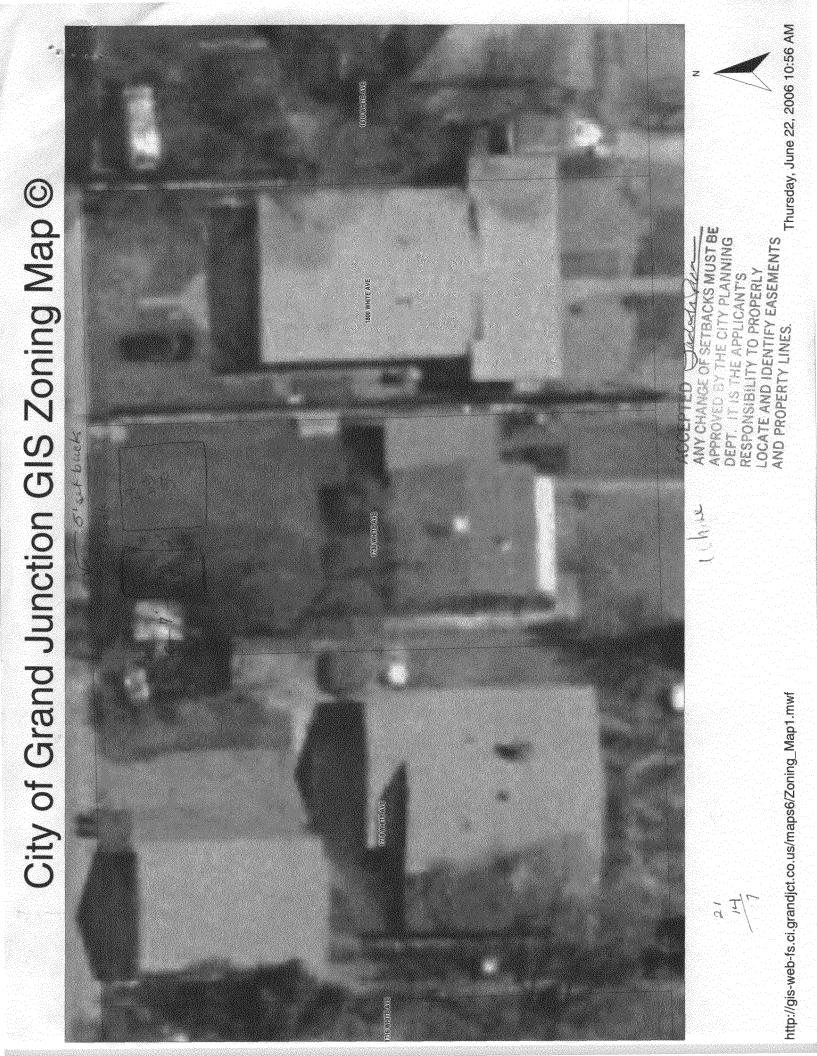

City of Grand Junction GIS Zoning Map C

