

FEE \$ 10.00
 TCP \$ 1589.00
 SIF \$ 460.00

PLANNING CLEARANCE
 (Single Family Residential and Accessory Structures)
Community Development Department

BLDG PERMIT NO. _____

Building Address 408 29 1/2 Rd No. of Existing Bldgs 0 No. Proposed 1
 Parcel No. 2943-174-40-015 Sq. Ft. of Existing Bldgs 0 Sq. Ft. Proposed 1417 SF
 Subdivision COUNTRY PLACE ESTATES Sq. Ft. of Lot / Parcel 4675 SQ FT
 Filing 1 Block 3 Lot 15 Sq. Ft. Coverage of Lot by Structures & Impervious Surface (Total Existing & Proposed) 2486 SQ FT.
 Height of Proposed Structure 17'

OWNER INFORMATION:

Name GARY Rinderle Const
 Address Po Box 1380
 City / State / Zip Clifton Co 81520

DESCRIPTION OF WORK & INTENDED USE:
 New Single Family Home (*check type below)
 Interior Remodel Addition
 Other (please specify): _____

APPLICANT INFORMATION:

Name SAME AS OWNER
 Address _____
 City / State / Zip _____
 Telephone 434-0510

*TYPE OF HOME PROPOSED:
 Site Built Manufactured Home (UBC)
 Manufactured Home (HUD)
 Other (please specify): _____

NOTES: NEW SFR

REQUIRED: One plot plan, on 8 1/2" x 11" paper, showing all existing & proposed structure location(s), parking, setbacks to all property lines, ingress/egress to the property, driveway location & width & all easements & rights-of-way which abut the parcel.

THIS SECTION TO BE COMPLETED BY COMMUNITY DEVELOPMENT DEPARTMENT STAFF	
ZONE <u>RMF-8</u>	Maximum coverage of lot by structures <u>70%</u>
SETBACKS: Front <u>20'</u> from property line (PL)	Permanent Foundation Required: YES <input checked="" type="checkbox"/> NO <input type="checkbox"/>
Side <u>5'</u> from PL Rear <u>10'</u> from PL	Parking Requirement <u>2</u>
Maximum Height of Structure(s) <u>35'</u>	Special Conditions _____
Voting District <u>"C"</u> Driveway Location Approval <u>gld</u> (Engineer's Initials)	

Modifications to this Planning Clearance must be approved, in writing, by the Community Development Department. The structure authorized by this application cannot be occupied until a final inspection has been completed and a Certificate of Occupancy has been issued, if applicable, by the Building Department (Section 305, Uniform Building Code).

I hereby acknowledge that I have read this application and the information is correct; I agree to comply with any and all codes, ordinances, laws, regulations or restrictions which apply to the project. I understand that failure to comply shall result in legal action, which may include but not necessarily be limited to non-use of the building(s).

Applicant Signature _____ Date 1-12-07


Department Approval _____ Date 1/29/07

Additional water and/or sewer tap fee(s) are required: YES <input checked="" type="checkbox"/> NO <input type="checkbox"/>	W/O No. <u>19934</u>
Utility Accounting <u>Walt Alderman</u>	Date <u>1/29/07</u>

VALID FOR SIX MONTHS FROM DATE OF ISSUANCE (Section 2.2.C.1 Grand Junction Zoning & Development Code)
 (White: Planning) (Yellow: Customer) (Pink: Building Department) (Goldenrod: Utility Accounting)

ACCEPTED
 ANY OTHER WORKS MUST BE
 APPROVED BY PLANNING
 DEPARTMENT
 APPLICANTS
 TO PROPERLY
 IDENTIFY EASEMENTS
 AND UTILITIES

12/29/06

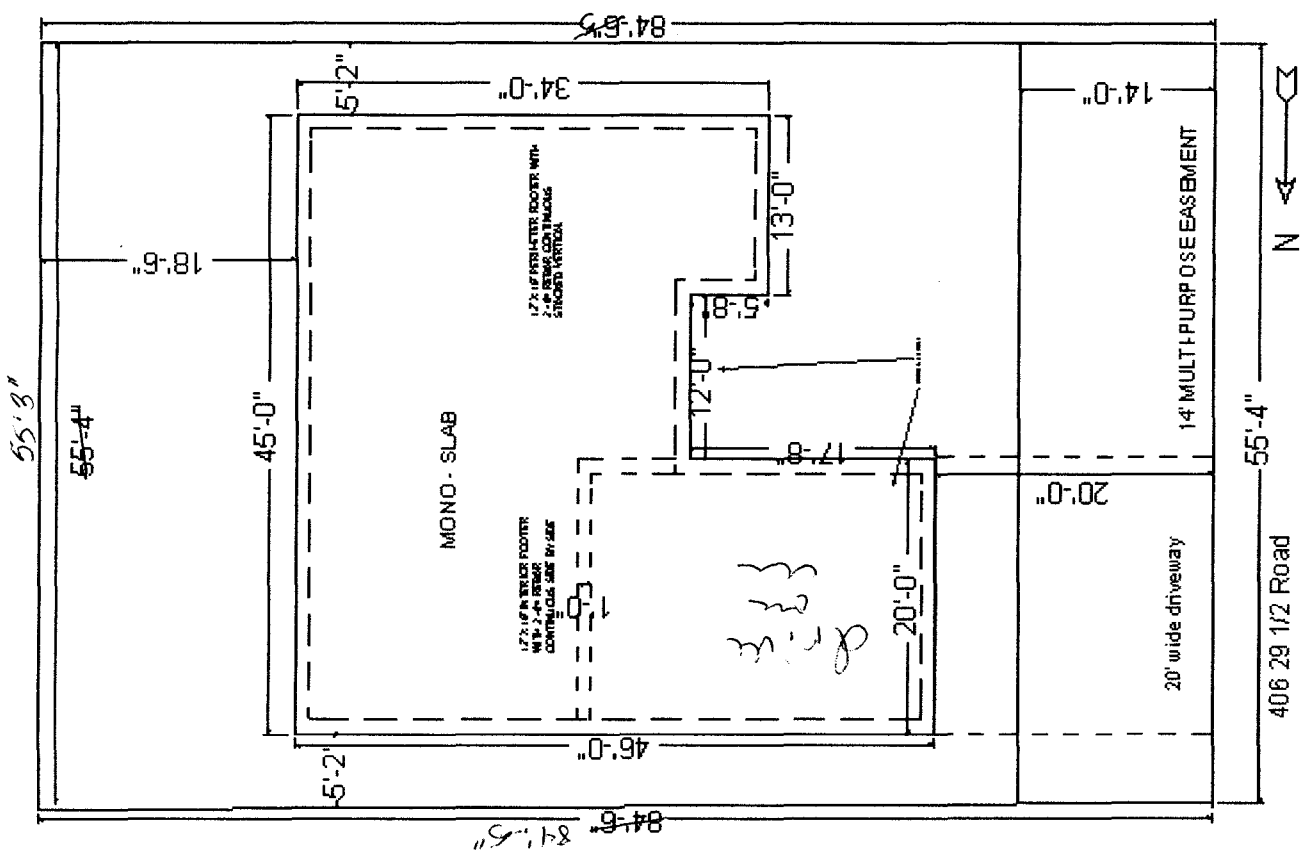

Done okay
 4/15/06
 12/19/06