

FEE \$	10.00
TCP \$	1589.00
SIF \$	460.00

**PLANNING CLEARANCE**  
 (Single Family Residential and Accessory Structures)  
**Community Development Department**

BLDG PERMIT NO. \_\_\_\_\_

Building Address 416 1/2 29 1/2 Rd  
 Parcel No. 2943-173-43-015  
 Subdivision COUNTRY PLACE ESTATES  
 Filing 1 Block 156 Lot 15

No. of Existing Bldgs 0 No. Proposed 1  
 Sq. Ft. of Existing Bldgs 0 Sq. Ft. Proposed 1794  
 Sq. Ft. of Lot / Parcel 4521  
 Sq. Ft. Coverage of Lot by Structures & Impervious Surface (Total Existing & Proposed) 2455  
 Height of Proposed Structure 24

**OWNER INFORMATION:**

Name TML ENTERPRISES INC  
 Address PO Box 2569  
 City / State / Zip GJ CO 81502

**DESCRIPTION OF WORK & INTENDED USE:**

- New Single Family Home (\*check type below)
- Interior Remodel  Addition
- Other (please specify): \_\_\_\_\_

**APPLICANT INFORMATION:**

Name TML ENTERPRISES INC  
 Address P.O. Box 2569  
 City / State / Zip GJ CO 81502  
 Telephone 970-245-9271

**\*TYPE OF HOME PROPOSED:**

- Site Built  Manufactured Home (UBC)
- Manufactured Home (HUD)
- Other (please specify): \_\_\_\_\_

NOTES: \_\_\_\_\_

**REQUIRED: One plot plan, on 8 1/2" x 11" paper, showing all existing & proposed structure location(s), parking, setbacks to all property lines, ingress/egress to the property, driveway location & width & all easements & rights-of-way which abut the parcel.**

THIS SECTION TO BE COMPLETED BY COMMUNITY DEVELOPMENT DEPARTMENT STAFF	
ZONE <u>R-8</u>	Maximum coverage of lot by structures <u>70%</u>
SETBACKS: Front <u>20</u> from property line (PL)	Permanent Foundation Required: YES <input checked="" type="checkbox"/> NO <input type="checkbox"/>
Side <u>5</u> from PL Rear <u>10</u> from PL	Parking Requirement <u>2</u>
Maximum Height of Structure(s) <u>35'</u>	Special Conditions _____
Voting District <u>C</u>	Driveway Location Approval <u>JAR</u> (Engineer's Initials)

Modifications to this Planning Clearance must be approved, in writing, by the Community Development Department. The structure authorized by this application cannot be occupied until a final inspection has been completed and a Certificate of Occupancy has been issued, if applicable, by the Building Department (Section 305, Uniform Building Code).

I hereby acknowledge that I have read this application and the information is correct; I agree to comply with any and all codes, ordinances, laws, regulations or restrictions which apply to the project. I understand that failure to comply shall result in legal action, which may include but not necessarily be limited to non-use of the building(s).


Applicant Signature [Signature] Date 3-MAY-2007  
 Department Approval [Signature] Date \_\_\_\_\_

Additional water and/or sewer tap fee(s) are required: YES <input checked="" type="checkbox"/> NO <input type="checkbox"/>	W/O No. <u>20271</u>
Utility Accounting <u>[Signature]</u>	Date <u>5/15/07</u>

VALID FOR SIX MONTHS FROM DATE OF ISSUANCE (Section 2.2.C.1 Grand Junction Zoning & Development Code)  
 (White: Planning) (Yellow: Customer) (Pink: Building Department) (Goldenrod: Utility Accounting)



29-1/2 ROAD

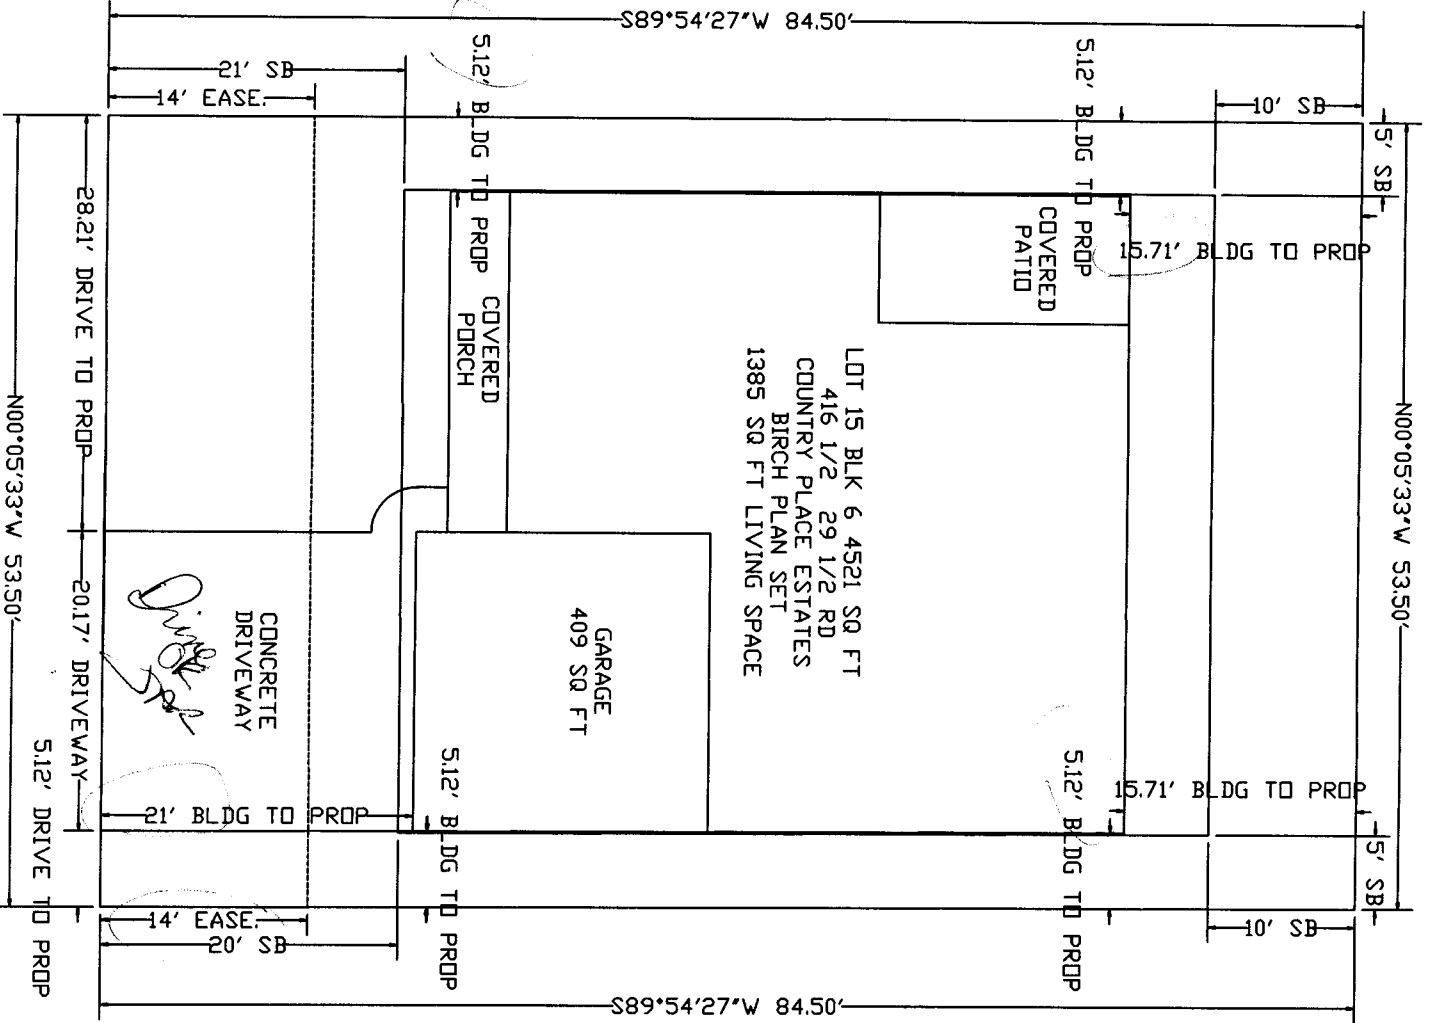

*For Wendy Street*

DRAWN BY: FILE NAME: LOT 15 BLK 6 DATE: SHEET:	TML ENTERPRISES INC. IS THE SOLE OWNER OF THIS SET OF PLANS. ANY USE OR REPRODUCTION OF THESE PLANS WITHOUT WRITTEN PERMISSION IS EXPRESSLY PROHIBITED UNDER COPYRIGHT LAWS. ILLEGAL USERS OF THESE PLANS WILL BE PROSECUTED TO THE FULL EXTENT OF THE LAW.	<b>TML ENTERPRISES</b> PO BOX 2569 GRAND JUNCTION CO. 81502 (970) 245-9271		<b>BIRCH</b> 416-1/2 29-1/2 ROAD GRAND JUNCTION, CO	REVISIONS
					DATE
					BY