

FEE \$	10.00
TCP \$	1589.00
SIF \$	460.00

PLANNING CLEARANCE

(Single Family Residential and Accessory Structures)
Community Development Department

BLDG PERMIT NO. _____

P

Building Address 469 BISMARCK ST
 Parcel No. 2943-161-28-002
 Subdivision DAKOTA WEST
 Filing 2 Block 1 Lot 2

No. of Existing Bldgs 0 No. Proposed 1
 Sq. Ft. of Existing Bldgs 0 Sq. Ft. Proposed 2701
 Sq. Ft. of Lot / Parcel 9595
 Sq. Ft. Coverage of Lot by Structures & Impervious Surface (Total Existing & Proposed) 4095.58
 Height of Proposed Structure 18'

OWNER INFORMATION:

Name AUSTIN & AUGUSTA DESIGN
 Address 2441 BELLA PAGO DR.
 City / State / Zip GRAND JUNCTION, CO 81503

DESCRIPTION OF WORK & INTENDED USE:
 New Single Family Home (*check type below)
 Interior Remodel Addition
 Other (please specify): _____

APPLICANT INFORMATION:

Name AUSTIN & AUGUSTA DESIGN
 Address 2441 BELLA PAGO DR.
 City / State / Zip GJ, CO 81503
 Telephone (970) 248-1985

*TYPE OF HOME PROPOSED:
 Site Built Manufactured Home (UBC)
 Manufactured Home (HUD)
 Other (please specify): _____

NOTES: _____

REQUIRED: One plot plan, on 8 1/2" x 11" paper, showing all existing & proposed structure location(s), parking, setbacks to all property lines, ingress/egress to the property, driveway location & width & all easements & rights-of-way which abut the parcel.

THIS SECTION TO BE COMPLETED BY COMMUNITY DEVELOPMENT DEPARTMENT STAFF	
ZONE <u>R-5</u>	Maximum coverage of lot by structures <u>60%</u>
SETBACKS: Front <u>20</u> from property line (PL)	Permanent Foundation Required: YES <input checked="" type="checkbox"/> NO <input type="checkbox"/>
Side <u>5</u> from PL Rear <u>25</u> from PL	Parking Requirement <u>2</u>
Maximum Height of Structure(s) <u>35</u>	Special Conditions <u>foundation observation</u>
Voting District <u>C</u> Driveway Location Approval <u>JAR</u> (Engineer's Initials)	<u>report by licensed engineer required see note on site plan</u>

Modifications to this Planning Clearance must be approved, in writing, by the Community Development Department. The structure authorized by this application cannot be occupied until a final inspection has been completed and a Certificate of Occupancy has been issued, if applicable, by the Building Department (Section 305, Uniform Building Code).

I hereby acknowledge that I have read this application and the information is correct; I agree to comply with any and all codes, ordinances, laws, regulations or restrictions which apply to the project. I understand that failure to comply shall result in legal action, which may include but not necessarily be limited to non-use of the building(s).


Applicant Signature [Signature] Date 7-16-07
 Department Approval [Signature] Date _____

Additional water and/or sewer tap fee(s) are required:	YES	NO	W/O No. <u>20449</u>
Utility Accounting <u>[Signature]</u>	Date <u>7/16/7</u>		


VALID FOR SIX MONTHS FROM DATE OF ISSUANCE (Section 2.2.C.1 Grand Junction Zoning & Development Code)
 (White: Planning) (Yellow: Customer) (Pink: Building Department) (Goldenrod: Utility Accounting)

469 Bismarck Street

JAR Wendy Spive
 CHECK FOR EASEMENTS AND EASEMENT RECORDS MUST BE
 LOCATED AND IDENTIFY EASEMENTS
 AND PROPERTY LINES

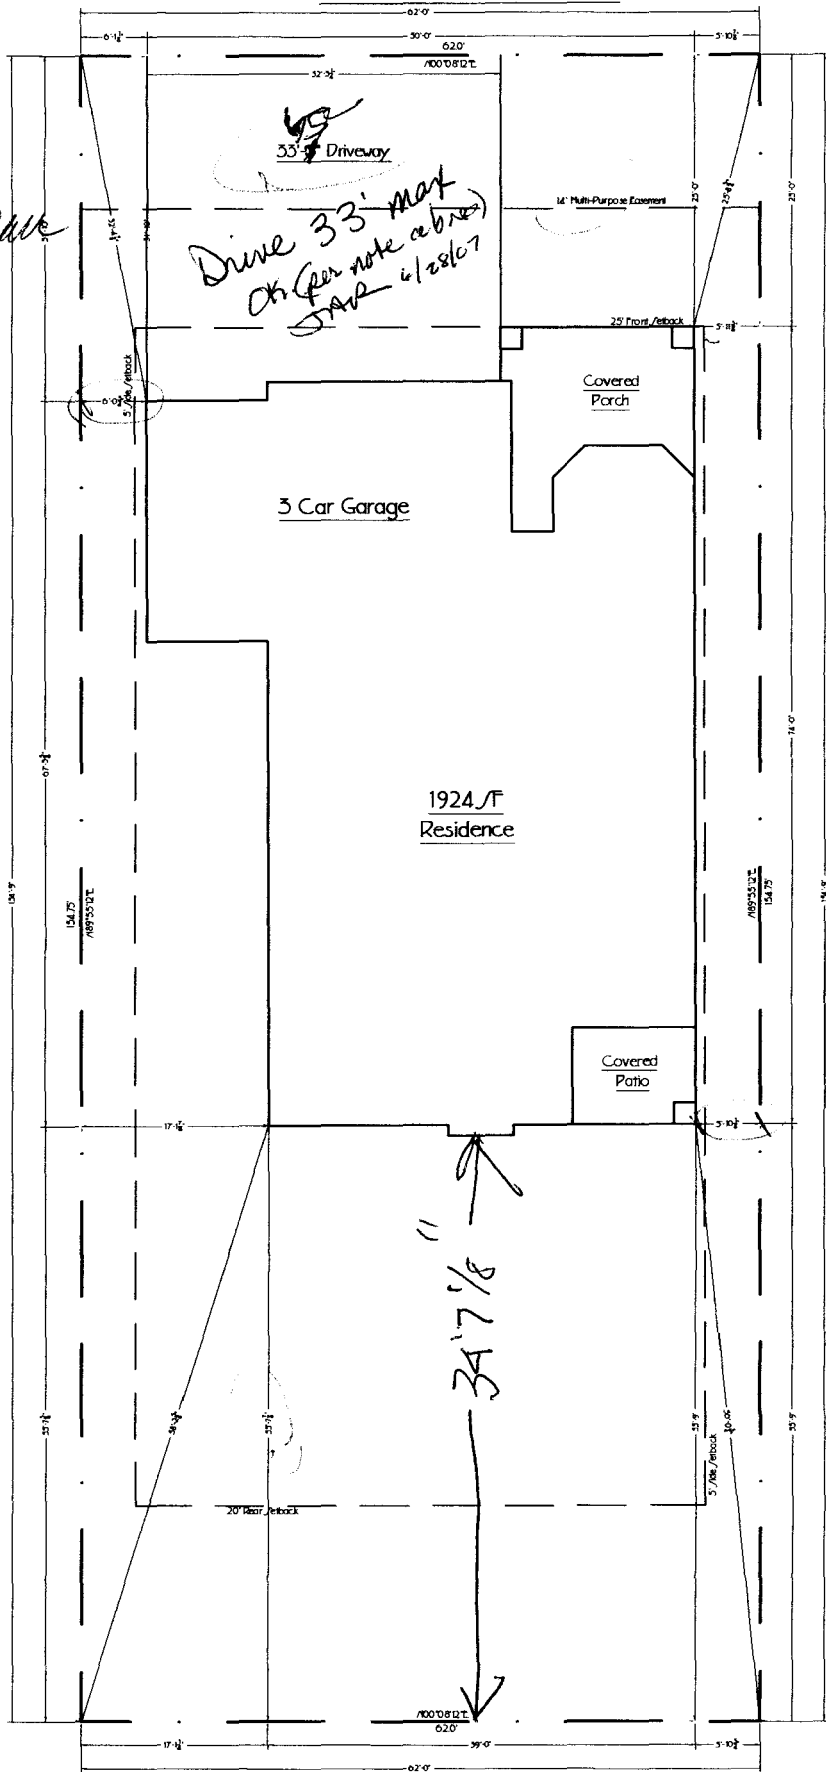

Lot Information	
Lot #	2
Block #	1
Address	469 Bismarck Street
Lot / F.	9595 / F
Acres	---
Subdivision	Dakota West / subdivision Phase II
Parcel #	---

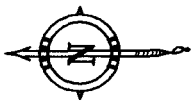

SITE PLAN

SCALE: A.T.S.