

FEE \$ <u>10.00</u>
TCP \$
SIF \$

**PLANNING CLEARANCE**  
 (Single Family Residential and Accessory Structures)  
Community Development Department

BLDG PERMIT NO. \_\_\_\_\_

Building Address 2620 Bookcliff  
 Parcel No. 2945-121-09-004  
 Subdivision Melrose Est  
 Filing \_\_\_\_\_ Block 2 Lot 3

No. of Existing Bldgs \_\_\_\_\_ No. Proposed \_\_\_\_\_  
 Sq. Ft. of Existing Bldgs \_\_\_\_\_ Sq. Ft. Proposed \_\_\_\_\_  
 Sq. Ft. of Lot / Parcel \_\_\_\_\_  
 Sq. Ft. Coverage of Lot by Structures & Impervious Surface  
 (Total Existing & Proposed) \_\_\_\_\_  
 Height of Proposed Structure \_\_\_\_\_

**OWNER INFORMATION:**

Name Emerson & Jennifer Hill  
 Address 2620 Bookcliff Ave  
 City / State / Zip Grand Junction CO 81501

**DESCRIPTION OF WORK & INTENDED USE:**

New Single Family Home (\*check type below)  
 Interior Remodel  Addition  
 Other (please specify): Shed

**APPLICANT INFORMATION:**

Name Emerson & Jennifer Hill  
 Address 2620 Bookcliff Ave  
 City / State / Zip Grand Junction CO 81501  
 Telephone 256-1997

**\*TYPE OF HOME PROPOSED:**

Site Built  Manufactured Home (UBC)  
 Manufactured Home (HUD)  
 Other (please specify): \_\_\_\_\_

NOTES: \_\_\_\_\_

**REQUIRED: One plot plan, on 8 1/2" x 11" paper, showing all existing & proposed structure location(s), parking, setbacks to all property lines, ingress/egress to the property, driveway location & width & all easements & rights-of-way which abut the parcel.**

THIS SECTION TO BE COMPLETED BY COMMUNITY DEVELOPMENT DEPARTMENT STAFF			
ZONE <u>RMF-8</u>	Maximum coverage of lot by structures _____		
SETBACKS: Front <u>20</u> from property line (PL)	Permanent Foundation Required: YES _____ NO _____		
Side _____ from PL Rear _____ from PL	Parking Requirement _____		
Maximum Height of Structure(s) _____	Special Conditions _____		
Voting District _____	Driveway Location Approval _____ (Engineer's Initials)		


Modifications to this Planning Clearance must be approved, in writing, by the Community Development Department. The structure authorized by this application cannot be occupied until a final inspection has been completed and a Certificate of Occupancy has been issued, if applicable, by the Building Department (Section 305, Uniform Building Code).

I hereby acknowledge that I have read this application and the information is correct; I agree to comply with any and all codes, ordinances, laws, regulations or restrictions which apply to the project. I understand that failure to comply shall result in legal action, which may include but not necessarily be limited to non-use of the building(s).

Applicant Signature [Signature] Date 4-12-07  
 Department Approval [Signature] Date 4/12/07

Additional water and/or sewer tap fee(s) are required:	YES	NO <input checked="" type="checkbox"/>	W/O No. _____
Utility Accounting <u>[Signature]</u>	Date <u>4/12/07</u>		


VALID FOR SIX MONTHS FROM DATE OF ISSUANCE (Section 2.2.C.1 Grand Junction Zoning & Development Code)  
 (White: Planning) (Yellow: Customer) (Pink: Building Department) (Goldenrod: Utility Accounting)

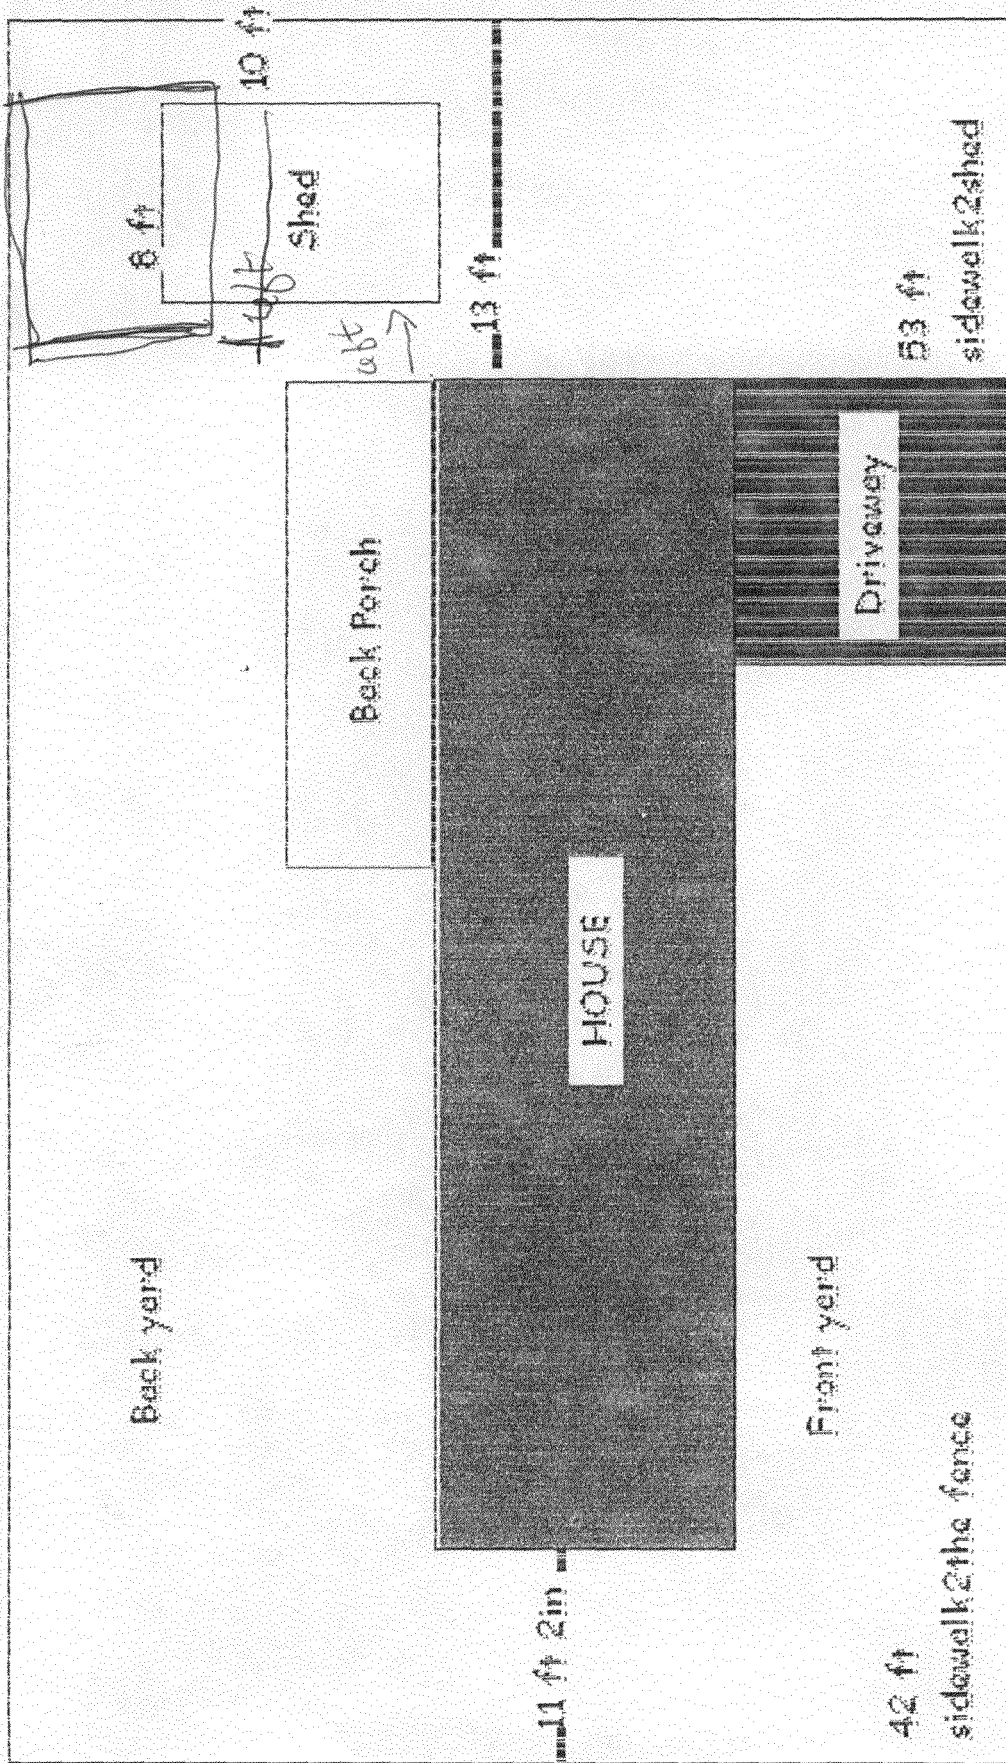

We will allow 4 ft from the backside of the shed to the property line and 1 ft from the front of the shed to our home.



# 2620 Bookcliff

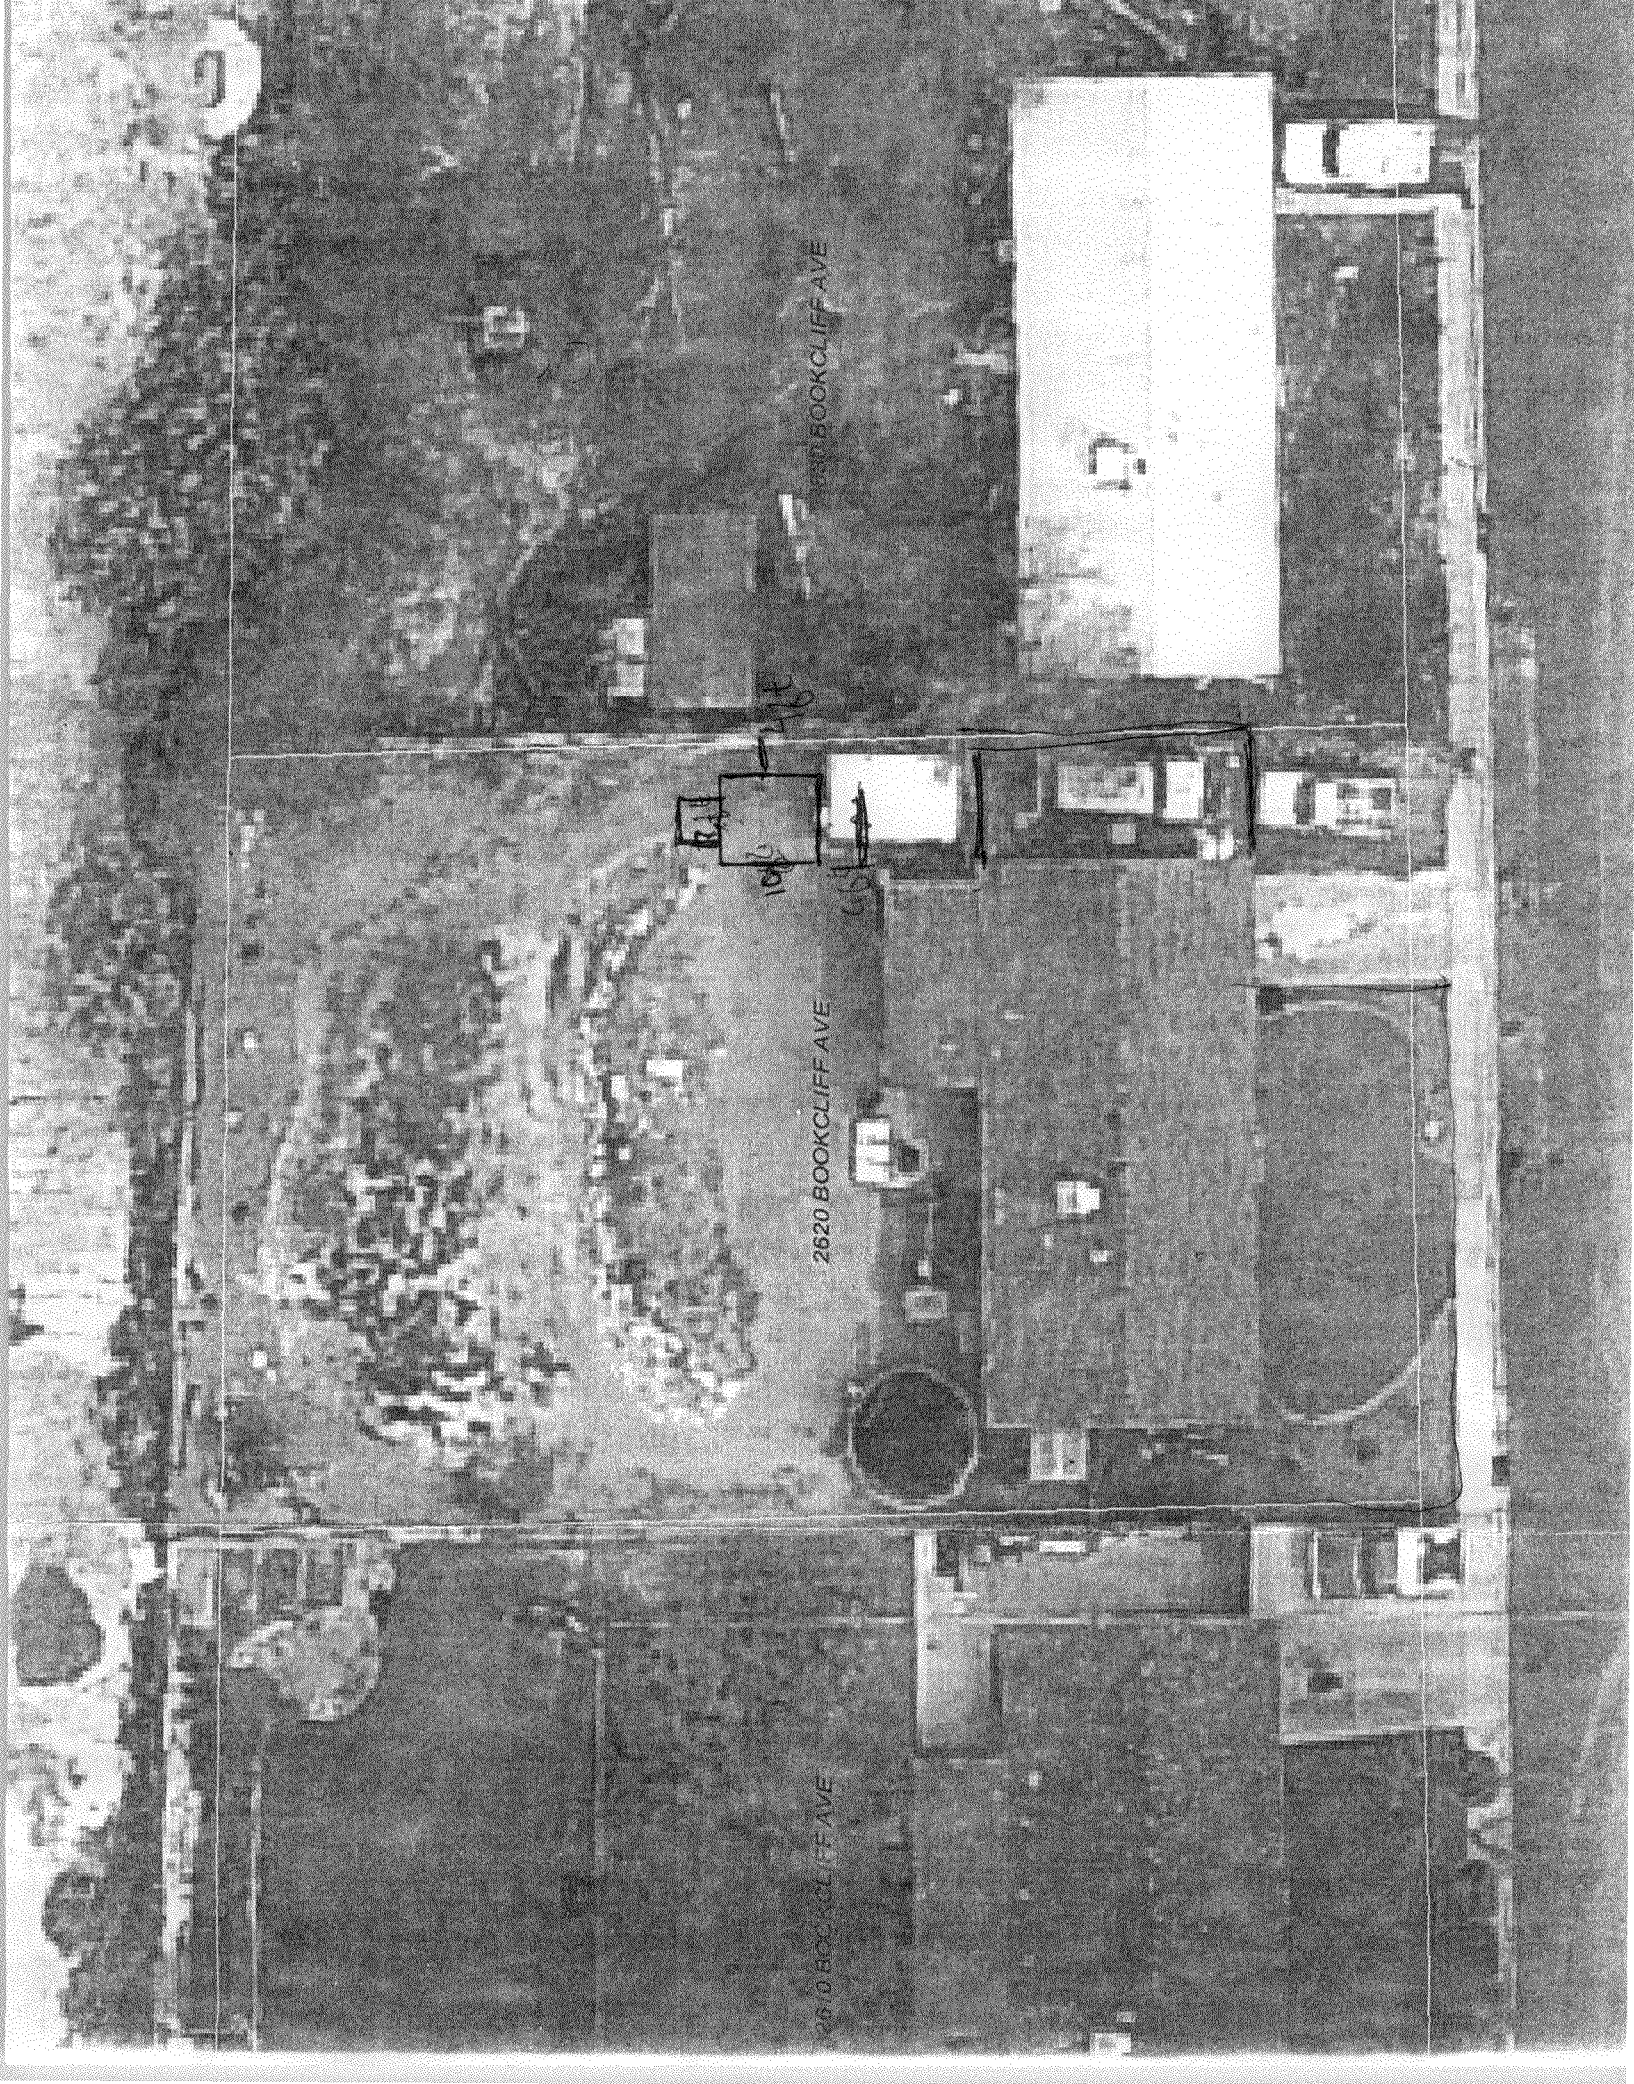

## LEGEND

- Hospitals
- Parks Stations
- Fire Stations
- Schools
- State Highways
- Roads
- Levees
- Canals
- Colorado National Monument
- BLM Special Areas
- State Acquisition
- BLM
- National Forest



**DISCLAIMER:** The Geographic Information System (GIS) and its components are designed as a source of reference for answering inquiries, for planning and for modeling. GIS is not intended or does not replace legal description information in the chain of title and other information contained in official government records such as the County Clerk and Recorder's office or the courts. In addition, the representations of locations in this GIS cannot be substituted for actual legal surveys.

Mesa County GIS  
 544 Rood Ave.  
 Grand Junction, CO 81501

CHANGE OF SETBACKS MUST BE APPROVED BY THE CITY PLANNING DEPT. IT IS THE APPLICANT'S RESPONSIBILITY TO PROPERLY LOCATE AND IDENTIFY EASEMENTS AND PROPERTY LINES.