

FEE \$	10.00
TCP \$	1589.00
SIF \$	460.00

**PLANNING CLEARANCE**  
 (Single Family Residential and Accessory Structures)  
**Community Development Department**

BLDG PERMIT NO. \_\_\_\_\_

Building Address 2458 Brockwillan Loop  
 Parcel No. 2945-041-27-040  
 Subdivision Brockwillan  
 Filing 1 Block \_\_\_\_\_ Lot 40

No. of Existing Bldgs 0 No. Proposed 1  
 Sq. Ft. of Existing Bldgs N/A Sq. Ft. Proposed 1088  
 Sq. Ft. of Lot / Parcel 1214  
 Sq. Ft. Coverage of Lot by Structures & Impervious Surface (Total Existing & Proposed) \_\_\_\_\_  
 Height of Proposed Structure \_\_\_\_\_

**OWNER INFORMATION:**

Name Parte  
 Address 786 Valley Ct.  
 City / State / Zip GS CO 81505

DESCRIPTION OF WORK & INTENDED USE:  
 New Single Family Home (\*check type below)  
 Interior Remodel  Addition  
 Other (please specify): \_\_\_\_\_

**APPLICANT INFORMATION:**

Name Grace Hanes  
 Address 786 Valley Ct.  
 City / State / Zip GS CO 81505  
 Telephone 248-8522

\*TYPE OF HOME PROPOSED:  
 Site Built  Manufactured Home (UBC)  
 Manufactured Home (HUD)  
 Other (please specify): \_\_\_\_\_

NOTES: G-Plex

**REQUIRED: One plot plan, on 8 1/2" x 11" paper, showing all existing & proposed structure location(s), parking, setbacks to all property lines, ingress/egress to the property, driveway location & width & all easements & rights-of-way which abut the parcel.**

THIS SECTION TO BE COMPLETED BY COMMUNITY DEVELOPMENT DEPARTMENT STAFF			
ZONE <u>PP</u>	Maximum coverage of lot by structures <u>per plan</u>		
SETBACKS: Front <u>20' per plan</u> from property line (PL)	Permanent Foundation Required: YES <u>X</u> NO _____		
Side _____ from PL Rear _____ from PL	Parking Requirement <u>2</u>		
Maximum Height of Structure(s) <u>per plan</u>	Special Conditions <u>see 12/19/06 site plan;</u>		
Voting District <u>B</u>	Driveway Location Approval <u>JAR</u> (Engineer's Initials)	<u>FPP-2005-144</u>	

Modifications to this Planning Clearance must be approved, in writing, by the Community Development Department. The structure authorized by this application cannot be occupied until a final inspection has been completed and a Certificate of Occupancy has been issued, if applicable, by the Building Department (Section 305, Uniform Building Code).

I hereby acknowledge that I have read this application and the information is correct; I agree to comply with any and all codes, ordinances, laws, regulations or restrictions which apply to the project. I understand that failure to comply shall result in legal action, which may include but not necessarily be limited to non-use of the building(s).


Applicant Signature [Signature] Date 5/2/07  
 Department Approval JAR [Signature] Date 5-2-07

Additional water and/or sewer tap fee(s) are required:	YES <input checked="" type="checkbox"/>	NO <input type="checkbox"/>	W/O No. <u>20206</u>
Utility Accounting <u>[Signature]</u>	Date <u>5-2-07</u>		

VALID FOR SIX MONTHS FROM DATE OF ISSUANCE (Section 2.2.C.1 Grand Junction Zoning & Development Code)  
 (White: Planning) (Yellow: Customer) (Pink: Building Department) (Goldenrod: Utility Accounting)

2458 Brookwillow Loop

*Done OK*

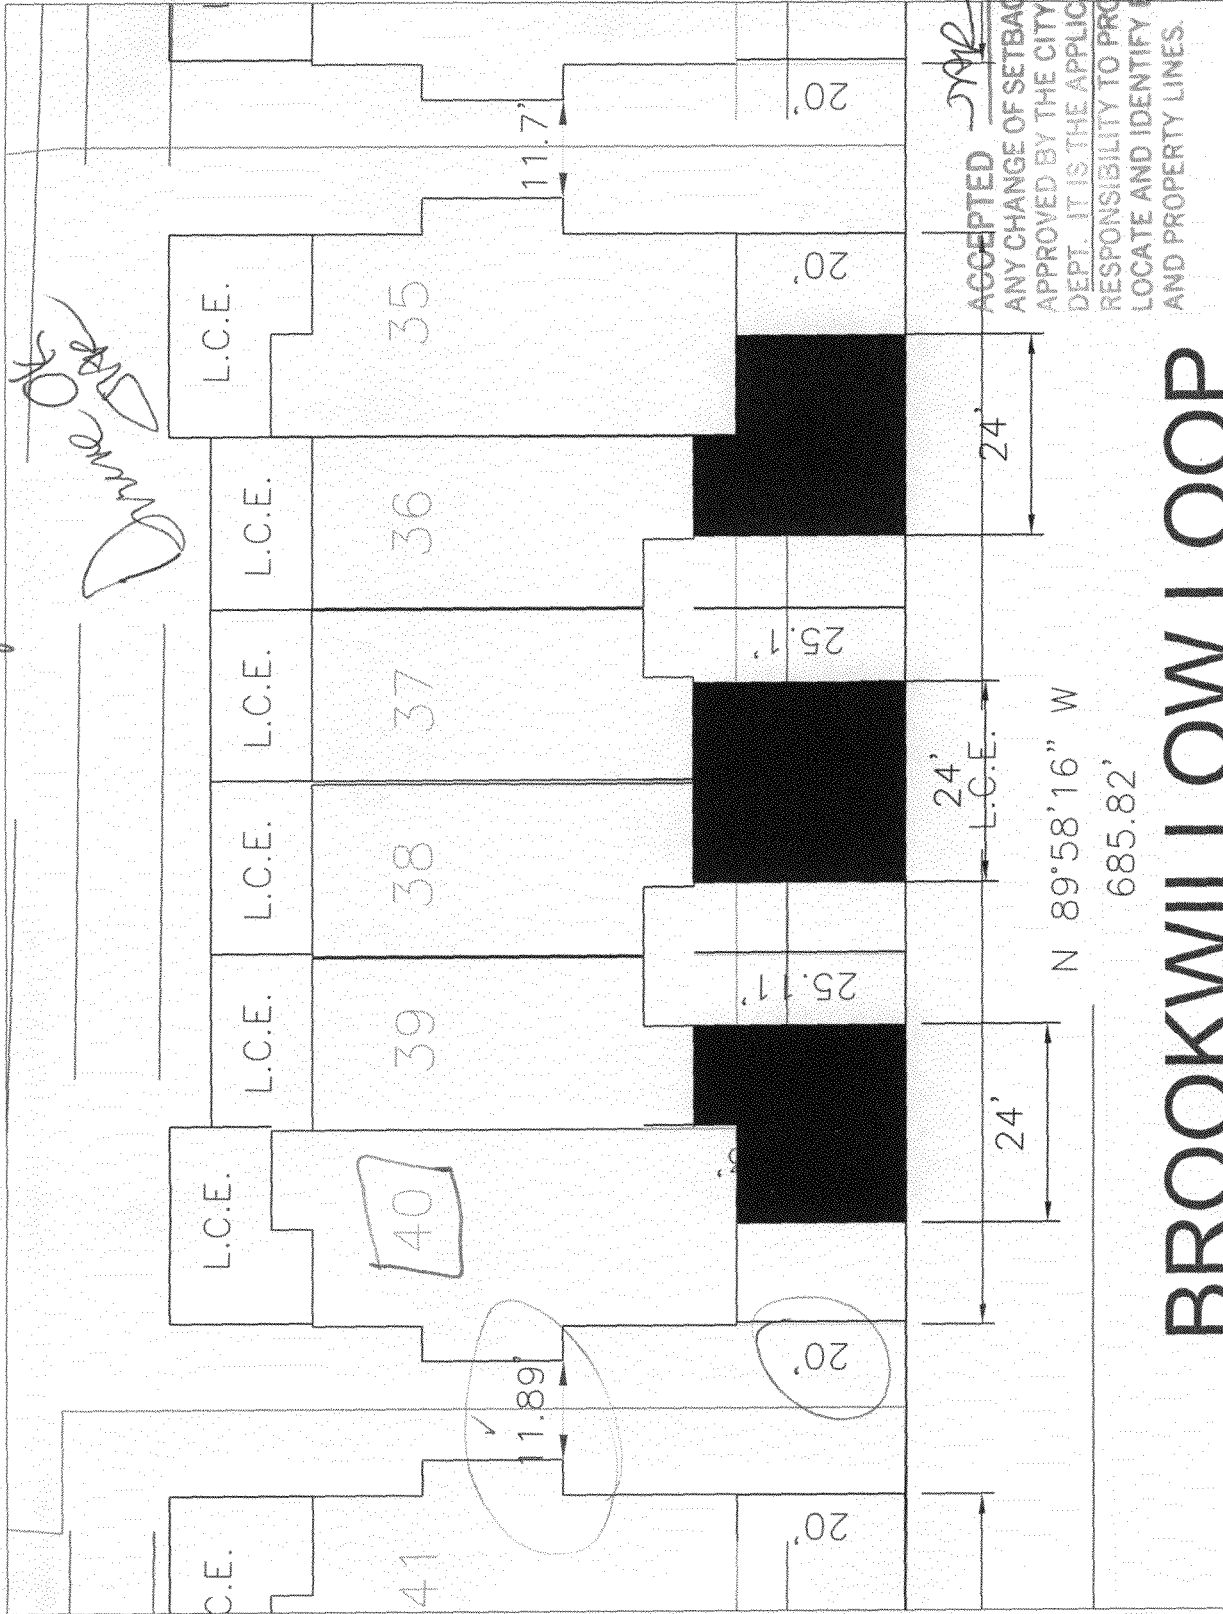

*5-2-07  
Berkman  
Berkman*

ACCEPTED *MAP*

ANY CHANGE OF SETBACKS MUST BE APPROVED BY THE CITY PLANNING DEPT. IT IS THE APPLICANTS RESPONSIBILITY TO PROPERLY LOCATE AND IDENTIFY EASEMENTS AND PROPERTY LINES.

**BROOKWILLOW LOOP**