

FEE \$ 10.00  
 TCP \$ 1589.00  
 SIF \$ 460.00

**PLANNING CLEARANCE**  
 (Single Family Residential and Accessory Structures)  
Community Development Department

BLDG PERMIT NO. \_\_\_\_\_

Building Address 2464 Brookwillow Loop  
 Parcel No. 2945-041-27-034  
 Subdivision Brookwillow  
 Filing 1 Block \_\_\_\_\_ Lot 34

No. of Existing Bldgs 0 No. Proposed 1  
 Sq. Ft. of Existing Bldgs N/A Sq. Ft. Proposed 1088  
 Sq. Ft. of Lot / Parcel 1214  
 Sq. Ft. Coverage of Lot by Structures & Impervious Surface  
 (Total Existing & Proposed) \_\_\_\_\_  
 Height of Proposed Structure \_\_\_\_\_

**OWNER INFORMATION:**

Name Dartor LLC  
 Address 786 Valley Ct.  
 City / State / Zip GJ CO 81505

DESCRIPTION OF WORK & INTENDED USE:  
 New Single Family Home (\*check type below)  
 Interior Remodel  Addition  
 Other (please specify): \_\_\_\_\_

**APPLICANT INFORMATION:**

Name Grace Homes  
 Address 786 Valley Ct.  
 City / State / Zip GJ CO 81505  
 Telephone 248-8522

\*TYPE OF HOME PROPOSED:  
 Site Built  Manufactured Home (UBC)  
 Manufactured Home (HUD)  
 Other (please specify): \_\_\_\_\_

NOTES: 8-Plex

**REQUIRED: One plot plan, on 8 1/2" x 11" paper, showing all existing & proposed structure location(s), parking, setbacks to all property lines, ingress/egress to the property, driveway location & width & all easements & rights-of-way which abut the parcel.**

THIS SECTION TO BE COMPLETED BY COMMUNITY DEVELOPMENT DEPARTMENT STAFF			
ZONE <u>PD</u>	Maximum coverage of lot by structures <u>plan</u>		
SETBACKS: Front <u>20' per plan</u> from property line (PL)	Permanent Foundation Required: YES <u>X</u> NO _____		
Side _____ from PL <u>per plan</u> Rear _____ from PL	Parking Requirement <u>plan</u>		
Maximum Height of Structure(s) <u>plan</u>	Special Conditions _____		
Voting District <u>B</u>	Driveway Location Approval <u>JAR</u>		
	(Engineer's Initials)		

Modifications to this Planning Clearance must be approved, in writing, by the Community Development Department. The structure authorized by this application cannot be occupied until a final inspection has been completed and a Certificate of Occupancy has been issued, if applicable, by the Building Department (Section 305, Uniform Building Code).


I hereby acknowledge that I have read this application and the information is correct; I agree to comply with any and all codes, ordinances, laws, regulations or restrictions which apply to the project. I understand that failure to comply shall result in legal action, which may include but not necessarily be limited to non-use of the building(s).

Applicant Signature Lee Kallington - Agent Date 2/26/07  
 Department Approval JAR Ullstein Oregon Date 4/20/07

Additional water and/or sewer tap fee(s) are required:	YES <input checked="" type="checkbox"/>	NO <input type="checkbox"/>	W/O No. <u>20164</u>
Utility Accounting <u>Kate...</u>	Date <u>4/20/07</u>		

VALID FOR SIX MONTHS FROM DATE OF ISSUANCE (Section 2.2.C.1 Grand Junction Zoning & Development Code)  
 (White: Planning) (Yellow: Customer) (Pink: Building Department) (Goldenrod: Utility Accounting)

2464 Brookvilow Loop

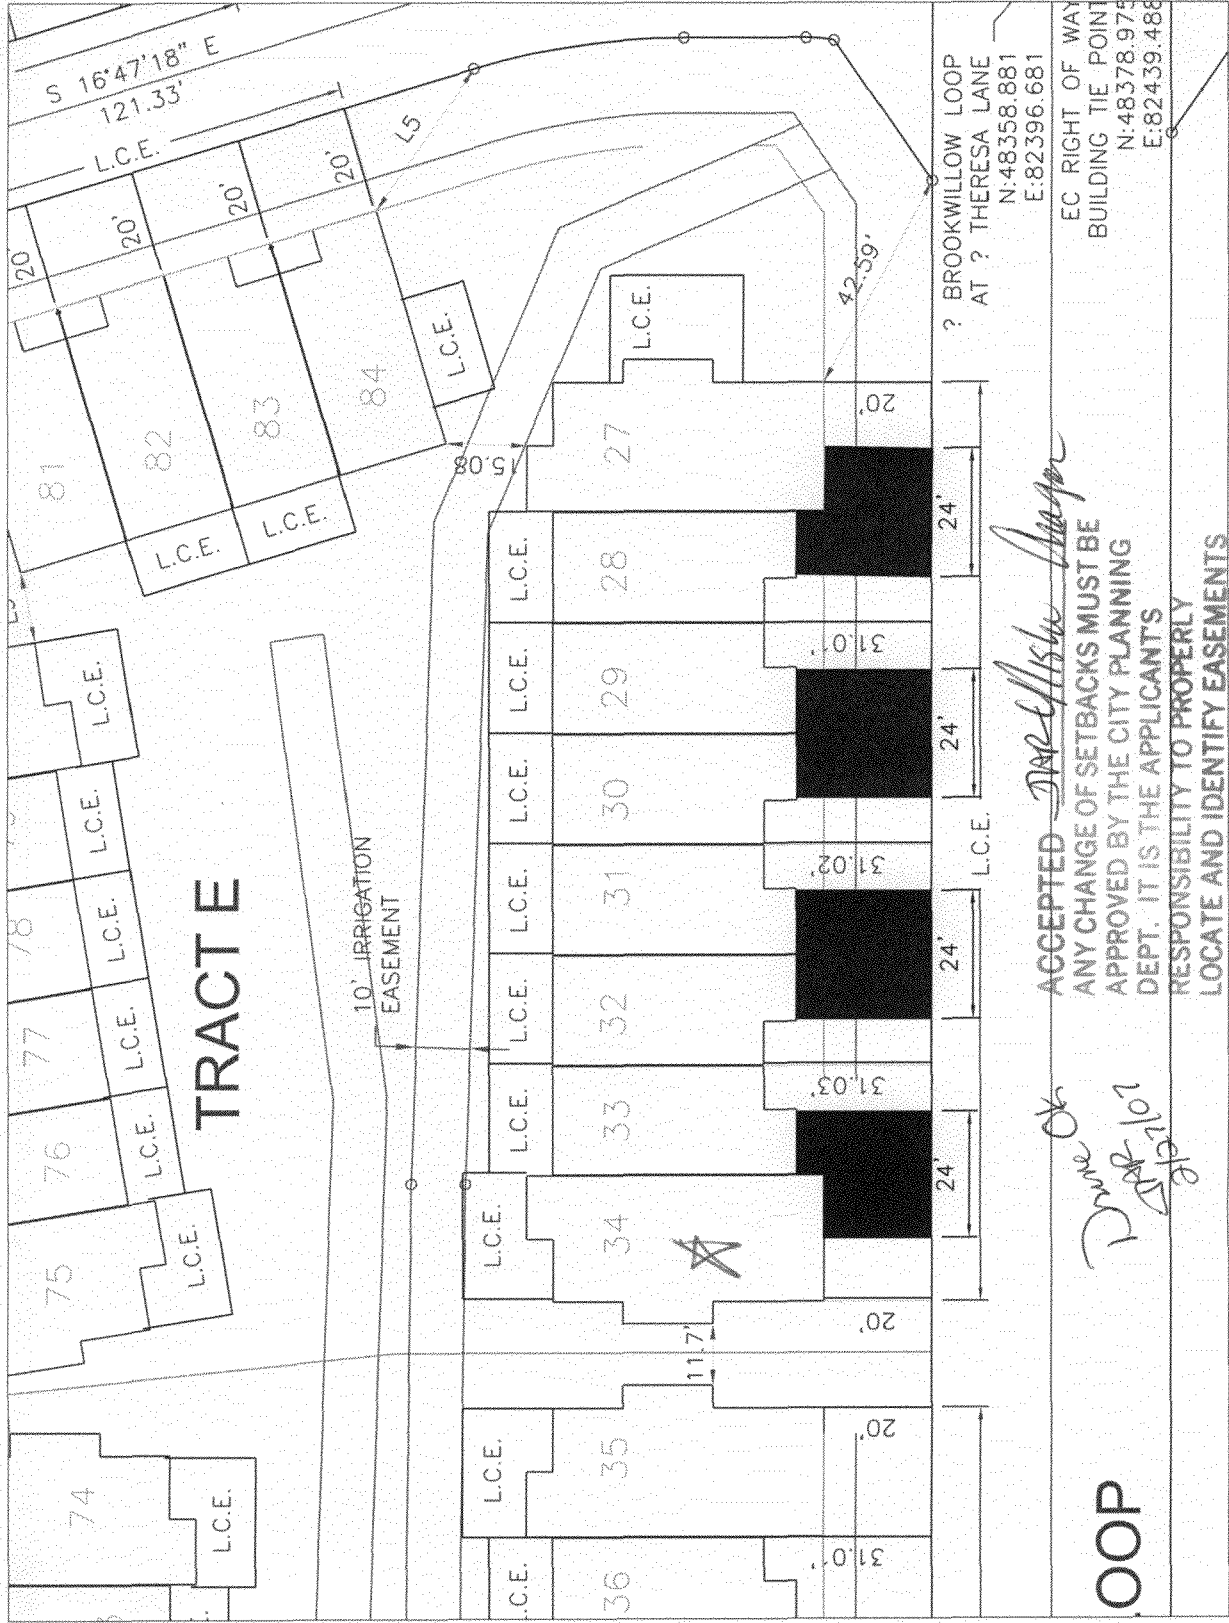

? BROOKWILLOW LOOP  
 AT ? THERESA LANE  
 N:48358.881  
 E:82396.681

EC RIGHT OF WAY  
 BUILDING TIE POINT  
 N:48378.975  
 E:82439.488

ACCEPTED *Dorellishu Anjan*  
 ANY CHANGE OF SETBACKS MUST BE  
 APPROVED BY THE CITY PLANNING  
 DEPT. IT IS THE APPLICANTS  
 RESPONSIBILITY TO PROPERLY  
 LOCATE AND IDENTIFY EASEMENTS  
 AND PROPERTY LINES.

*Dorellishu Anjan*  
*10/12/16*

OOP