

FEE \$	10.00
TCP \$	1589.00
SIF \$	460.00

PLANNING CLEARANCE
 (Single Family Residential and Accessory Structures)
Community Development Department

BLDG PERMIT NO. _____

Building Address 2468 Brookwillow Loop
 Parcel No. 2945-041-27-030
 Subdivision Brookwillow
 Filing 1 Block _____ Lot 30

No. of Existing Bldgs 0 No. Proposed 1
 Sq. Ft. of Existing Bldgs NA Sq. Ft. Proposed 1365
 Sq. Ft. of Lot / Parcel 879
 Sq. Ft. Coverage of Lot by Structures & Impervious Surface (Total Existing & Proposed) _____
 Height of Proposed Structure _____

OWNER INFORMATION:

Name Dexter
 Address 786 Valley Ct.
 City / State / Zip G.J CO 81505

DESCRIPTION OF WORK & INTENDED USE:

New Single Family Home (*check type below)
 Interior Remodel Addition
 Other (please specify): _____

APPLICANT INFORMATION:

Name Grace Hans
 Address 786 Valley Ct.
 City / State / Zip G.J CO 81505
 Telephone 248-8522

***TYPE OF HOME PROPOSED:**

Site Built Manufactured Home (UBC)
 Manufactured Home (HUD)
 Other (please specify): _____

NOTES: 5-Plex

REQUIRED: One plot plan, on 8 1/2" x 11" paper, showing all existing & proposed structure location(s), parking, setbacks to all property lines, ingress/egress to the property, driveway location & width & all easements & rights-of-way which abut the parcel.

THIS SECTION TO BE COMPLETED BY COMMUNITY DEVELOPMENT DEPARTMENT STAFF			
ZONE <u>PD</u>	Maximum coverage of lot by structures <u>plan</u>		
SETBACKS: Front <u>20'</u> ^{see plan} from property line (PL)	Permanent Foundation Required: YES <u>X</u> NO _____		
Side _____ from PL ^{see plan} Rear _____ from PL	Parking Requirement <u>plan</u>		
Maximum Height of Structure(s) <u>plan</u>	Special Conditions _____		
Voting District <u>B</u>	Driveway Location Approval <u>JPK</u> (Engineer's Initials)		

Modifications to this Planning Clearance must be approved, in writing, by the Community Development Department. The structure authorized by this application cannot be occupied until a final inspection has been completed and a Certificate of Occupancy has been issued, if applicable, by the Building Department (Section 305, Uniform Building Code).

I hereby acknowledge that I have read this application and the information is correct; I agree to comply with any and all codes, ordinances, laws, regulations or restrictions which apply to the project. I understand that failure to comply shall result in legal action, which may include but not necessarily be limited to non-use of the building(s).


Applicant Signature [Signature] - Agent Date 2/26/07
 Department Approval [Signature] Date 4/26/07

Additional water and/or sewer tap fee(s) are required:	YES <input checked="" type="checkbox"/>	NO <input type="checkbox"/>	W/O No. <u>201163</u>
Utility Accounting <u>Kate Cervenky</u>	Date <u>4/20/07</u>		

VALID FOR SIX MONTHS FROM DATE OF ISSUANCE (Section 2.2.C.1 Grand Junction Zoning & Development Code)
 (White: Planning) (Yellow: Customer) (Pink: Building Department) (Goldenrod: Utility Accounting)

03/26/07 06

2468 Brookwillow Loop

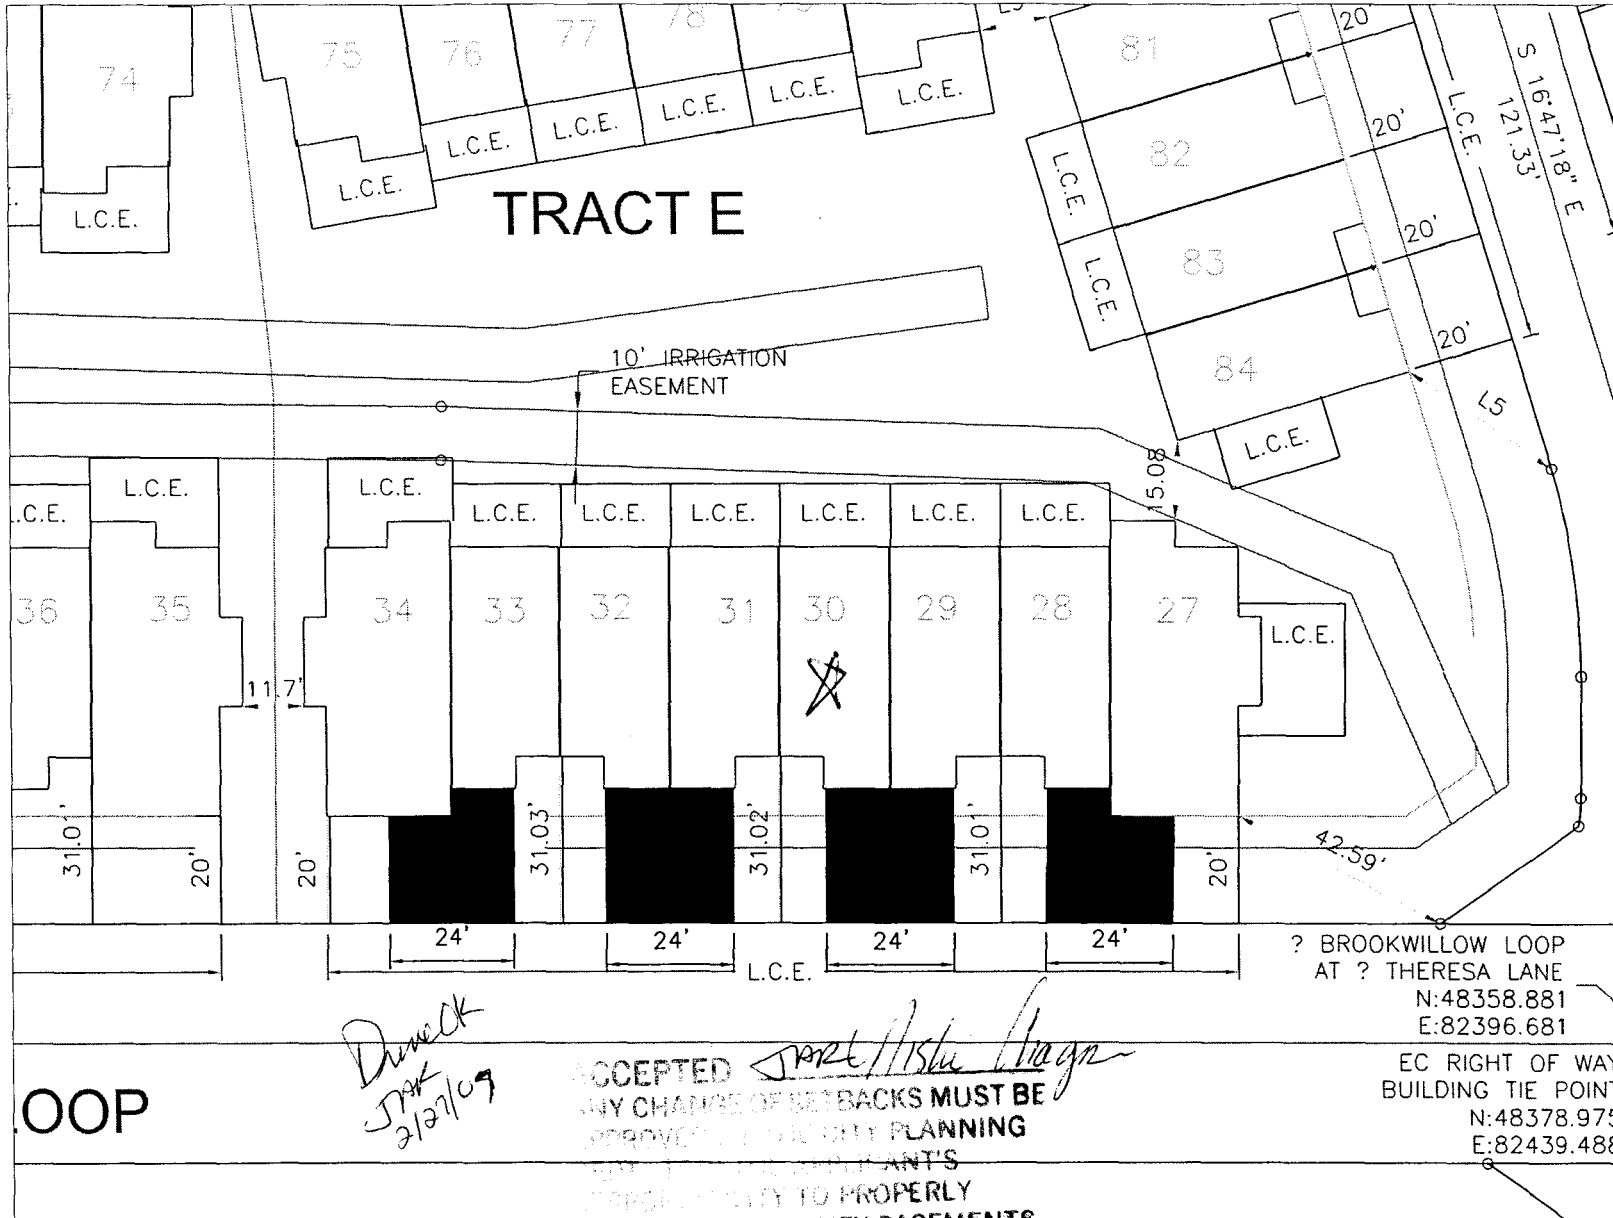

OOP

Doneck
JAK
2/27/09

ACCEPTED *[Signature]*
 ANY CHANGE OF SETBACKS MUST BE
 APPROVED BY THE CITY PLANNING
 DEPARTMENT'S
 RESPONSIBILITY TO PROPERLY
 LOCATE AND IDENTIFY EASEMENTS
 AND PROPERTY LINES

? BROOKWILLOW LOOP
 AT ? THERESA LANE
 N:48358.881
 E:82396.681

EC RIGHT OF WAY
 BUILDING TIE POINT
 N:48378.975
 E:82439.488