

FEE \$	10.00
TCP \$	1589.00
SIF \$	460.00

PLANNING CLEARANCE
 (Single Family Residential and Accessory Structures)
Community Development Department

BLDG PERMIT NO. _____

Building Address 7458 1/2 Brookwillow Loop
 Parcel No. 2945-041-27-839
 Subdivision Brookwillow
 Filing 1 Block _____ Lot 39

No. of Existing Bldgs 0 No. Proposed 1
 Sq. Ft. of Existing Bldgs 0 Sq. Ft. Proposed 1365
 Sq. Ft. of Lot / Parcel 879
 Sq. Ft. Coverage of Lot by Structures & Impervious Surface (Total Existing & Proposed) _____
 Height of Proposed Structure _____

OWNER INFORMATION:

Name Darter
 Address 786 Valley Ct.
 City / State / Zip Gr J CO 81505

DESCRIPTION OF WORK & INTENDED USE:
 New Single Family Home (*check type below)
 Interior Remodel Addition
 Other (please specify): _____

APPLICANT INFORMATION:

Name Grace Houns
 Address 786 Valley Ct.
 City / State / Zip Gr J CO 81505
 Telephone 748-8522

*TYPE OF HOME PROPOSED:
 Site Built Manufactured Home (UBC)
 Manufactured Home (HUD)
 Other (please specify): _____

NOTES: 6-Plex

REQUIRED: One plot plan, on 8 1/2" x 11" paper, showing all existing & proposed structure location(s), parking, setbacks to all property lines, ingress/egress to the property, driveway location & width & all easements & rights-of-way which abut the parcel.

THIS SECTION TO BE COMPLETED BY COMMUNITY DEVELOPMENT DEPARTMENT STAFF			
ZONE <u>PD</u>	Maximum coverage of lot by structures <u>per plan</u>		
SETBACKS: Front <u>20'</u> <u>per plan</u> from property line (PL)	Permanent Foundation Required: YES <u>X</u> NO _____		
Side _____ from PL Rear _____ from PL	Parking Requirement <u>2</u>		
Maximum Height of Structure(s) <u>per plan</u>	Special Conditions <u>see 12/19/06 site plan;</u>		
Voting District <u>B</u>	Driveway Location Approval <u>JRR</u> (Engineer's Initials)	<u>FPP-2005-144</u>	

Modifications to this Planning Clearance must be approved, in writing, by the Community Development Department. The structure authorized by this application cannot be occupied until a final inspection has been completed and a Certificate of Occupancy has been issued, if applicable, by the Building Department (Section 305, Uniform Building Code).


I hereby acknowledge that I have read this application and the information is correct; I agree to comply with any and all codes, ordinances, laws, regulations or restrictions which apply to the project. I understand that failure to comply shall result in legal action, which may include but not necessarily be limited to non-use of the building(s).

Applicant Signature [Signature] Date 5/2/07
 Department Approval JRR Danley Hedman Date 5-2-07

Additional water and/or sewer tap fee(s) are required: YES <input checked="" type="checkbox"/> NO <input type="checkbox"/>	W/O No. <u>20209</u>
Utility Accounting <u>[Signature]</u>	Date <u>5-2-07</u>

VALID FOR SIX MONTHS FROM DATE OF ISSUANCE (Section 2.2.C.1 Grand Junction Zoning & Development Code)
 (White: Planning) (Yellow: Customer) (Pink: Building Department) (Goldenrod: Utility Accounting)

2458 1/2 Brookwillow Loop

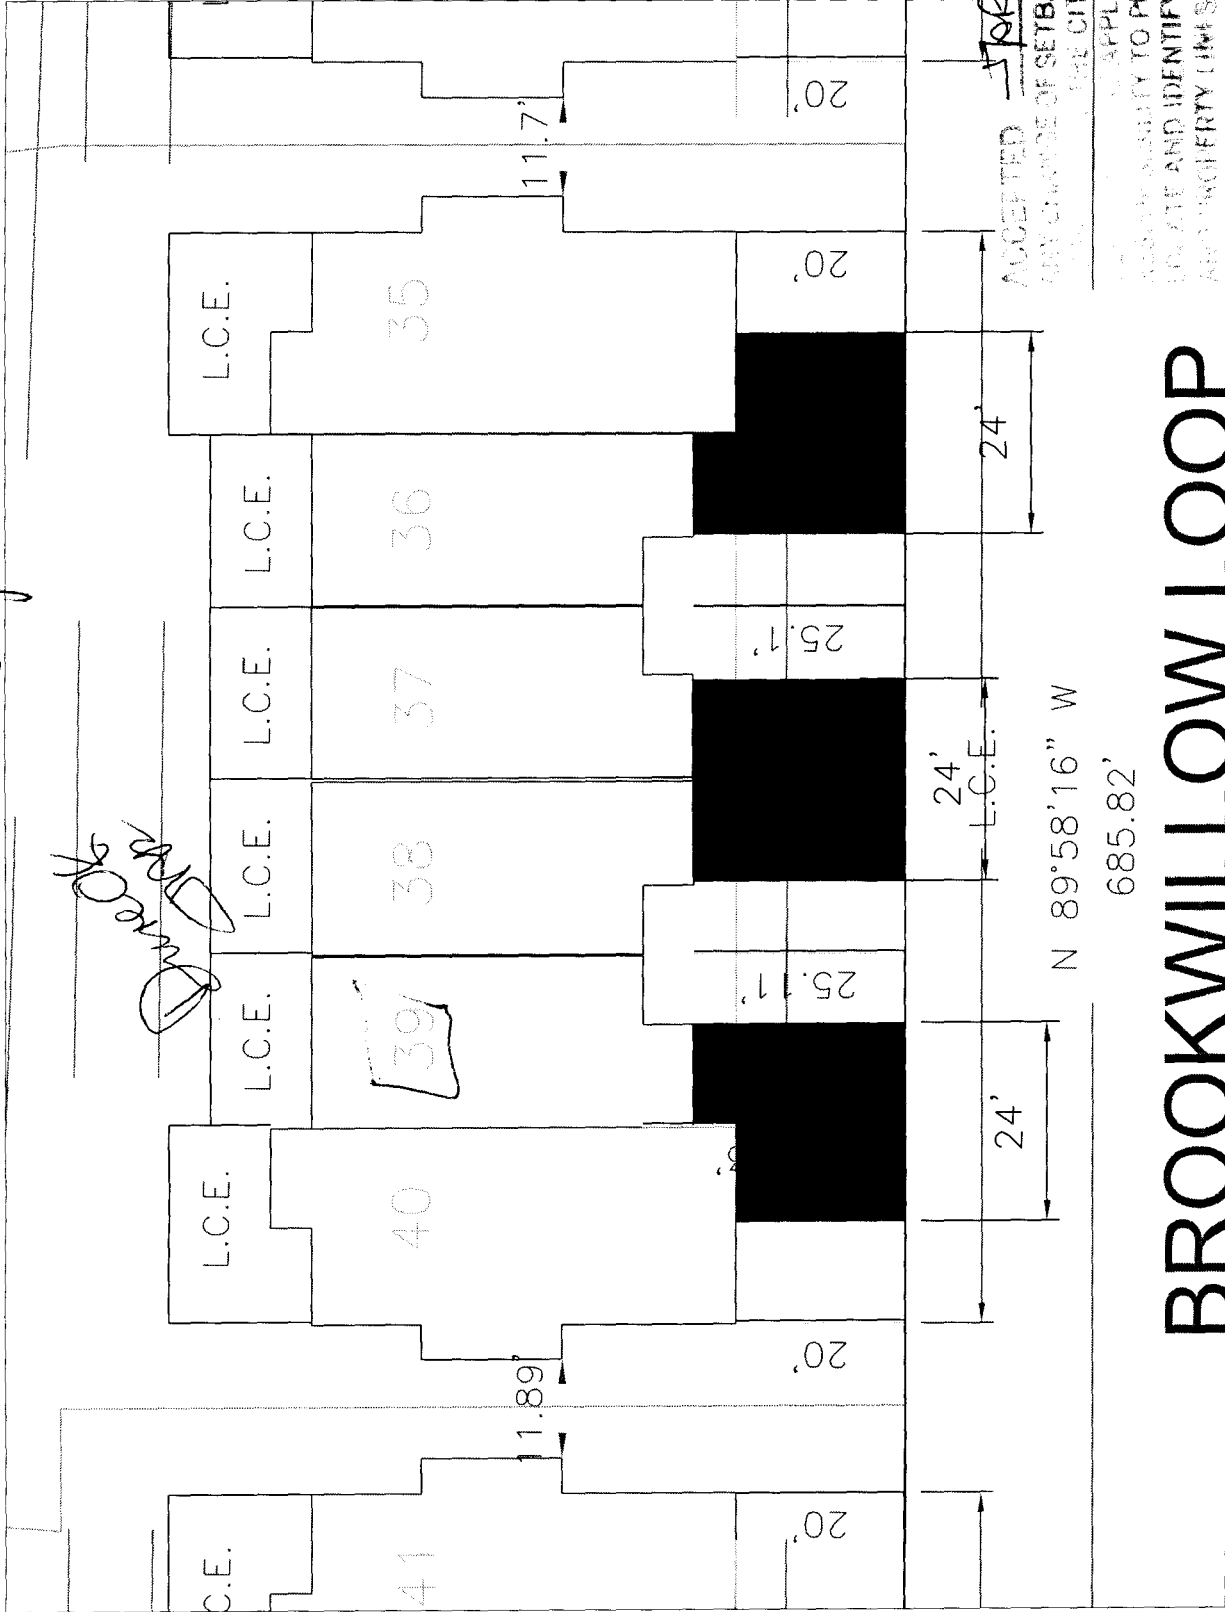

5-2-07
Handwritten

ACCEPTED FOR
ANY CHANGE OF SETBACKS MUST BE
THE CITY PLANNING
DEPARTMENT'S
RESPONSIBILITY TO PROPERLY
OPERATE AND IDENTIFY EASEMENTS
AND PROPERTY LINES

BROOKWILLOW LOOP