

FEE \$ 10  
 TCP \$ 1589  
 SIF \$ 460

**PLANNING CLEARANCE**  
 (Single Family Residential and Accessory Structures)  
Community Development Department

BLDG PERMIT NO. \_\_\_\_\_

Building Address 473 Chatfield Lane  
 Parcel No. 2943-151-16-024  
 Subdivision Chatfield III  
 Filing 2 Block 7 Lot 24

No. of Existing Bldgs 0 No. Proposed 1  
 Sq. Ft. of Existing Bldgs 0 Sq. Ft. Proposed 2430  
 Sq. Ft. of Lot / Parcel 6500  
 Sq. Ft. Coverage of Lot by Structures & Impervious Surface (Total Existing & Proposed) 3,000  
 Height of Proposed Structure 20'

**OWNER INFORMATION:**

Name Tom Watterscheid  
 Address 1451 18 Rd  
 City / State / Zip Fruita, Co. 81521

DESCRIPTION OF WORK & INTENDED USE:  
 New Single Family Home (\*check type below)  
 Interior Remodel  Addition  
 Other (please specify): \_\_\_\_\_

**APPLICANT INFORMATION:**

Name Ottis Roswell  
 Address 516 33 1/2 Rd  
 City / State / Zip Clifton, Co. 81520  
 Telephone 985-0743

\*TYPE OF HOME PROPOSED:  
 Site Built  Manufactured Home (UBC)  
 Manufactured Home (HUD)  
 Other (please specify): \_\_\_\_\_

NOTES: \_\_\_\_\_

**REQUIRED: One plot plan, on 8 1/2" x 11" paper, showing all existing & proposed structure location(s), parking, setbacks to all property lines, ingress/egress to the property, driveway location & width & all easements & rights-of-way which abut the parcel.**

THIS SECTION TO BE COMPLETED BY COMMUNITY DEVELOPMENT DEPARTMENT STAFF			
ZONE <u>R-5</u>	Maximum coverage of lot by structures <u>60%</u>		
SETBACKS: Front <u>20</u> from property line (PL)	Permanent Foundation Required: YES <input checked="" type="checkbox"/> NO <input type="checkbox"/>		
Side <u>5</u> from PL Rear <u>25</u> from PL	Parking Requirement <u>2</u>		
Maximum Height of Structure(s) <u>35</u>	Special Conditions _____		
Voting District <u>C</u>	Driveway Location Approval <u>WS</u> (Engineer's Initials)		

Modifications to this Planning Clearance must be approved, in writing, by the Community Development Department. The structure authorized by this application cannot be occupied until a final inspection has been completed and a Certificate of Occupancy has been issued, if applicable, by the Building Department (Section 305, Uniform Building Code).


I hereby acknowledge that I have read this application and the information is correct; I agree to comply with any and all codes, ordinances, laws, regulations or restrictions which apply to the project. I understand that failure to comply shall result in legal action, which may include but not necessarily be limited to non-use of the building(s).

Applicant Signature Ottis Roswell Date 8-28-07


Department Approval WS Gayleen Henderson Date 9-7-07

Additional water and/or sewer tap fee(s) are required: <input checked="" type="checkbox"/> YES <input type="checkbox"/> NO	W/O No. <u>2943-151-16-024</u>
Utility Accounting <u>[Signature]</u>	Date <u>9-7-07</u>

VALID FOR SIX MONTHS FROM DATE OF ISSUANCE (Section 2.2.C.1 Grand Junction Zoning & Development Code)  
 (White: Planning) (Yellow: Customer) (Pink: Building Department) (Goldenrod: Utility Accounting)

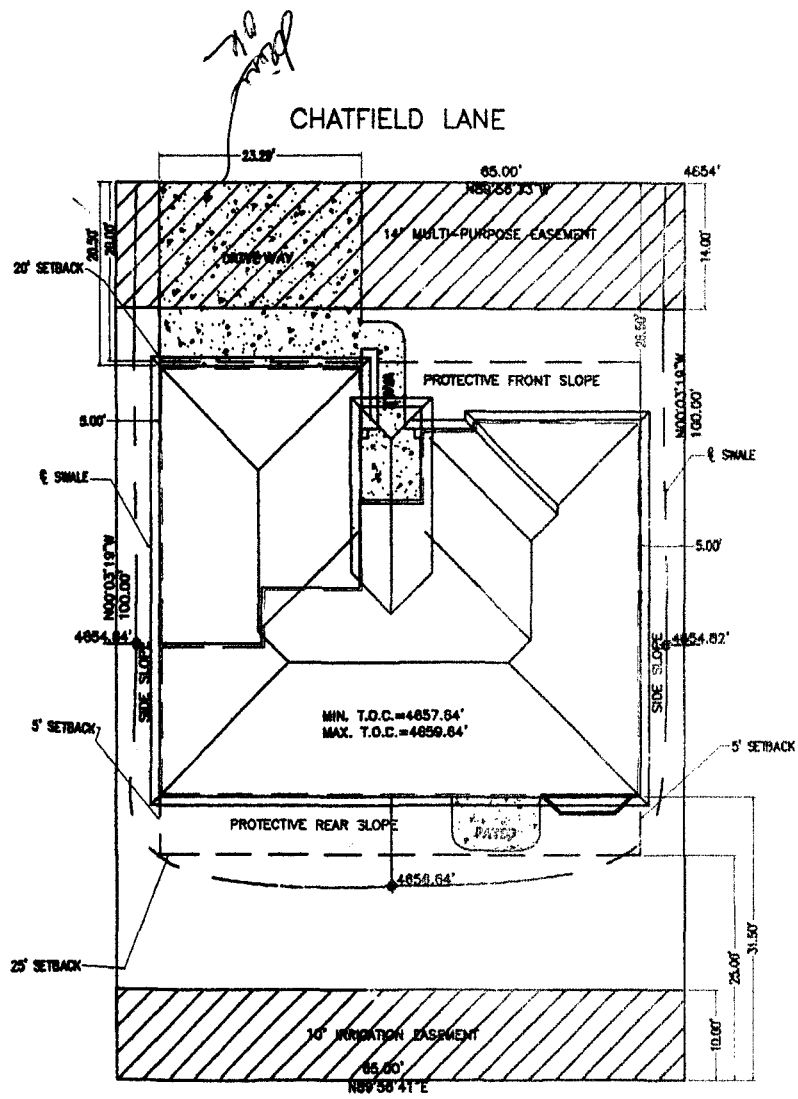

GRADING NOTES:  
 1. SLOPE PARKWAY SLOPE 4% SW  
 2. SLOPE PROTECTIVE FRONT SLOPE TO MEET ORIGINAL GROUND

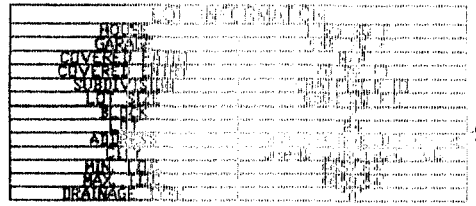

UTILITIES AS DEVELOPER

ACCEPTED

ANY CHANGES TO SETBACKS MUST BE APPROVED BY PLANNING DEPT. BEFORE ANY PERMITS ARE OBTAINED. VERIFY EASEMENTS AND PROPERTY LINES.

973  
 Chatfield Lane  
 9-7-07  
 WS Gaylen Anderson

1. ALL MEASUREMENTS OF BUILDING AND LOT TO BE VERIFIED BY OWNER/BUILDER.
2. PLANS ARE NOT ENGINEERED AND ARE ONLY TO BE USED AFTER ACCEPTANCE OF OWNER/BUILDER, ENGINEER, OR LOCAL BUILDING DEPT.
3. SUGGESTED FRAMING PRACTICES AS / WFCM 2001 EDITION FOR ONE & TWO FAMILY DWELLINGS.