FEE\$	10
TCP\$	1589
SIF\$	460

## **PLANNING CLEARANCE**

BLDG PERMIT NO.

(Single Family Residential and Accessory Structures)

**Community Development Department** 

Building Address 418 CHERT DR	No. of Existing Bldgs	No. Proposed 1
Parcel No. 2943-173-44-015	Sq. Ft. of Existing Bldgs	Sq. Ft. Proposed 1905
Subdivision COUNTRY PLACE ESTATES	Sq. Ft. of Lot / Parcel	4521
Filing 1 Block 7 Lot 14	Sq. Ft. Coverage of Lot by Structure (Total Existing & Proposed)	es & Impervious Surface
OWNER INFORMATION:	Height of Proposed Structure	
Name TML ENTERPRISES INC	DESCRIPTION OF WORK & IN	<del></del>
Address <b>P.O.</b> Box 2569	New Single Family Home (*ch	Addition
City / State / Zip 6.J. CO 8/502	Other (please specify):	
APPLICANT INFORMATION:	*TYPE OF HOME PROPOSED:	_
Name TML ENTERPRISES INC	Site Built  Manufactured Home (HUD)  Other (places energify):	Manufactured Home (UBC)
Address <u>P.o.</u> Box 2569	Other (please specify):	
City / State / Zip <u>GJ CO 81502</u> NC	OTES:	
Telephone 970 Z45 927		
REQUIRED: One plot plan, on 8 1/2" x 11" paper, showing all ex		
	n & width & all easements & rights-c	of-way which abut the parcel.
property lines, ingress/egress to the property, driveway location		
property lines, ingress/egress to the property, driveway location THIS SECTION TO BE COMPLETED BY COMM	IUNITY DEVELOPMENT DEPAR	TMENT STAFF
property lines, ingress/egress to the property, driveway location THIS SECTION TO BE COMPLETED BY COMM		TMENT STAFF
property lines, ingress/egress to the property, driveway location THIS SECTION TO BE COMPLETED BY COMM	IUNITY DEVELOPMENT DEPAR	TMENT STAFF  Ictures 70%
THIS SECTION TO BE COMPLETED BY COMN  ZONE from property line (PL)  Side from PL Rear from PL	Maximum coverage of lot by stru	t: YESNO
THIS SECTION TO BE COMPLETED BY COMN  ZONE from property line (PL)	Maximum coverage of lot by stru  Permanent Foundation Required	trues 10%
THIS SECTION TO BE COMPLETED BY COMN  ZONE  SETBACKS: Front  from property line (PL)  Side  from PL  Rear  Maximum Height of Structure(s)  Side  Settle Complete Structure(s)  Rear  Settle Complete Structure(s)  Side  Settle Complete Structure(s)  Settle Complete Structure(s)	Maximum coverage of lot by strue Permanent Foundation Required Parking Requirement	trues 10%
THIS SECTION TO BE COMPLETED BY COMN  ZONE from property line (PL)  Side from PL Rear from PL	Maximum coverage of lot by strue Permanent Foundation Required Parking Requirement	trues 10%
THIS SECTION TO BE COMPLETED BY COMN  ZONE  SETBACKS: Front  from property line (PL)  Side  from PL  Rear  Driveway  Location Approval	Maximum coverage of lot by strue Permanent Foundation Required Parking Requirement Special Conditions  in writing, by the Community Deventil a final inspection has been co	elopment Department. The mpleted and a Certificate of
THIS SECTION TO BE COMPLETED BY COMN  ZONE  SETBACKS: Front  from property line (PL)  Side  from PL  Rear  Driveway  Location Approval  (Engineer's Initials)  Modifications to this Planning Clearance must be approved, structure authorized by this application cannot be occupied up	Maximum coverage of lot by strue Permanent Foundation Required Parking Requirement Special Conditions  in writing, by the Community Deventil a final inspection has been copartment (Section 305, Uniform Brinformation is correct; I agree to coproject. I understand that failure to	elopment Department. The mpleted and a Certificate of uilding Code).
THIS SECTION TO BE COMPLETED BY COMN  ZONE  SETBACKS: Front  from property line (PL)  Side  from PL  Rear  Driveway  Location Approval  (Engineer's Initials)  Modifications to this Planning Clearance must be approved, structure authorized by this application cannot be occupied un Occupancy has been issued, if applicable, by the Building De I hereby acknowledge that I have read this application and the ordinances, laws, regulations or restrictions which apply to the	Maximum coverage of lot by strue Permanent Foundation Required Parking Requirement Special Conditions  in writing, by the Community Deventil a final inspection has been copartment (Section 305, Uniform Brinformation is correct; I agree to coproject. I understand that failure to	elopment Department. The mpleted and a Certificate of uilding Code).
THIS SECTION TO BE COMPLETED BY COMN  ZONE  SETBACKS: Front  from property line (PL)  Side  from PL  Rear  Driveway  Location Approval  (Engineer's Initials)  Modifications to this Planning Clearance must be approved, structure authorized by this application cannot be occupied uroccupancy has been issued, if applicable, by the Building Della I hereby acknowledge that I have read this application and the ordinances, laws, regulations or restrictions which apply to the action, which may include but not necessarily be limited to not	Maximum coverage of lot by strue Permanent Foundation Required Parking Requirement Special Conditions  in writing, by the Community Deventil a final inspection has been copartment (Section 305, Uniform Beinformation is correct; I agree to coproject. I understand that failure to n-use of the building(s).	elopment Department. The mpleted and a Certificate of uilding Code).  Imply with any and all codes, o comply shall result in legal
THIS SECTION TO BE COMPLETED BY COMN  ZONE  SETBACKS: Front  from property line (PL)  Side  from PL  Rear  Driveway  Location Approval  (Engineer's Initials)  Modifications to this Planning Clearance must be approved, structure authorized by this application cannot be occupied uroccupancy has been issued, if applicable, by the Building De I hereby acknowledge that I have read this application and the ordinances, laws, regulations or restrictions which apply to the action, which may include but not necessarily be limited to not Applicant Signature	Maximum coverage of lot by strue Permanent Foundation Required Parking Requirement Special Conditions  in writing, by the Community Deventil a final inspection has been concept formation is correct; I agree to concept formation is correct.	elopment Department. The mpleted and a Certificate of uilding Code).  Imply with any and all codes, o comply shall result in legal
THIS SECTION TO BE COMPLETED BY COMN  ZONE  SETBACKS: Front  from PL  Rear  Driveway Location Approval (Engineer's Initials)  Modifications to this Planning Clearance must be approved, structure authorized by this application cannot be occupied uroccupancy has been issued, if applicable, by the Building De I hereby acknowledge that I have read this application and the ordinances, laws, regulations or restrictions which apply to the action, which may include but not necessarily be limited to not applicant Signature  Department Approval	Maximum coverage of lot by strue Permanent Foundation Required Parking Requirement Special Conditions  in writing, by the Community Deventil a final inspection has been concept formation is correct; I agree to concept formation is correct.	elopment Department. The mpleted and a Certificate of uilding Code).  Imply with any and all codes, o comply shall result in legal

(White: Planning) (Yellow: Customer) (Pink: Building Department) (Goldenrod: Utility Accounting)

FEE\$	10
TCP\$	1589
SIF\$	460

## **PLANNING CLEARANCE**


BLDG PERMIT NO.

(Single Family Residential and Accessory Structures)

**Community Development Department** 

Building Address 418 CHERT DR	No. of Existing Bldgs	No. Proposed 1
Parcel No. 2943-173-44-015	Sq. Ft. of Existing Bldgs	Sq. Ft. Proposed 1905
Subdivision COUNTRY PLACE ESTATES	Sq. Ft. of Lot / Parcel	4521
Filing 1 Block 7 Lot 14	Sq. Ft. Coverage of Lot by Structure (Total Existing & Proposed)	es & Impervious Surface
OWNER INFORMATION:	Height of Proposed Structure	
Name TML ENTERPRISES INC	DESCRIPTION OF WORK & IN	<del></del>
Address <b>P.O.</b> Box 2569	New Single Family Home (*ch	Addition
City / State / Zip 6.J. CO 8/502	Other (please specify):	
APPLICANT INFORMATION:	*TYPE OF HOME PROPOSED:	_
Name TML ENTERPRISES INC	Site Built  Manufactured Home (HUD)  Other (places energify):	Manufactured Home (UBC)
Address <u>P.o.</u> Box 2569	Other (please specify):	
City / State / Zip <u>GJ CO 81502</u> NC	OTES:	
Telephone 970 Z45 927		
REQUIRED: One plot plan, on 8 1/2" x 11" paper, showing all ex		
	n & width & all easements & rights-c	of-way which abut the parcel.
property lines, ingress/egress to the property, driveway location		
property lines, ingress/egress to the property, driveway location THIS SECTION TO BE COMPLETED BY COMM	IUNITY DEVELOPMENT DEPAR	TMENT STAFF
property lines, ingress/egress to the property, driveway location THIS SECTION TO BE COMPLETED BY COMM		TMENT STAFF
property lines, ingress/egress to the property, driveway location THIS SECTION TO BE COMPLETED BY COMM	IUNITY DEVELOPMENT DEPAR	TMENT STAFF  Ictures 70%
THIS SECTION TO BE COMPLETED BY COMN  ZONE from property line (PL)  Side from PL Rear from PL	Maximum coverage of lot by stru	t: YESNO
THIS SECTION TO BE COMPLETED BY COMN  ZONE from property line (PL)	Maximum coverage of lot by stru  Permanent Foundation Required	trues 10%
THIS SECTION TO BE COMPLETED BY COMN  ZONE  SETBACKS: Front  from property line (PL)  Side  from PL  Rear  Maximum Height of Structure(s)  Side  Settle Complete Structure(s)  Rear  Settle Complete Structure(s)  Side  Settle Complete Structure(s)  Settle Complete Structure(s)	Maximum coverage of lot by strue Permanent Foundation Required Parking Requirement	trues 10%
THIS SECTION TO BE COMPLETED BY COMN  ZONE from property line (PL)  Side from PL Rear from PL	Maximum coverage of lot by strue Permanent Foundation Required Parking Requirement	trues 10%
THIS SECTION TO BE COMPLETED BY COMN  ZONE  SETBACKS: Front  from property line (PL)  Side  from PL  Rear  Driveway  Location Approval	Maximum coverage of lot by strue Permanent Foundation Required Parking Requirement Special Conditions  in writing, by the Community Deventil a final inspection has been co	elopment Department. The mpleted and a Certificate of
THIS SECTION TO BE COMPLETED BY COMN  ZONE  SETBACKS: Front  from property line (PL)  Side  from PL  Rear  Driveway  Location Approval  (Engineer's Initials)  Modifications to this Planning Clearance must be approved, structure authorized by this application cannot be occupied up	Maximum coverage of lot by strue Permanent Foundation Required Parking Requirement Special Conditions  in writing, by the Community Deventil a final inspection has been copartment (Section 305, Uniform Brinformation is correct; I agree to coproject. I understand that failure to	elopment Department. The mpleted and a Certificate of uilding Code).
THIS SECTION TO BE COMPLETED BY COMN  ZONE  SETBACKS: Front  from property line (PL)  Side  from PL  Rear  Driveway  Location Approval  (Engineer's Initials)  Modifications to this Planning Clearance must be approved, structure authorized by this application cannot be occupied un Occupancy has been issued, if applicable, by the Building De I hereby acknowledge that I have read this application and the ordinances, laws, regulations or restrictions which apply to the	Maximum coverage of lot by strue Permanent Foundation Required Parking Requirement Special Conditions  in writing, by the Community Deventil a final inspection has been copartment (Section 305, Uniform Brinformation is correct; I agree to coproject. I understand that failure to	elopment Department. The mpleted and a Certificate of uilding Code).
THIS SECTION TO BE COMPLETED BY COMN  ZONE  SETBACKS: Front  from property line (PL)  Side  from PL  Rear  Driveway  Location Approval  (Engineer's Initials)  Modifications to this Planning Clearance must be approved, structure authorized by this application cannot be occupied uroccupancy has been issued, if applicable, by the Building Della I hereby acknowledge that I have read this application and the ordinances, laws, regulations or restrictions which apply to the action, which may include but not necessarily be limited to not	Maximum coverage of lot by strue Permanent Foundation Required Parking Requirement Special Conditions  in writing, by the Community Deventil a final inspection has been copartment (Section 305, Uniform Beinformation is correct; I agree to coproject. I understand that failure to n-use of the building(s).	elopment Department. The mpleted and a Certificate of uilding Code).  Imply with any and all codes, o comply shall result in legal
THIS SECTION TO BE COMPLETED BY COMN  ZONE  SETBACKS: Front  from property line (PL)  Side  from PL  Rear  Driveway  Location Approval  (Engineer's Initials)  Modifications to this Planning Clearance must be approved, structure authorized by this application cannot be occupied uroccupancy has been issued, if applicable, by the Building De I hereby acknowledge that I have read this application and the ordinances, laws, regulations or restrictions which apply to the action, which may include but not necessarily be limited to not Applicant Signature	Maximum coverage of lot by strue Permanent Foundation Required Parking Requirement Special Conditions  in writing, by the Community Deventil a final inspection has been concept formation is correct; I agree to concept formation is correct.	elopment Department. The mpleted and a Certificate of uilding Code).  Imply with any and all codes, o comply shall result in legal
THIS SECTION TO BE COMPLETED BY COMN  ZONE  SETBACKS: Front  from PL  Rear  Driveway Location Approval (Engineer's Initials)  Modifications to this Planning Clearance must be approved, structure authorized by this application cannot be occupied uroccupancy has been issued, if applicable, by the Building De I hereby acknowledge that I have read this application and the ordinances, laws, regulations or restrictions which apply to the action, which may include but not necessarily be limited to not applicant Signature  Department Approval	Maximum coverage of lot by strue Permanent Foundation Required Parking Requirement Special Conditions  in writing, by the Community Deventil a final inspection has been concept formation is correct; I agree to concept formation is correct.	elopment Department. The mpleted and a Certificate of uilding Code).  Imply with any and all codes, o comply shall result in legal

(White: Planning) (Yellow: Customer) (Pink: Building Department) (Goldenrod: Utility Accounting)

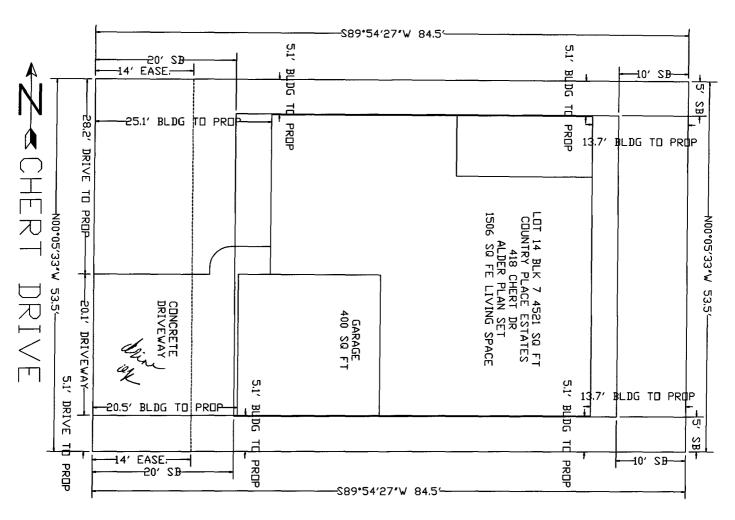

ACCEPTED US Dayler Henderson

MY CHANGE WOTTBACKS MUST BE

MY CHANGE WOTTBACKS MUST BE

MATTER


DRAWN BY:
FILE NAME
LOT 14 BEE.
DATE
ORASE
STREET:
SHEET:
CIT 15 BEE.
CIT 15 B

TML ENTERPRISES INC. IS THE SOLE OWNER OF THIS SET OF PLANS. ANY USE OR REPRODUCTION OF THESE PLANS WITHOUT WRITTEN PERMISSION IS EXPRESSLY PROHIBITED UNDER COPYRIGHT LAWS. ILLEGAL USERS OF THESE PLANS WILL BE PROSECUTED TO THE FULL EXTENT OF THE LAW.

TML ENTERPRISES

PO BOX 2569 GRAND JUNCTION CO. 81502 (970) 245-9271 ALDER
418 CHERT DR
GRAND JUNCTION, CO



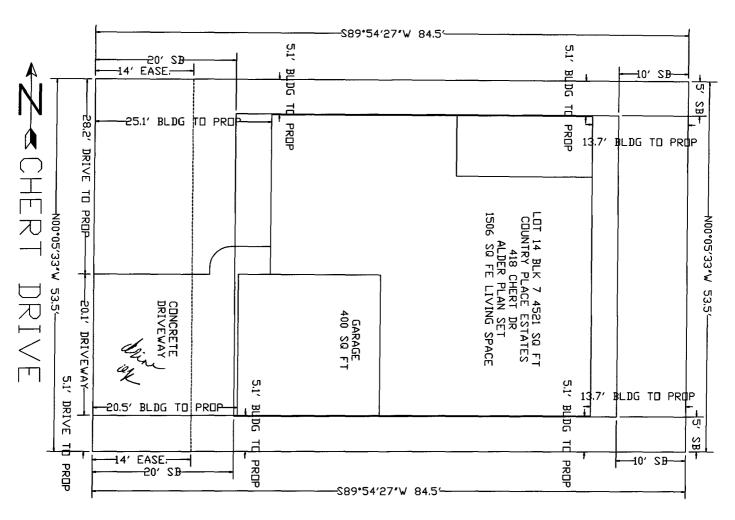

ACCEPTED US Dayler Henderson

MY CHANGE WOTTBACKS MUST BE

MY CHANGE WOTTBACKS MUST BE

MATTER

DRAWN BY:
FILE NAME
LOT 14 BEE.
DATE
ORASE
STREET:
SHEET:
CIT 15 BEE.
CIT 15 B

TML ENTERPRISES INC. IS THE SOLE OWNER OF THIS SET OF PLANS. ANY USE OR REPRODUCTION OF THESE PLANS WITHOUT WRITTEN PERMISSION IS EXPRESSLY PROHIBITED UNDER COPYRIGHT LAWS. ILLEGAL USERS OF THESE PLANS WILL BE PROSECUTED TO THE FULL EXTENT OF THE LAW.

TML ENTERPRISES

PO BOX 2569 GRAND JUNCTION CO. 81502 (970) 245-9271 ALDER
418 CHERT DR
GRAND JUNCTION, CO

