

FEE \$	10.00
TCP \$	Ø
SIF \$	Ø

**PLANNING CLEARANCE**  
 (Single Family Residential and Accessory Structures)  
**Community Development Department**

BLDG PERMIT NO. 4d

14570-9183

Building Address 685 Crest Ct  
 Parcel No. 2945-021-03-012  
 Subdivision Crestridge Annex  
 Filing \_\_\_\_\_ Block \_\_\_\_\_ Lot 3

No. of Existing Bldgs 1 No. Proposed 1  
 Sq. Ft. of Existing Bldgs 3781 Sq. Ft. Proposed 640  
 Sq. Ft. of Lot / Parcel 39,988.08  
 Sq. Ft. Coverage of Lot by Structures & Impervious Surface  
 (Total Existing & Proposed) \_\_\_\_\_  
 Height of Proposed Structure \_\_\_\_\_

**OWNER INFORMATION:**

Name Steve Meyer  
 Address 685 Crest Ct.  
 City / State / Zip G.J. Co 81506

**DESCRIPTION OF WORK & INTENDED USE:**

- New Single Family Home (\*check type below)
- Interior Remodel  Addition
- Other (please specify): \_\_\_\_\_

**APPLICANT INFORMATION:**

Name David Painter  
 Address 190 Rosalie Dr.  
 City / State / Zip G.J. Co 81503  
 Telephone 245-5621 cell 216-6469

**\*TYPE OF HOME PROPOSED:**

- Site Built  Manufactured Home (UBC)
- Manufactured Home (HUD)
- Other (please specify): \_\_\_\_\_

NOTES: Covered outside Living Room (patio)

**REQUIRED: One plot plan, on 8 1/2" x 11" paper, showing all existing & proposed structure location(s), parking, setbacks to all property lines, ingress/egress to the property, driveway location & width & all easements & rights-of-way which abut the parcel.**

THIS SECTION TO BE COMPLETED BY COMMUNITY DEVELOPMENT DEPARTMENT STAFF	
ZONE <u>R-2</u>	Maximum coverage of lot by structures <u>30%</u>
SETBACKS: Front <u>20'</u> from property line (PL)	Permanent Foundation Required: YES <input checked="" type="checkbox"/> NO <input type="checkbox"/>
Side <u>15'</u> from PL Rear <u>30'</u> from PL	Parking Requirement <u>2</u>
Maximum Height of Structure(s) <u>35'</u>	Special Conditions _____
Voting District _____	Driveway Location Approval _____ (Engineer's Initials)

Modifications to this Planning Clearance must be approved, in writing, by the Community Development Department. The structure authorized by this application cannot be occupied until a final inspection has been completed and a Certificate of Occupancy has been issued, if applicable, by the Building Department (Section 305, Uniform Building Code).

I hereby acknowledge that I have read this application and the information is correct; I agree to comply with any and all codes, ordinances, laws, regulations or restrictions which apply to the project. I understand that failure to comply shall result in legal action, which may include but not necessarily be limited to non-use of the building(s).

Applicant Signature David Painter Date 6-22-07  
 Department Approval Gaylen Henderson Date 6-22-07




Additional water and/or sewer tap fee(s) are required:	YES	NO <input checked="" type="checkbox"/>	W/O No. <u>No Change sur/water</u>
Utility Accounting <u>[Signature]</u>	Date <u>6/22/07</u>		

VALID FOR SIX MONTHS FROM DATE OF ISSUANCE (Section 2.2.C.1 Grand Junction Zoning & Development Code)  
 (White: Planning) (Yellow: Customer) (Pink: Building Department) (Goldenrod: Utility Accounting)

6-22-07

Gayleen Henderson

ACCEPTED  
ANY CHANGE OF SETBACKS MUST BE APPROVED BY THE CITY PLANNING DEPT. IT IS THE APPLICANT'S RESPONSIBILITY TO PROPERLY LOCATE AND IDENTIFY EASEMENTS AND PROPERTY LINES.

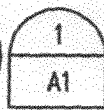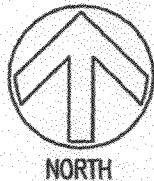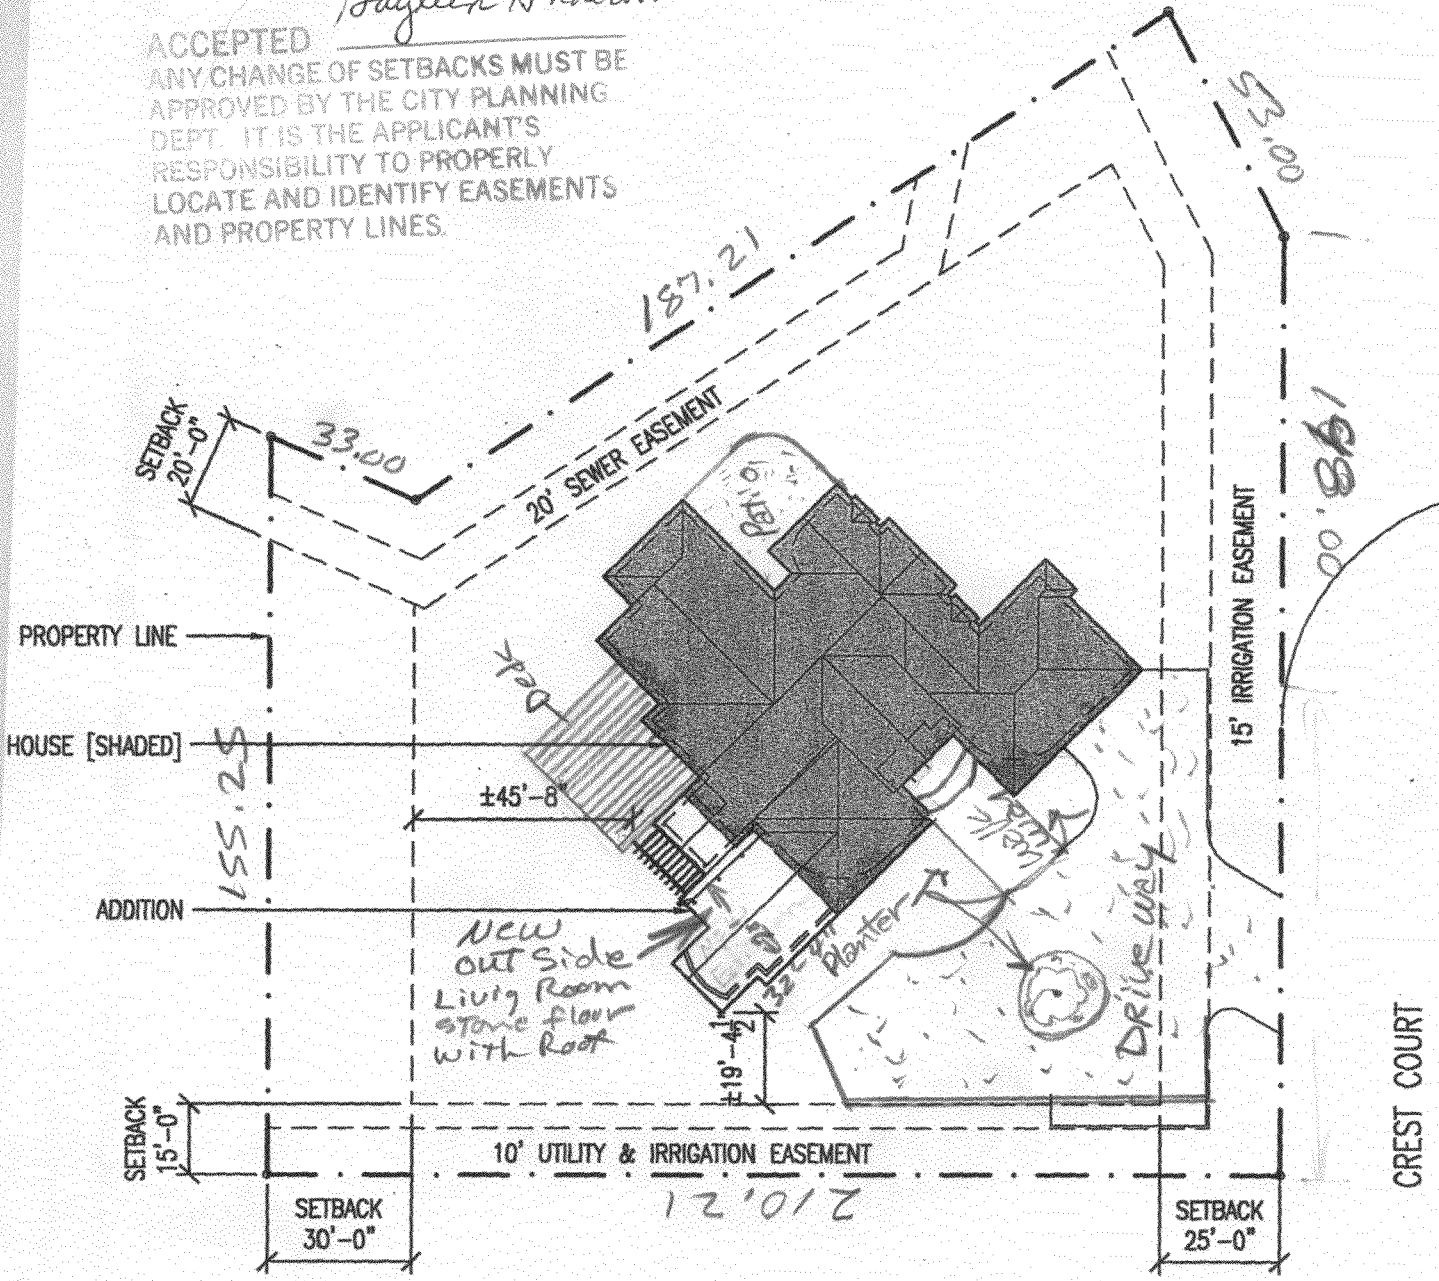

SITE PLAN - 685 CREST COURT

1" = 400'-0"

