
	Λ
TCP \$ 1581. (Single Family Residential and	
SIF \$ 4(0).	
Building Address 316 N. CARTINGE Hills	No. of Existing Bldgs
Parcel No. 2915-241- 00-162 poron	Sq. Ft. of Existing Bldgs O Sq. Ft. Proposed BIZ
Subdivision CARRINGS HILLS	Sq. Ft. of Lot / Parcel 4083
Filing Block Lot Lot	Sq. Ft. Coverage of Lot by Structures & Impervious Surface (Total Existing & Proposed)
OWNER INFORMATION: BEG BUILDERS	Height of Proposed Structure 26' +/-
Name (LAWRONG KALIZO)	DESCRIPTION OF WORK & INTENDED USE:
Address 2482 Couroace BCVD	New Single Family Home (*check type below) Interior Remodel Other (please specify):
City/State/Zip GRAND JCT 81505	
APPLICANT INFORMATION:	*TYPE OF HOME PROPOSED:
Name NATHAN J. STATON	Site Built Manufactured Home (UBC) Manufactured Home (HUD)
Address 2660 BANGS GANY ADR	Other (please specify):
CT CORIET	
City/State/Zip $GJ \leq 0$ 81503 r	NOTES:
City/State/Zip $(J_J < 0 0) = 0$ Telephone $\underline{970} \\ \overline{734} \\ 6653$	NOTES:
Telephone <u>970 234 6653</u> REQUIRED: One plot plan, on 8 1/2" x 11" paper, showing all	NOTES: existing & proposed structure location(s), parking, setbacks to all ion & width & all easements & rights-of-way which abut the parcel.
Telephone <u>970 234 6653</u> REQUIRED: One plot plan, on 8 1/2" x 11" paper, showing all property lines, ingress/egress to the property, driveway locat	existing & proposed structure location(s), parking, setbacks to all
Telephone <u>970 234 6653</u> REQUIRED: One plot plan, on 8 1/2" x 11" paper, showing all property lines, ingress/egress to the property, driveway locat	existing & proposed structure location(s), parking, setbacks to all ion & width & all easements & rights-of-way which abut the parcel.
Telephone <u>970 234 6653</u> REQUIRED: One plot plan, on 8 1/2" x 11" paper, showing all property lines, ingress/egress to the property, driveway locat THIS SECTION TO BE COMPLETED BY COM	existing & proposed structure location(s), parking, setbacks to all ion & width & all easements & rights-of-way which abut the parcel. IMUNITY DEVELOPMENT DEPARTMENT STAFF -1.5 ^G 70
Telephone 970 234 6653 REQUIRED: One plot plan, on 8 1/2" x 11" paper, showing all property lines, ingress/egress to the property, driveway locat THIS SECTION TO BE COMPLETED BY COM ZONE X -8	existing & proposed structure location(s), parking, setbacks to all ion & width & all easements & rights-of-way which abut the parcel. IMUNITY DEVELOPMENT DEPARTMENT STAFF Maximum coverage of lot by structures
Telephone 970 234 6653 REQUIRED: One plot plan, on 8 1/2" x 11" paper, showing all property lines, ingress/egress to the property, driveway locate THIS SECTION TO BE COMPLETED BY COM ZONE X 10 SETBACKS: Front	existing & proposed structure location(s), parking, setbacks to all ion & width & all easements & rights-of-way which abut the parcel. MUNITY DEVELOPMENT DEPARTMENT STAFF Maximum coverage of lot by structures $13^{\circ}7^{\circ}$ Permanent Foundation Required: YES A NO
Telephone 970 234 6653 REQUIRED: One plot plan, on 8 1/2" x 11" paper, showing all property lines, ingress/egress to the property, driveway locat THIS SECTION TO BE COMPLETED BY COM ZONE X - 8 SETBACKS: Front 20 from property line (PL) Side 5 from PL	existing & proposed structure location(s), parking, setbacks to all ion & width & all easements & rights-of-way which abut the parcel. MUNITY DEVELOPMENT DEPARTMENT STAFF Maximum coverage of lot by structures Maximum coverage of lot by structures Permanent Foundation Required: YES_ANO Parking Requirement Special Conditions
Telephone 970 2 34 6653 REQUIRED: One plot plan, on 8 1/2" x 11" paper, showing all property lines, ingress/egress to the property, driveway located to the property lines, ingress/egress to the property, driveway located to the property lines, ingress/egress to the property, driveway located to the property lines, ingress/egress to the property, driveway located to the property lines, ingress/egress to the property, driveway located to the property lines, ingress/egress to the property, driveway located to the property lines, ingress/egress to the property, driveway located to the property lines, ingress/egress to the property, driveway located to the property lines, ingress/egress to the property, driveway located to the property lines, ingress/egress to the property, driveway located to the property lines, ingress/egress to the property, driveway located to the property lines, ingress/egress to the property, driveway located to the property line (PL) Set BACKS: Front	existing & proposed structure location(s), parking, setbacks to all ion & width & all easements & rights-of-way which abut the parcel. MUNITY DEVELOPMENT DEPARTMENT STAFF Maximum coverage of lot by structures
Telephone 970 2 34 6653 REQUIRED: One plot plan, on 8 1/2" x 11" paper, showing all property lines, ingress/egress to the property, driveway located of the property lines, ingress/egress to the property, driveway located of the property lines, ingress/egress to the property, driveway located of the property lines, ingress/egress to the property, driveway located of the property lines, ingress/egress to the property, driveway located of the property lines, ingress/egress to the property, driveway located of the property lines, ingress/egress to the property, driveway located of the property lines, ingress/egress to the property, driveway located of the property lines, ingress/egress to the property, driveway located of the property lines, ingress/egress to the property, driveway located of the property lines, ingress/egress to the property, driveway located of the property lines, ingress/egress to the property, driveway located of the property lines, ingress/egress to the property, driveway located of the property lines, ingress/egress to the property, driveway located of the property lines, ingress/egress to the property line (PL) SetTBACKS: Front	existing & proposed structure location(s), parking, setbacks to all ion & width & all easements & rights-of-way which abut the parcel. MUNITY DEVELOPMENT DEPARTMENT STAFF Maximum coverage of lot by structures

•

÷

Applicant Signature	1/	/	Date 8.27-	6'/
Department Approval	Judon freq		Date	
Additional water and/or	sever tap fee(s) are required:	YES NO	W/O No. 2	408
Utility Accounting	- AM		Date 9-10-	-07
VALID FOR SIX MON (White: Planning)	HS FROM DATE OF ISSUANC (Veillow: Customer)	CE (Section 2.2.C.1 (Pink: Building Dep		& Development Code) hrod: Utility Accounting)

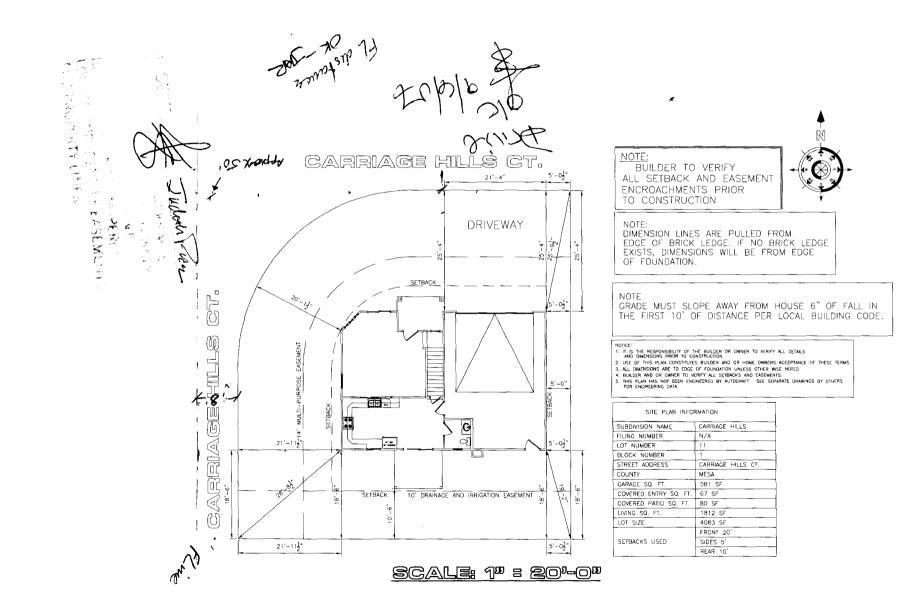

٠