

FEE \$	10.00
TCP \$	1589.00
SIF \$	460.00

PLANNING CLEARANCE

(Single Family Residential and Accessory Structures)
Community Development Department

BLDG PERMIT NO. _____

Building Address 454 Dodge No. of Existing Bldgs 0 No. Proposed 1
 Parcel No. 2543-162-51-023 (Parent) Sq. Ft. of Existing Bldgs 0 Sq. Ft. Proposed 1366
 Subdivision Prairie View South Sq. Ft. of Lot / Parcel 7361 SQ FT
 Filing 1 Block 1 Lot x3 Sq. Ft. Coverage of Lot by Structures & Impervious Surface (Total Existing & Proposed) 1930 SQ FT
 Height of Proposed Structure 25

OWNER INFORMATION:

Name Gary Runderle Const
 Address Po Box 1380
 City / State / Zip Clifton Co 81520

DESCRIPTION OF WORK & INTENDED USE:
 New Single Family Home (*check type below)
 Interior Remodel Addition
 Other (please specify): _____

APPLICANT INFORMATION:

Name SAME AS OWNER
 Address _____
 City / State / Zip _____
 Telephone 434-0510

*TYPE OF HOME PROPOSED:
 Site Built Manufactured Home (UBC)
 Manufactured Home (HUD)
 Other (please specify): _____

NOTES: NEW SFR

REQUIRED: One plot plan, on 8 1/2" x 11" paper, showing all existing & proposed structure location(s), parking, setbacks to all property lines, ingress/egress to the property, driveway location & width & all easements & rights-of-way which abut the parcel.

THIS SECTION TO BE COMPLETED BY COMMUNITY DEVELOPMENT DEPARTMENT STAFF	
ZONE <u>RMF-5</u>	Maximum coverage of lot by structures <u>60%</u>
SETBACKS: Front <u>26'</u> from property line (PL)	Permanent Foundation Required: YES <u>X</u> NO _____
Side <u>5'</u> from PL Rear <u>25'</u> from PL	Parking Requirement <u>2</u>
Maximum Height of Structure(s) <u>35'</u>	Special Conditions _____
Voting District <u>C</u>	Driveway Location Approval <u>5/9/07 NA</u> (Engineer's Initials)

Modifications to this Planning Clearance must be approved, in writing, by the Community Development Department. The structure authorized by this application cannot be occupied until a final inspection has been completed and a Certificate of Occupancy has been issued, if applicable, by the Building Department (Section 305, Uniform Building Code).


I hereby acknowledge that I have read this application and the information is correct; I agree to comply with any and all codes, ordinances, laws, regulations or restrictions which apply to the project. I understand that failure to comply shall result in legal action, which may include but not necessarily be limited to non use of the building(s).

Applicant Signature [Signature] Date 5-8-07

Department Approval NA [Signature] Date 5/29/07

Additional water and/or sewer tap fee(s) are required:	YES <input checked="" type="checkbox"/>	NO <input type="checkbox"/>	W/O No. <u>20305</u>
Utility Accounting <u>[Signature]</u>	Date <u>5/29/07</u>		

VALID FOR SIX MONTHS FROM DATE OF ISSUANCE (Section 2.2.C.1 Grand Junction Zoning & Development Code)
 (White: Planning) (Yellow: Customer) (Pink: Building Department) (Goldenrod: Utility Accounting)

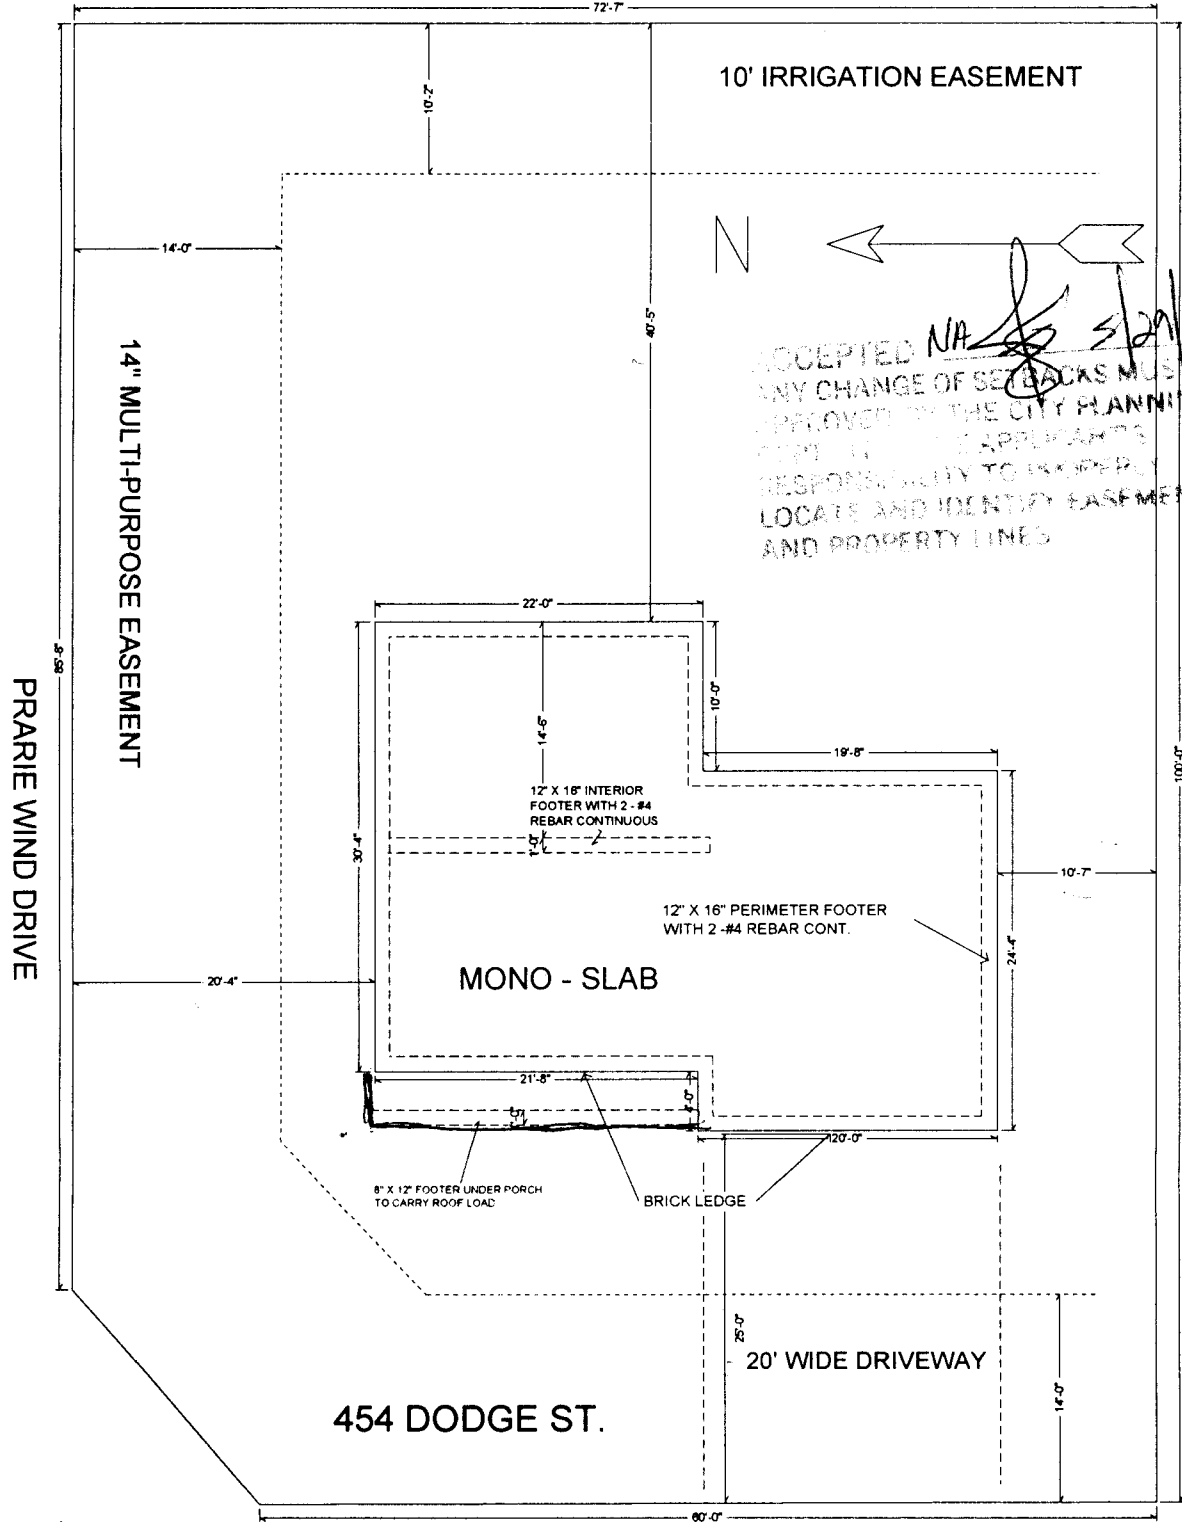

*Duneck
ORR*