

FEE \$:	10.00
TCP \$	39.00
SIF \$	460.00

PLANNING CLEARANCE
 (Single Family Residential and Accessory Structures)
Community Development Department

BLDG PERMIT NO. _____

pl

Building Address 2203 Desert Varnish Ct. No. of Existing Bldgs 0 No. Proposed 1
 Parcel No. 2945-192-10-013 Sq. Ft. of Existing Bldgs 0 Sq. Ft. Proposed 2428
 Subdivision Canyon Rim Sq. Ft. of Lot / Parcel 17,746
 Filing 2 Block 1 Lot 6 Sq. Ft. Coverage of Lot by Structures & Impervious Surface (Total Existing & Proposed) 3200
 Height of Proposed Structure 24'

OWNER INFORMATION:

Name DAVID Bigg
 Address P.O. Box 3527
 City / State / Zip Grand Jet, CO 81502

DESCRIPTION OF WORK & INTENDED USE:

New Single Family Home (*check type below)
 Interior Remodel Addition
 Other (please specify): _____

APPLICANT INFORMATION:

Name Sime
 Address _____
 City / State / Zip _____
 Telephone 234-2222

***TYPE OF HOME PROPOSED:**

Site Built Manufactured Home (UBC)
 Manufactured Home (HUD)
 Other (please specify): _____

NOTES: _____

REQUIRED: One plot plan, on 8 1/2" x 11" paper, showing all existing & proposed structure location(s), parking, setbacks to all property lines, ingress/egress to the property, driveway location & width & all easements & rights-of-way which abut the parcel.

THIS SECTION TO BE COMPLETED BY COMMUNITY DEVELOPMENT DEPARTMENT STAFF			
ZONE <u>R-2</u>	Maximum coverage of lot by structures <u>30%</u>		
SETBACKS: Front <u>20</u> from property line (PL)	Permanent Foundation Required: YES <u>X</u> NO _____		
Side <u>15</u> from PL Rear <u>30</u> from PL	Parking Requirement <u>2</u>		
Maximum Height of Structure(s) <u>35</u>	Special Conditions <u>Engineered Foundation</u>		
Voting District <u>A</u>	Driveway Location Approval _____	<u>required.</u>	
	(Engineer's Initials)		

Modifications to this Planning Clearance must be approved, in writing, by the Community Development Department. The structure authorized by this application cannot be occupied until a final inspection has been completed and a Certificate of Occupancy has been issued, if applicable, by the Building Department (Section 305, Uniform Building Code).

I hereby acknowledge that I have read this application and the information is correct; I agree to comply with any and all codes, ordinances, laws, regulations or restrictions which apply to the project. I understand that failure to comply shall result in legal action, which may include but not necessarily be limited to non-use of the building(s).


Applicant Signature [Signature] Date 10-3-07
 Department Approval JAR Paul Hancock Date _____

Additional water and/or sewer tap fee(s) are required:	YES <input checked="" type="checkbox"/>	NO <input type="checkbox"/>	W/O No. <u>20692</u>
Utility Accounting <u>[Signature]</u>	Date <u>10/16/07</u>		


VALID FOR SIX MONTHS FROM DATE OF ISSUANCE (Section 2.2.C.1 Grand Junction Zoning & Development Code)
 (White: Planning) (Yellow: Customer) (Pink: Building Department) (Goldenrod: Utility Accounting)

ADDITIONAL JAR
 DRIVEWAY
 DECK
 GARAGE
 HOUSE
 PORCH

DUCK
 JAR

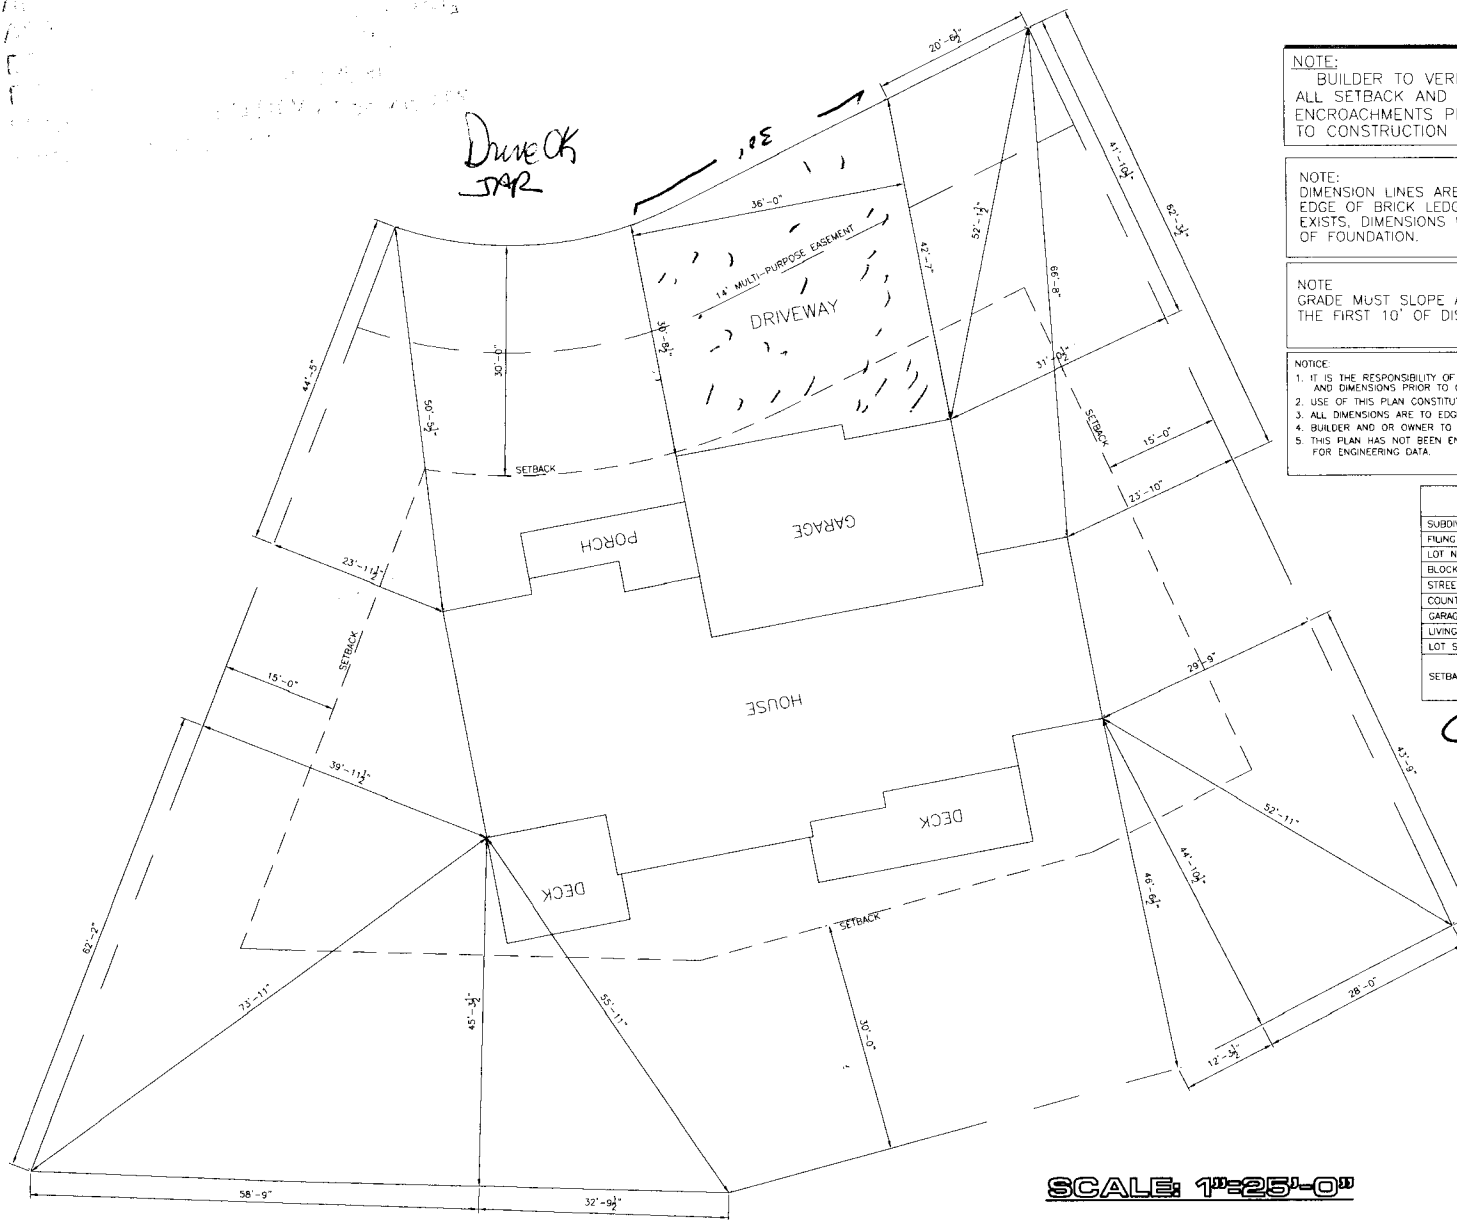

NOTE:
 BUILDER TO VERIFY
 ALL SETBACK AND EASEMENT
 ENCROACHMENTS PRIOR
 TO CONSTRUCTION

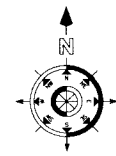

NOTE:
 DIMENSION LINES ARE PULLED FROM
 EDGE OF BRICK LEDGE. IF NO BRICK LEDGE
 EXISTS, DIMENSIONS WILL BE FROM EDGE
 OF FOUNDATION.

NOTE
 GRADE MUST SLOPE AWAY FROM HOUSE 6" OF FALL IN
 THE FIRST 10' OF DISTANCE PER LOCAL BUILDING CODE.

- NOTICE
1. IT IS THE RESPONSIBILITY OF THE BUILDER OR OWNER TO VERIFY ALL DETAILS AND DIMENSIONS PRIOR TO CONSTRUCTION.
 2. USE OF THIS PLAN CONSTITUTES BUILDER AND OR HOME OWNERS ACCEPTANCE OF THESE TERMS.
 3. ALL DIMENSIONS ARE TO EDGE OF FOUNDATION UNLESS OTHERWISE NOTED.
 4. BUILDER AND OR OWNER TO VERIFY ALL SETBACKS AND EASEMENTS.
 5. THIS PLAN HAS NOT BEEN ENGINEERED BY AUTODRAFT. SEE SEPARATE DRAWINGS BY OTHERS FOR ENGINEERING DATA.

SITE PLAN INFORMATION	
SUBDIVISION NAME	CANYON RIM
PLUNG NUMBER	2
LOT NUMBER	6
BLOCK NUMBER	1
STREET ADDRESS	2203 DESERT VARNISH CT
COUNTY	MESA
GARAGE SQ. FT.	-
LIVING SQ. FT.	2428 SF
LOT SIZE	17,746 SF
SETBACKS USED	FRONT 30'
	SIDES 15'
	REAR 30'

Canyon Rim HOA
 OK
 WIM

SCALE: 1"=25'-0"

2203 Desert Varnish Ct.