

FEE \$	10 ⁻
TCP \$	1589 ⁻
SIF \$	460 ⁻

PLANNING CLEARANCE
(Single Family Residential and Accessory Structures)
Community Development Department

BLDG PERMIT NO. _____

Building Address Lake Eldorado Dr
Parcel No. 2945-034-70-022
Subdivision Beehive Estates / The Orchard
Filing 4 Block 4 Lot 22

No. of Existing Bldgs 0 No. Proposed 1
Sq. Ft. of Existing Bldgs 0 Sq. Ft. Proposed 2000
Sq. Ft. of Lot / Parcel 6050
Sq. Ft. Coverage of Lot by Structures & Impervious Surface (Total Existing & Proposed) 2857
Height of Proposed Structure 19'

OWNER INFORMATION:

Name Village Homes of Colorado
Address 607 28 1/4 Rd. Suite 122
City / State / Zip G.J., CO 81506

DESCRIPTION OF WORK & INTENDED USE:

- New Single Family Home (*check type below)
 Interior Remodel Addition
 Other (please specify): _____

APPLICANT INFORMATION:

Name same
Address _____
City / State / Zip _____
Telephone 970 683-5421

***TYPE OF HOME PROPOSED:**

- Site Built Manufactured Home (UBC)
 Manufactured Home (HUD)
 Other (please specify): _____

NOTES: _____

REQUIRED: One plot plan, on 8 1/2" x 11" paper, showing all existing & proposed structure location(s), parking, setbacks to all property lines, ingress/egress to the property, driveway location & width & all easements & rights-of-way which abut the parcel.

THIS SECTION TO BE COMPLETED BY COMMUNITY DEVELOPMENT DEPARTMENT STAFF

ZONE PD
SETBACKS: Front 20 from property line (PL)
Side 5 from PL Rear 10 from PL
Maximum Height of Structure(s) _____
Voting District B Driveway Location Approval KS
(Engineer's Initials)

Maximum coverage of lot by structures 0
Permanent Foundation Required: YES / NO _____
Parking Requirement 2
Special Conditions Engineered foundation required; fire department review prior to permit.

Modifications to this Planning Clearance must be approved, in writing, by the Community Development Department. The structure authorized by this application cannot be occupied until a final inspection has been completed and a Certificate of Occupancy has been issued, if applicable, by the Building Department (Section 305, Uniform Building Code).

I hereby acknowledge that I have read this application and the information is correct; I agree to comply with any and all codes, ordinances, laws, regulations or restrictions which apply to the project. I understand that failure to comply shall result in legal action, which may include but not necessarily be limited to non-use of the building(s).

Applicant Signature [Signature] Date 5/22/07
Department Approval KS Juditha Date 5/24/07



Additional water and/or sewer tap fee(s) are required:	YES <input checked="" type="checkbox"/>	NO <input type="checkbox"/>	W/O No. <u>20300</u>
Utility Accounting <u>[Signature]</u>	Date <u>5/24/07</u>		

PLOT PLAN FOR



LOT 22, SUBDIVISION BEEHIVE ESTATES SUBDIVISION
 CITY OF GRAND JUNCTION, COUNTY OF MESA, STATE OF COLORADO
 ADDRESS 616 ELDERADO DRIVE / THE ORCHARD

LOT 22, AREA = 6,050± SQ. FT.
 MODEL 8403 = 2,857± SQ. FT. W/PORCH, PATIO & DRIVEWAY

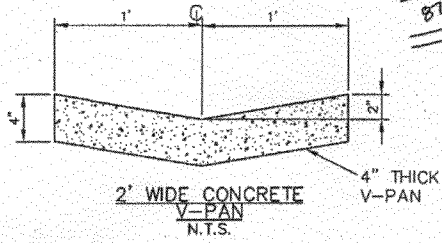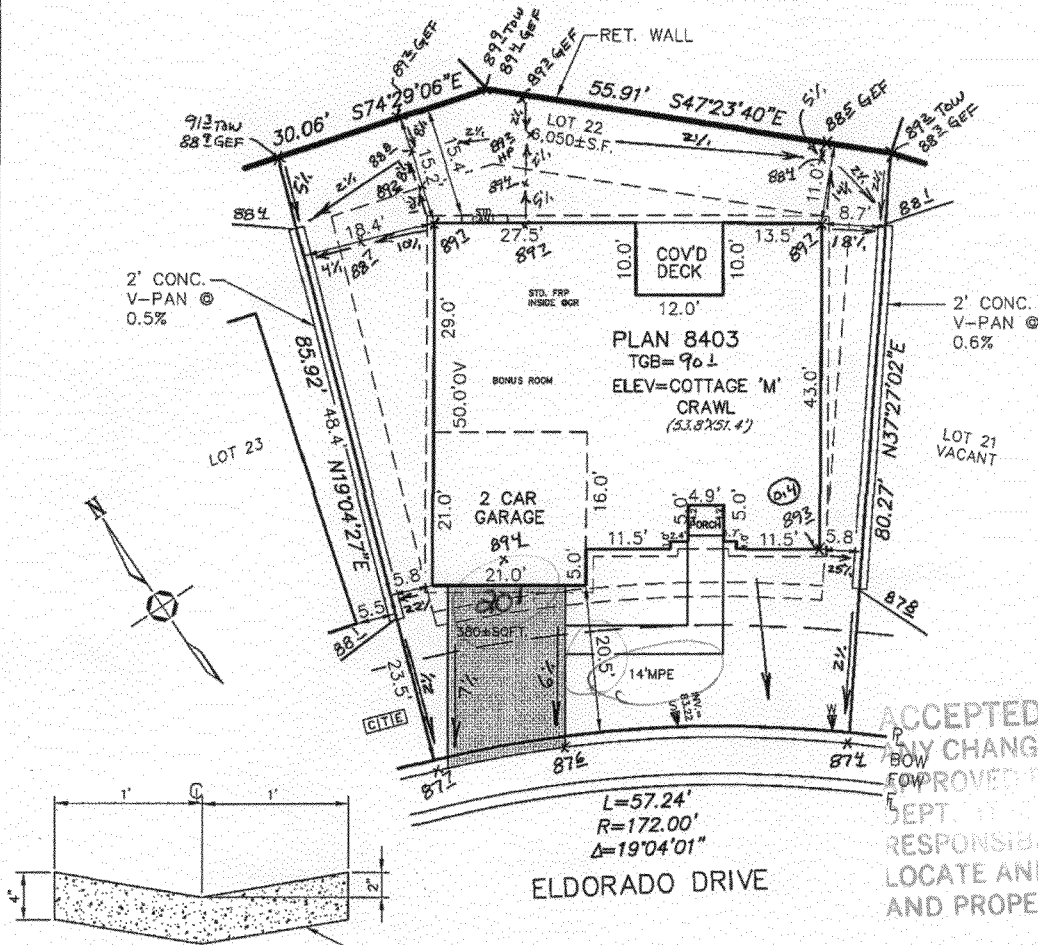

- GENERAL NOTES**
- THIS PLOT PLAN DOES NOT SHOW LOCATION OF WINDOW WELLS. FOR THEIR LOCATION SEE STRUCTURAL ENGINEERED PLANS.
 - THIS PLOT PLAN IS BASED ON INFORMATION PROVIDED TO CARROLL & LANGE BY THE BUILDER / DEVELOPER.
 - DIMENSIONS SHOWN AROUND THE PERIMETER OF THE STRUCTURE ARE TO THE EXTERIOR FOUNDATION CORNERS.
 - PROVIDE AND MAINTAIN POSITIVE DRAINAGE AWAY FROM ALL FOUNDATION WALLS PER WARRANTY REQUIREMENTS. (0.5% MINIMUM SLOPE FOR CONCRETE PANS.)
 - THIS PLOT PLAN SHOWS PROPOSED IMPROVEMENTS ONLY. FINAL CONSTRUCTION MAY VARY.
 - FOR QUESTIONS REGARDING THE FOUNDATION DURING EXCAVATION, FORM SETTING, AND HOUSE CONSTRUCTION REFER TO THE ENGINEERED FOUNDATION PLANS.
 - BEFORE STAKING, THE BUILDER SHOULD VERIFY ALL HOUSE PLAN NUMBERS, DIMENSIONS, ELEVATIONS, AND SETBACKS TO THE PLOT PLAN. IF ANY DISCREPANCY EXISTS PLEASE CONTACT APPROPRIATE PERSON.
 - DRIVEWAY SQUARE FOOTAGE CALCULATION IS BASED ON FOLLOWING ASSUMPTIONS:
 - WIDTH=18.0' LENGTH=FACE OF GARAGE TO BACK OF WALK.
 - AREA IN RIGHT OF WAY IS QUANTIFIED SEPARATELY. THIS IS A BASIC CALCULATION AND IS NOT AN ESTIMATE OF EXACT QUANTITIES REQUIRED.

ACCEPTED *W. Indochi Rice*
 ANY CHANGE OF SETBACKS MUST BE APPROVED BY THE CITY PLANNING DEPT. IT IS THE APPLICANT'S RESPONSIBILITY TO PROPERLY LOCATE AND IDENTIFY EASEMENTS AND PROPERTY LINES

LEVEL NOTES:

BOW _____
 + _____
 H _____
 - _____ TGB _____
 HUB _____ ELEV _____
 ELEV + _____ HUB _____
 H _____ ELEV _____
 - _____ FILL= _____

CHECK IN _____ / _____

HSE STK	BY	DATE
HSE RESTK	BY	DATE
FDN	BY	DATE
ISP/GRD	BY	DATE
HBW/GRD	BY	DATE
REGRD	BY	DATE
REGRD	BY	DATE

NOTES OF CONCERN:

- LOCATE WATER METER PIT, LIGHT POLE, MANHOLES OR ANYTHING ELSE THAT MAY AFFECT THE DRIVEWAY LOCATION AND CALL OFFICE.

LEGEND:

R=PROPERTY LINE
 BOW=BACK OF WALK
 FOW=FRONT OF WALK
 E=FLOW LINE

----- EASEMENT
 - - - - - SETBACK
 ⊕ =ELEVATION ADJUSTING NUMBER

Carroll & Lange
 Professional Engineers & Land Surveyors
 166 South Union Blvd., Suite 156
 Lakewood, Colorado 80228
 (303) 980-0200

CALL UTILITY NOTIFICATION CENTER OF COLORADO
 1-800-922-1987
 OR 303-534-6700
 IN METRO DENVER
 CALL 2-BUSINESS DAYS IN ADVANCE BEFORE YOU DIG, GRADE, OR EXCAVATE FOR THE MARKING OF UNDERGROUND MEMBER UTILITIES

MINIMUM SETBACKS:
 FRONT: 20' TO GAR./14' TO HSE EAVE
 REAR: 10' SIDE: 5'
 STREET SIDE: 20'
 MIN BETWEEN STRUCTS.: 10'

SCALE: 1"=20'
 DATE: 5-16-07 FRD
 REV: _____
 REV: _____
 JOB NO: 3659