

FEE \$ 10:00
 TCP \$ 1589.00
 SIF \$ 460.00

PLANNING CLEARANCE
 (Single Family Residential and Accessory Structures)
Community Development Department

BLDG PERMIT NO. _____

Building Address 2785 Helena Ct
 Parcel No. 2945-244-45-~~018~~ 018
 Subdivision Carriage Hills
 Filing N/A Block 1 Lot 18

No. of Existing Bldgs 0 No. Proposed 1
 Sq. Ft. of Existing Bldgs 0 Sq. Ft. Proposed 1398
 Sq. Ft. of Lot / Parcel 5643
 Sq. Ft. Coverage of Lot by Structures & Impervious Surface
 (Total Existing & Proposed) 2,340 = 4170
 Height of Proposed Structure 20

OWNER INFORMATION:

Name B+G Excavation + Concrete LLC.
 Address 2482 Commerce Blvd
 City / State / Zip Grand Junction, Co 81503

DESCRIPTION OF WORK & INTENDED USE:

New Single Family Home (*check type below)
 Interior Remodel Addition
 Other (please specify): _____

APPLICANT INFORMATION:

Name Lawrence Balerio
 Address 3131 B Rd
 City / State / Zip Grand Junction, Co 81503
 Telephone (970) 234-2052

***TYPE OF HOME PROPOSED:**

Site Built Manufactured Home (UBC)
 Manufactured Home (HUD)
 Other (please specify): _____

NOTES: _____

REQUIRED: One plot plan, on 8 1/2" x 11" paper, showing all existing & proposed structure location(s), parking, setbacks to all property lines, ingress/egress to the property, driveway location & width & all easements & rights-of-way which abut the parcel.

THIS SECTION TO BE COMPLETED BY COMMUNITY DEVELOPMENT DEPARTMENT STAFF			
ZONE <u>R-8</u>	Maximum coverage of lot by structures <u>70%</u>		
SETBACKS: Front <u>20</u> from property line (PL)	Permanent Foundation Required: YES _____ NO _____		
Side <u>5</u> from PL Rear <u>10</u> from PL	Parking Requirement _____		
Maximum Height of Structure(s) <u>35'</u>	Special Conditions _____		
Voting District <u>E</u>	Driveway Location Approval <u>JAR</u> (Engineer's Initials)		


Modifications to this Planning Clearance must be approved, in writing, by the Community Development Department. The structure authorized by this application cannot be occupied until a final inspection has been completed and a Certificate of Occupancy has been issued, if applicable, by the Building Department (Section 305, Uniform Building Code).

I hereby acknowledge that I have read this application and the information is correct; I agree to comply with any and all codes, ordinances, laws, regulations or restrictions which apply to the project. I understand that failure to comply shall result in legal action, which may include but not necessarily be limited to non-use of the building(s).

Applicant Signature Lawrence Balerio Date 12/21/07
 Department Approval JAR Pat O'Connell Date 12/24/07


Additional water and/or sewer tap fee(s) are required: YES <input checked="" type="checkbox"/> NO <input type="checkbox"/>	W/O No. <u>20825</u>
Utility Accounting <u>[Signature]</u>	Date <u>12-24-07</u>

VALID FOR SIX MONTHS FROM DATE OF ISSUANCE (Section 2.2.C.1 Grand Junction Zoning & Development Code)
 (White: Planning) (Yellow: Customer) (Pink: Building Department) (Goldenrod: Utility Accounting)

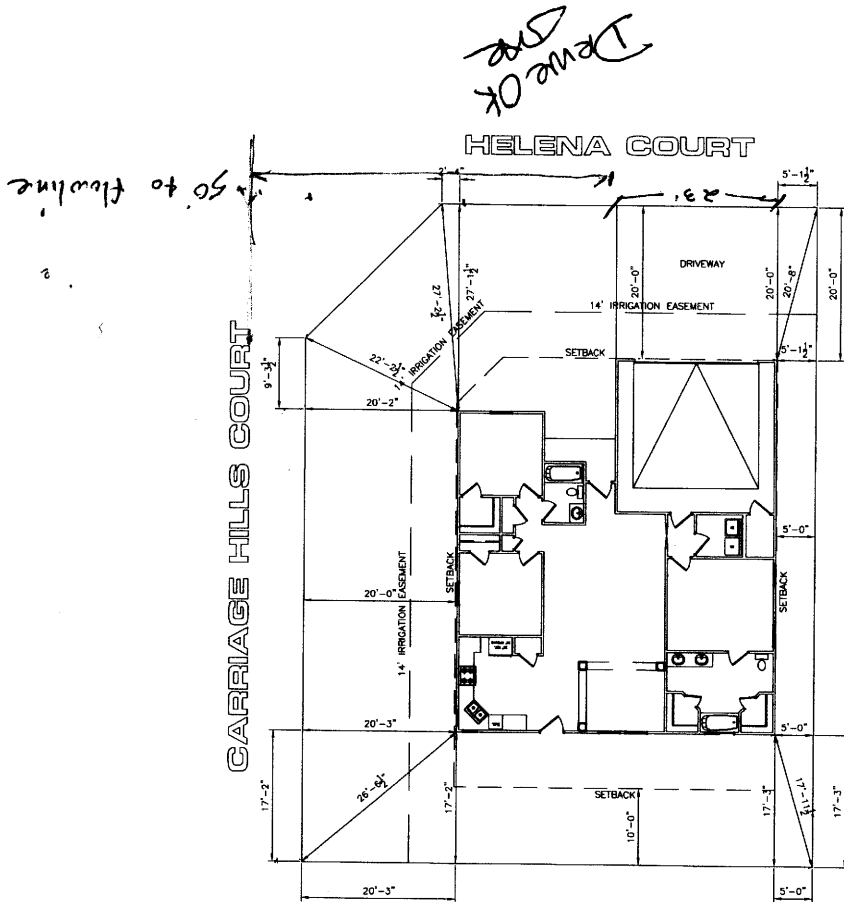

ACCEPTED *OR Pat Hunt*
 ANY CHANGE OF SETBACKS MUST BE APPROVED BY THE CITY PLANNING DIVISION. IT IS THE APPLICANT'S RESPONSIBILITY TO PROPERLY LOCATE AND IDENTIFY EASEMENTS AND PROPERTY LINES.

NOTE:
 BUILDER TO VERIFY ALL SETBACK AND EASEMENT ENCROACHMENTS PRIOR TO CONSTRUCTION

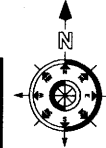

NOTE:
 DIMENSION LINES ARE PULLED FROM EDGE OF BRICK LEDGE. IF NO BRICK LEDGE EXISTS, DIMENSIONS WILL BE FROM EDGE OF FOUNDATION.


NOTE:
 GRADE MUST SLOPE AWAY FROM HOUSE 6" OF FALL IN THE FIRST 10' OF DISTANCE PER LOCAL BUILDING CODE.

- NOTICE:
1. IT IS THE RESPONSIBILITY OF THE BUILDER OR OWNER TO VERIFY ALL DETAILS AND DIMENSIONS PRIOR TO CONSTRUCTION.
 2. USE OF THIS PLAN CONSTITUTES BUILDER AND OR HOME OWNERS ACCEPTANCE OF THESE TERMS.
 3. ALL DIMENSIONS ARE TO EDGE OF FOUNDATION UNLESS OTHER WISE NOTED.
 4. BUILDER AND OR OWNER TO VERIFY ALL SETBACKS AND EASEMENTS.
 5. THIS PLAN HAS NOT BEEN ENGINEERED BY AUTODRAFT. SEE SEPARATE DRAWINGS BY OTHERS FOR ENGINEERING DATA.

SITE PLAN INFORMATION	
SUBDIVISION NAME	CARRIAGE HILLS
FILING NUMBER	N/A
LOT NUMBER	18
BLOCK NUMBER	1
STREET ADDRESS	?
COUNTY	MESA
GARAGE SQ. FT.	442
COVERED ENTRY SQ. FT.	?
COVERED PATIO SQ. FT.	?
LIVING SQ. FT.	1398
LOT SIZE	5643
SETBACKS USED	FRONT 20'
	SIDES 5'
	REAR 10'

REVISIONS	
1	
2	
3	
4	
5	
6	
7	

AUTODRAFT
 COMPUTER AIDED DRAFTING
 GRAND JUNCTION, CO (970) 241-8782

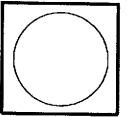

THE COLORADO
 CARRIAGE HILLS

Drawn BY	AUTODRAFT
FILE NAME	
DATE	12-10-07
SCALE	1/8" = 1'-0"
SHEET	SITE