

FEE \$	10.00
TCP \$	0
SIF \$	0

# PLANNING CLEARANCE

(Single Family Residential and Accessory Structures)

**Community Development Department**

BLDG PERMIT NO. \_\_\_\_\_

66786-36158

Building Address 3510 Hollow CT  
 Parcel No. 2945 014 51 004  
 Subdivision KNOLL  
 Filing \_\_\_\_\_ Block \_\_\_\_\_ Lot \_\_\_\_\_

No. of Existing Bldgs 2 No. Proposed \_\_\_\_\_  
 Sq. Ft. of Existing Bldgs 2922 Sq. Ft. Proposed 181  
 Sq. Ft. of Lot / Parcel \_\_\_\_\_  
 Sq. Ft. Coverage of Lot by Structures & Impervious Surface (Total Existing & Proposed) \_\_\_\_\_  
 Height of Proposed Structure 12 ft

**OWNER INFORMATION:**

Name CAROLYN & GENE LEIDERMAN  
 Address 3510 Hollow CT  
 City / State / Zip GRAND JUNCTION, CO

**DESCRIPTION OF WORK & INTENDED USE:**

New Single Family Home (\*check type below)  
 Interior Remodel  Addition  
 Other (please specify): \_\_\_\_\_

**APPLICANT INFORMATION:**

Name DURA SYSTEMS  
 Address 269 VILLAGE LN  
 City / State / Zip GRAND JUNCTION, CO  
 Telephone 245 6894

**\*TYPE OF HOME PROPOSED:**  
 Site Built  Manufactured Home (UBC)  
 Manufactured Home (HUD)  
 Other (please specify): \_\_\_\_\_

NOTES: 10'9" x 17' Enclosed Porch

**REQUIRED: One plot plan, on 8 1/2" x 11" paper, showing all existing & proposed structure location(s), parking, setbacks to all property lines, ingress/egress to the property, driveway location & width & all easements & rights-of-way which abut the parcel.**

THIS SECTION TO BE COMPLETED BY COMMUNITY DEVELOPMENT DEPARTMENT STAFF			
ZONE <u>PD</u>	Maximum coverage of lot by structures <u>35%</u>		
SETBACKS: Front <u>20'</u> from property line (PL)	Permanent Foundation Required: YES <input checked="" type="checkbox"/> NO _____		
Side <u>10'</u> from PL Rear <u>20'</u> from PL	Parking Requirement <u>2</u>		
Maximum Height of Structure(s) <u>32'</u>	Special Conditions _____		
Voting District _____	Driveway Location Approval _____ (Engineer's Initials)		


Modifications to this Planning Clearance must be approved, in writing, by the Community Development Department. The structure authorized by this application cannot be occupied until a final inspection has been completed and a Certificate of Occupancy has been issued, if applicable, by the Building Department (Section 305, Uniform Building Code).

I hereby acknowledge that I have read this application and the information is correct; I agree to comply with any and all codes, ordinances, laws, regulations or restrictions which apply to the project. I understand that failure to comply shall result in legal action, which may include but not necessarily be limited to non-use of the building(s).

Applicant Signature William Tiefenbach Date 2-20-07  
 Department Approval Gayleen Henderson Date 2-20-07

Additional water and/or sewer tap fee(s) are required:	YES	NO	W/O No. <u>No wtr / No SWK Change</u>
Utility Accounting <u>2</u>	Date <u>2/20/07</u>		

VALID FOR SIX MONTHS FROM DATE OF ISSUANCE (Section 2.2.C.1 Grand Junction Zoning & Development Code)  
 (White: Planning) (Yellow: Customer) (Pink: Building Department) (Goldenrod: Utility Accounting)

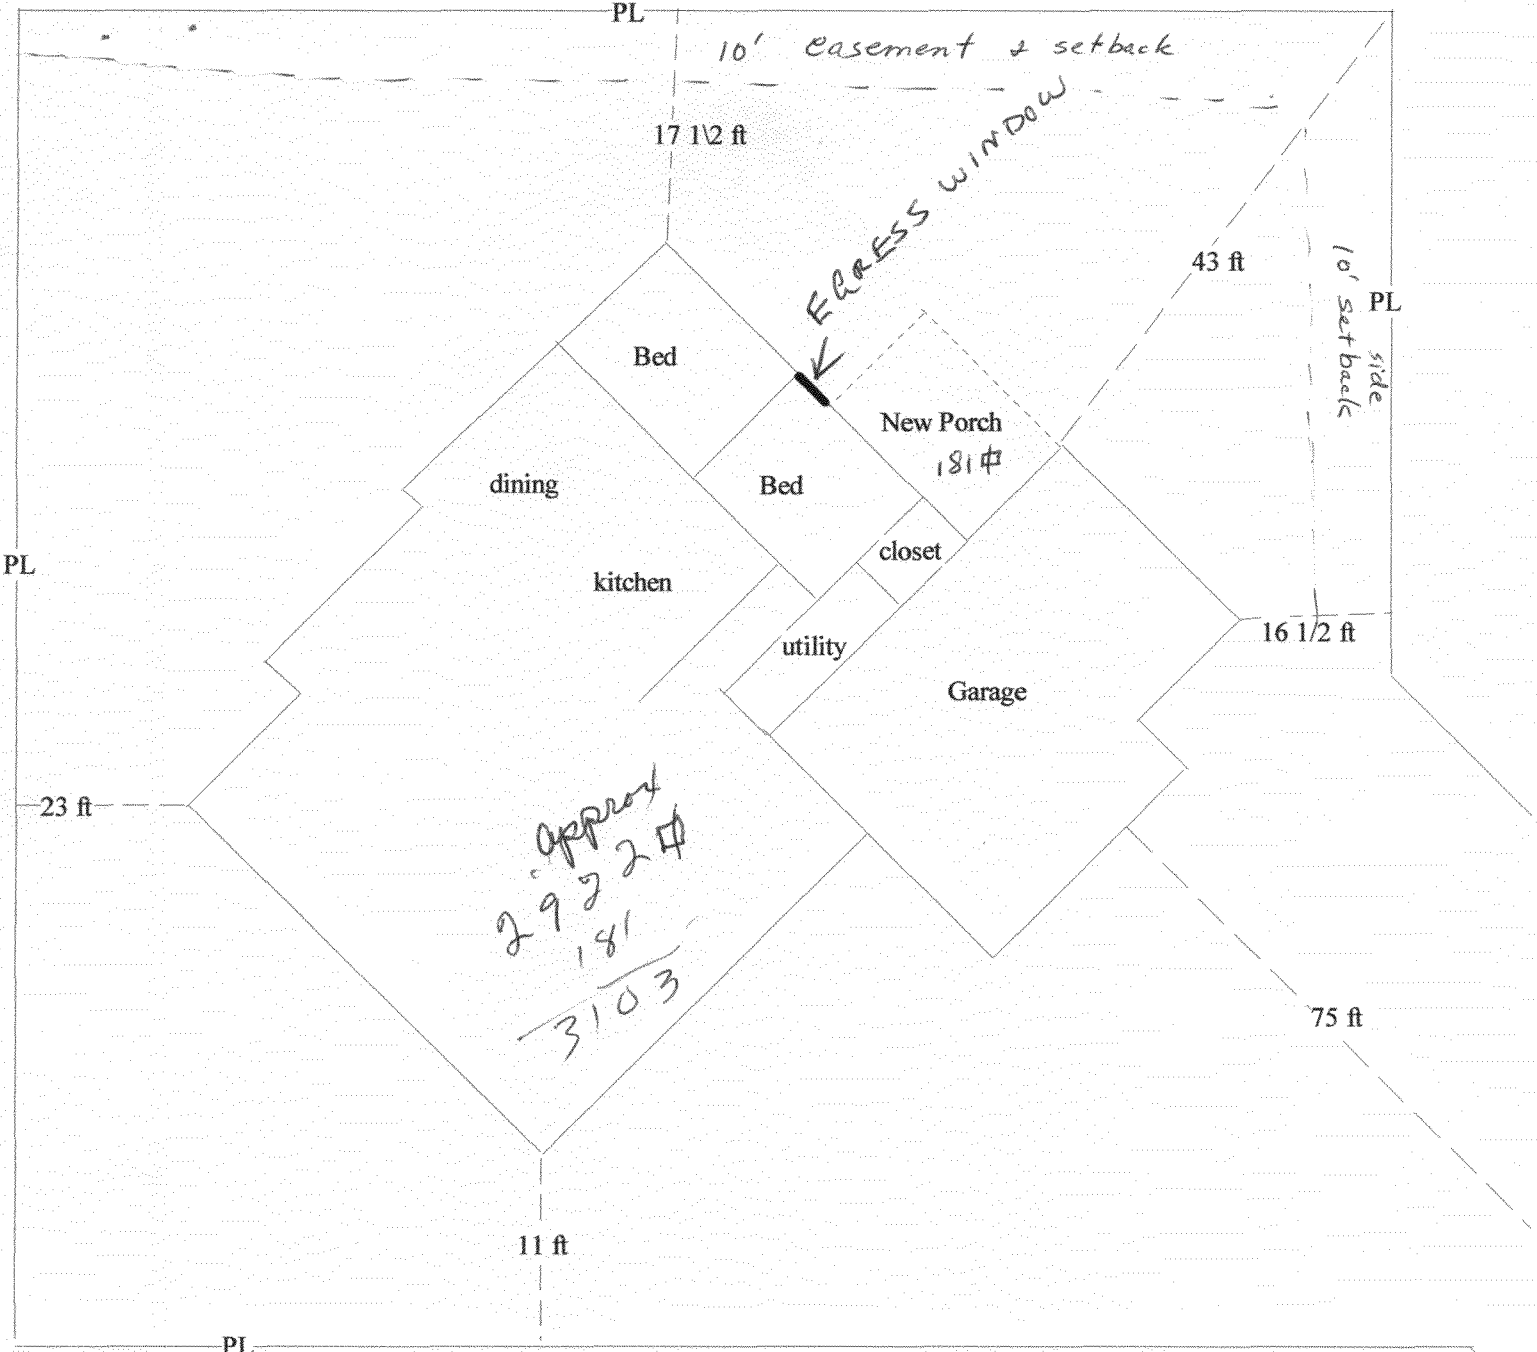

2-20-07 *Gayle Anderson*  
 ACCEPTED  
 ANY CHANGE OF SETBACKS MUST BE APPROVED BY THE CITY PLANNING DEPT. IT IS THE APPLICANT'S RESPONSIBILITY TO PROPERLY LOCATE AND IDENTIFY EASEMENTS AND PROPERTY LINES.