

FEE \$ 10.00
 TCP \$ 1589.00
 SIF \$ 460.00

PLANNING CLEARANCE
 (Single Family Residential and Accessory Structures)
Community Development Department

BLDG PERMIT NO. _____ *d*

Building Address 289 Holly Lane
 Parcel No. Lot 2745-2512-34-002
 Subdivision Allen Simple Sub.
 Filing _____ Block _____ Lot 2

No. of Existing Bldgs 0 No. Proposed 1
 Sq. Ft. of Existing Bldgs 0 Sq. Ft. Proposed 1300 sf.
 Sq. Ft. of Lot / Parcel .17 A 7,364
 Sq. Ft. Coverage of Lot by Structures & Impervious Surface
 (Total Existing & Proposed) _____
 Height of Proposed Structure _____

OWNER INFORMATION:

Name Jane Clevinger
 Address 2701 Hwy 50
 City / State / Zip Grand Jct., CO 81503

DESCRIPTION OF WORK & INTENDED USE:

New Single Family Home (*check type below)
 Interior Remodel Addition
 Other (please specify): _____

APPLICANT INFORMATION:

Name Jane Clevinger
 Address 2701 Hwy 50
 City / State / Zip Grand Jct., CO 81503
 Telephone 216-4726

***TYPE OF HOME PROPOSED:**

Site Built Manufactured Home (UBC)
 Manufactured Home (HUD)
 Other (please specify): _____

NOTES: _____

REQUIRED: One plot plan, on 8 1/2" x 11" paper, showing all existing & proposed structure location(s), parking, setbacks to all property lines, ingress/egress to the property, driveway location & width & all easements & rights-of-way which abut the parcel.

THIS SECTION TO BE COMPLETED BY COMMUNITY DEVELOPMENT DEPARTMENT STAFF	
ZONE <u>R-8</u>	Maximum coverage of lot by structures <u>70%</u>
SETBACKS: Front <u>20'</u> from property line (PL)	Permanent Foundation Required: YES <input checked="" type="checkbox"/> NO <input type="checkbox"/>
Side <u>5'</u> from PL Rear <u>10'</u> from PL	Parking Requirement <u>2</u>
Maximum Height of Structure(s) <u>35'</u>	Special Conditions _____
Voting District <u>E</u>	Driveway Location Approval <u>gH</u> (Engineer's Initials)

05
06
01
11
02

Modifications to this Planning Clearance must be approved, in writing, by the Community Development Department. The structure authorized by this application cannot be occupied until a final inspection has been completed and a Certificate of Occupancy has been issued, if applicable, by the Building Department (Section 305, Uniform Building Code).


I hereby acknowledge that I have read this application and the information is correct; I agree to comply with any and all codes, ordinances, laws, regulations or restrictions which apply to the project. I understand that failure to comply shall result in legal action, which may include but not necessarily be limited to non-use of the building(s).

Applicant Signature Jane Clevinger Date 5/30/07
 Department Approval gH Judith A. [Signature] Date 6/7/07 86090

4604

Additional water and/or sewer tap fee(s) are required: YES <input checked="" type="checkbox"/> NO <input type="checkbox"/>	W/O No. <u>prem 1081A</u>
Utility Accounting <u>Kasey Gelsberg</u>	Date <u>6/7/07</u> <u>12272</u>

VALID FOR SIX MONTHS FROM DATE OF ISSUANCE (Section 2.2.C.1 Grand Junction Zoning & Development Code)
 (White: Planning) (Yellow: Customer) (Pink: Building Department) (Goldenrod: Utility Accounting)

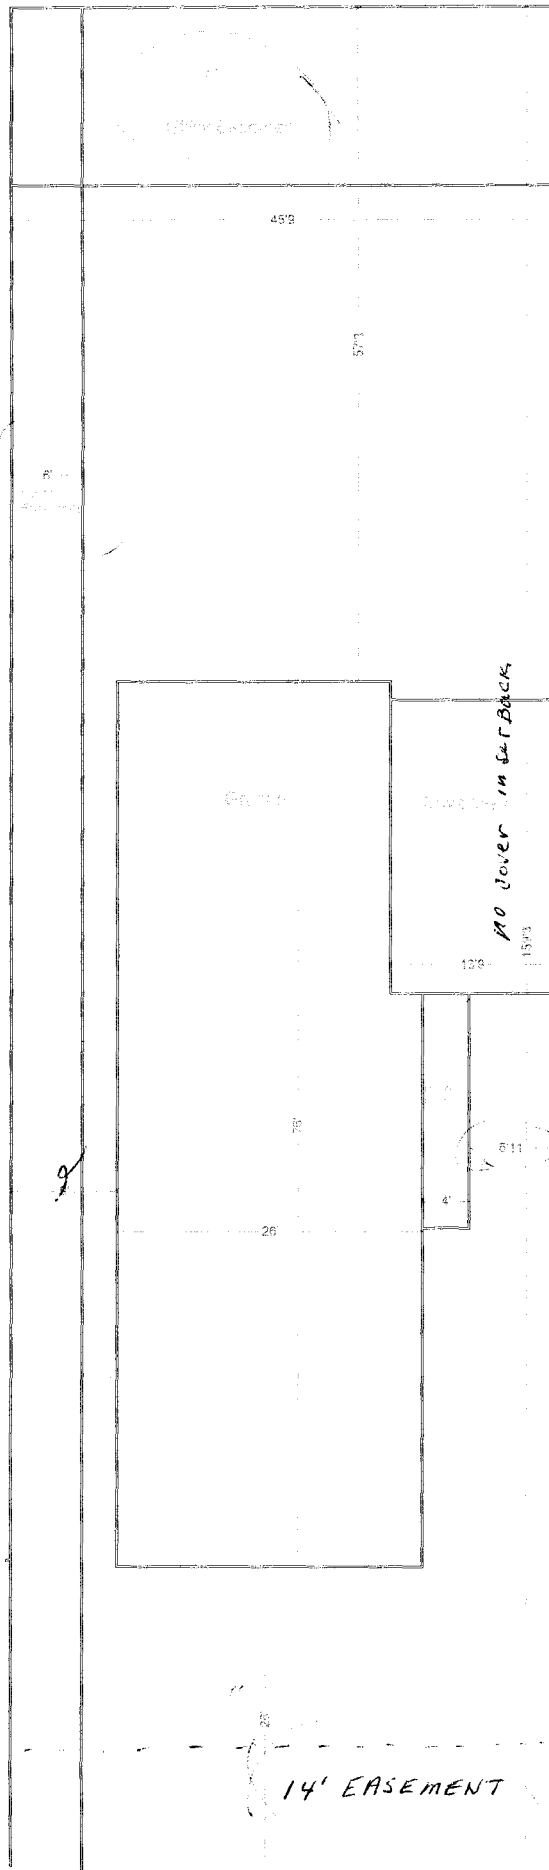

316 Jindori Road 6/7/04