

FEE \$	10.00
TCP \$	1589.00
SIF \$	460.00

PLANNING CLEARANCE
 (Single Family Residential and Accessory Structures)
Community Development Department

BLDG PERMIT NO. _____

Building Address 2841 Kelso Mesa
 Parcel No. 2943-303-00-045
 Subdivision Mesa Estates
 Filing 1 Block 3 Lot 22

No. of Existing Bldgs 0 No. Proposed 1
 Sq. Ft. of Existing Bldgs 1719 Sq. Ft. Proposed _____
 Sq. Ft. of Lot / Parcel 5400
 Sq. Ft. Coverage of Lot by Structures & Impervious Surface
 (Total Existing & Proposed) _____
 Height of Proposed Structure 20'

OWNER INFORMATION:

Name Davidson Homes at Mesa Estates
 Address 2139 N. 12th St #10 PMB 9233
 City / State / Zip Grand Jct CO 81501

DESCRIPTION OF WORK & INTENDED USE:

- New Single Family Home (*check type below)
 Interior Remodel Addition
 Other (please specify): _____

APPLICANT INFORMATION:

Name Steve Vaytilla
 Address 2139 N. 12th St #10 PMB 9233
 City / State / Zip Grand Jct Co 81501
 Telephone 234-2000

***TYPE OF HOME PROPOSED:**

- Site Built Manufactured Home (UBC)
 Manufactured Home (HUD)
 Other (please specify): _____

NOTES: New Residence

REQUIRED: One plot plan, on 8 1/2" x 11" paper, showing all existing & proposed structure location(s), parking, setbacks to all property lines, ingress/egress to the property, driveway location & width & all easements & rights-of-way which abut the parcel.

THIS SECTION TO BE COMPLETED BY COMMUNITY DEVELOPMENT DEPARTMENT STAFF	
ZONE <u>RMF-8</u>	Maximum coverage of lot by structures <u>70%</u>
SETBACKS: Front <u>20'</u> from property line (PL)	Permanent Foundation Required: YES <input checked="" type="checkbox"/> NO <input type="checkbox"/>
Side <u>5'</u> from PL Rear <u>10'</u> from PL	Parking Requirement <u>2</u>
Maximum Height of Structure(s) <u>35'</u>	Special Conditions _____
Voting District <u>E</u> Driveway Location Approval <u>SDA</u> (Engineer's Initials)	_____

Modifications to this Planning Clearance must be approved, in writing, by the Community Development Department. The structure authorized by this application cannot be occupied until a final inspection has been completed and a Certificate of Occupancy has been issued, if applicable, by the Building Department (Section 305, Uniform Building Code).

I hereby acknowledge that I have read this application and the information is correct; I agree to comply with any and all codes, ordinances, laws, regulations or restrictions which apply to the project. I understand that failure to comply shall result in legal action, which may include but not necessarily be limited to non-use of the building(s).

Applicant Signature Steve Vaytilla Date 2/9/07

Department Approval SDA Date 4/4/07

Additional water and/or sewer tap fee(s) are required: YES <input checked="" type="checkbox"/> NO <input type="checkbox"/>	W/O No. <u>pd @ omsd</u>
Utility Accounting <u>SDA</u>	Date <u>4/4/07</u>

VALID FOR SIX MONTHS FROM DATE OF ISSUANCE (Section 2.2.C.1 Grand Junction Zoning & Development Code)
 (White: Planning) (Yellow: Customer) (Pink: Building Department) (Goldenrod: Utility Accounting)

SITE PLAN

DAVIDSON HOMES


MESA ESTATES

2841 KELSO MESA DRIVE

GRAND JUNCTION, MESA COUNTY, COLORADO

TAX ID 2943-303-00-045 LOT 22 BLOCK 3

*Driveway OK
3/14*

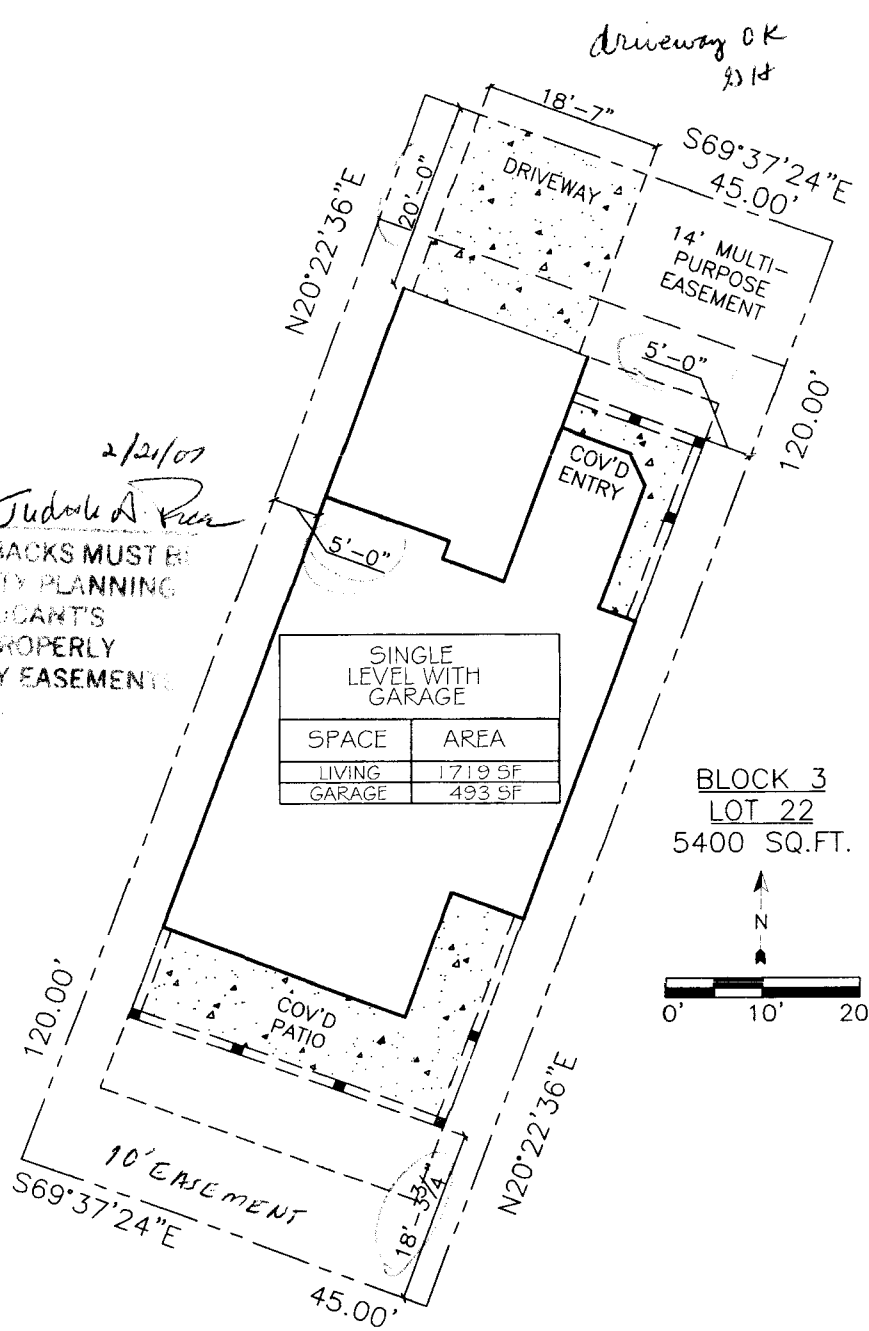

ACCEPTED *2/21/07*
D.H. Judah A. Pica
ANY CHANGE OF SETBACKS MUST BE APPROVED BY CITY PLANNING DEPARTMENT. APPLICANT'S LOCATION AND IDENTIFY EASEMENTS AND PROPERTY LINES.

SINGLE LEVEL WITH GARAGE	
SPACE	AREA
LIVING	1719 SF
GARAGE	493 SF

BLOCK 3
LOT 22
5400 SQ.FT.

RMF - 8		
Minimum Setbacks		
Front	Side	Rear
20	5	10

SITE PLAN
SCALE: 1" = 20'-0"

ACTION ELECTRIC	7174
TOPS/GAS	2060723
TOPS/MASTER	187254
PRECISION CONSTRUCTION	2060561