

FEE \$	10 ⁰⁰
TCP \$	1589 ⁰⁰
SIF \$	460 ⁰⁰

PLANNING CLEARANCE
(Single Family Residential and Accessory Structures)
Community Development Department

BLDG PERMIT NO. _____

Building Address 2849 Kelso Mesa
Parcel No. 2943-303-00-045
Subdivision Mesa Estates
Filing 1 Block 3 Lot 15

No. of Existing Bldgs 0 No. Proposed 1
Sq. Ft. of Existing Bldgs 0 Sq. Ft. Proposed 1570
Sq. Ft. of Lot / Parcel 5400
Sq. Ft. Coverage of Lot by Structures & Impervious Surface (Total Existing & Proposed) _____
Height of Proposed Structure 20'

OWNER INFORMATION:

Name Davidson Homes at Mesa Estates
Address 2139 N. 12th St #10 PMB 9233
City / State / Zip Grand Jct. CO 81501

DESCRIPTION OF WORK & INTENDED USE:

New Single Family Home (*check type below)
 Interior Remodel Addition
 Other (please specify): _____

APPLICANT INFORMATION:

Name Steve Vaytilla
Address 2139 N. 12th St #10 PMB 9233
City / State / Zip Grand Jct. CO 81501
Telephone 234-2000

***TYPE OF HOME PROPOSED:**

Site Built Manufactured Home (UBC)
 Manufactured Home (HUD)
 Other (please specify): _____

NOTES: New Home

REQUIRED: One plot plan, on 8 1/2" x 11" paper, showing all existing & proposed structure location(s), parking, setbacks to all property lines, ingress/egress to the property, driveway location & width & all easements & rights-of-way which abut the parcel.

THIS SECTION TO BE COMPLETED BY COMMUNITY DEVELOPMENT DEPARTMENT STAFF	
ZONE <u>RMF-8</u>	Maximum coverage of lot by structures <u>70%</u>
SETBACKS: Front <u>20'</u> from property line (PL)	Permanent Foundation Required: YES <u>X</u> NO _____
Side <u>5'</u> from PL Rear <u>10'</u> from PL	Parking Requirement <u>2</u>
Maximum Height of Structure(s) <u>35'</u>	Special Conditions _____
Voting District <u>E</u> Driveway Location Approval <u>WV</u> (Engineer's Initials)	_____

Modifications to this Planning Clearance must be approved, in writing, by the Community Development Department. The structure authorized by this application cannot be occupied until a final inspection has been completed and a Certificate of Occupancy has been issued, if applicable, by the Building Department (Section 305, Uniform Building Code).

I hereby acknowledge that I have read this application and the information is correct; I agree to comply with any and all codes, ordinances, laws, regulations or restrictions which apply to the project. I understand that failure to comply shall result in legal action, which may include but not necessarily be limited to non-use of the building(s).

Applicant Signature Steve Vaytilla Date 2/21/07


Department Approval JAR Wendy Spore Date 4-13-07

Additional water and/or sewer tap fee(s) are required: YES NO W/O No Paid @ OMSD.

Utility Accounting Kate Gebbeny Date 4/13/07


VALID FOR SIX MONTHS FROM DATE OF ISSUANCE (Section 2.2.C.1 Grand Junction Zoning & Development Code)
(White: Planning) (Yellow: Customer) (Pink: Building Department) (Goldenrod: Utility Accounting)

SITE PLAN
DAVIDSON HOMES
MESA ESTATES
2849 KELSO MESA DRIVE
GRAND JUNCTION, MESA COUNTY, COLORADO
TAX ID 2943-303-00-045 LOT 15 BLOCK 3

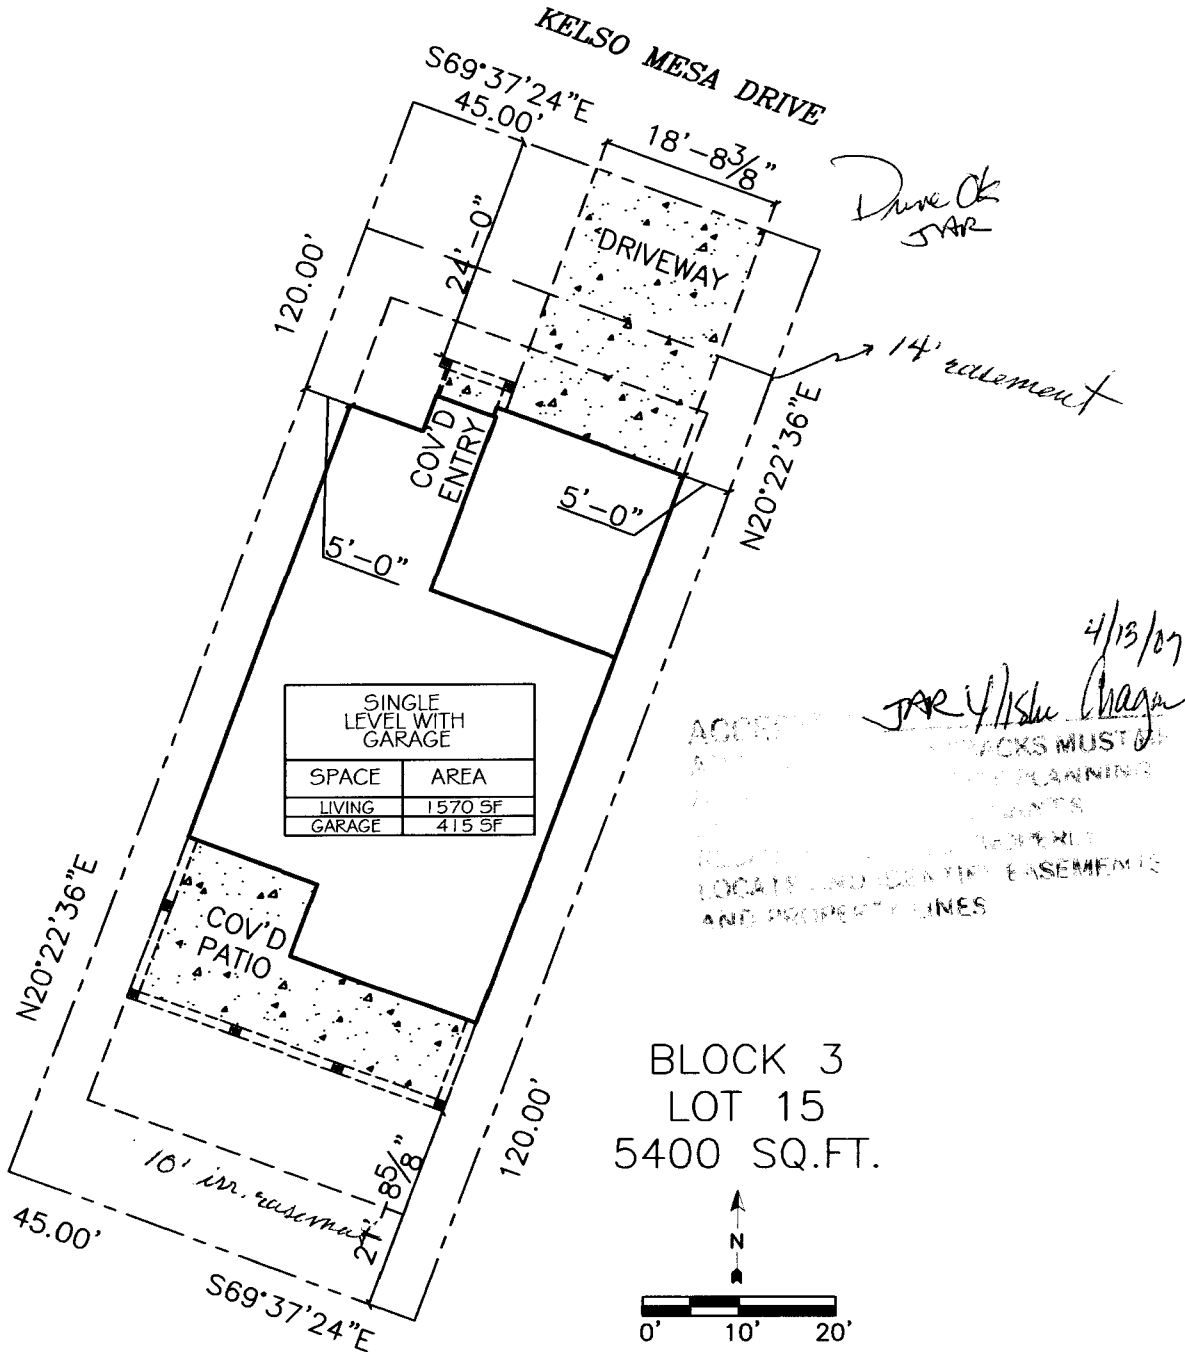

SINGLE LEVEL WITH GARAGE	
SPACE	AREA
LIVING	1570 SF
GARAGE	415 SF

BLOCK 3
 LOT 15
 5400 SQ.FT.

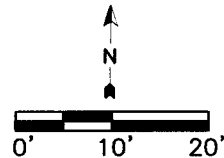

RMF - 8		
Minimum Setbacks		
Front	Side	Rear
20	5	10

SITE PLAN
 SCALE: 1" = 20'-0"

ACTION ELECTRIC	7174
TOPS/GAS	2071133
TOPS/MASTER	2071134
PRECISION CONSTRUCTION	2070879