

FEE \$	10.00
TCP \$	1589.00
SIF \$	460.00

PLANNING CLEARANCE
 (Single Family Residential and Accessory Structures)
Community Development Department

BLDG PERMIT NO. _____

Building Address 2839 1/2 Kelso Mesa
 Parcel No. 2943-303-00045
 Subdivision Mesa Estates
 Filing 1 Block 23 Lot 23

No. of Existing Bldgs 0 No. Proposed 1
 Sq. Ft. of Existing Bldgs 1523 Sq. Ft. Proposed _____
 Sq. Ft. of Lot / Parcel 75400
 Sq. Ft. Coverage of Lot by Structures & Impervious Surface (Total Existing & Proposed) _____
 Height of Proposed Structure 20'

OWNER INFORMATION:

Name Davidson Homes at Mesa Estates
 Address 2139 N. 12th St. #10 PMB 9233
 City / State / Zip Grand Junction, CO 81501

DESCRIPTION OF WORK & INTENDED USE:
 New Single Family Home (*check type below)
 Interior Remodel Addition
 Other (please specify): _____

APPLICANT INFORMATION:

Name Steve Vaytilla
 Address 2139 N. 12th St #10 PMB 9233
 City / State / Zip Grand Junction, CO 81501
 Telephone _____

*TYPE OF HOME PROPOSED:
 Site Built Manufactured Home (UBC)
 Manufactured Home (HUD)
 Other (please specify): _____

NOTES: New Residence

REQUIRED: One plot plan, on 8 1/2" x 11" paper, showing all existing & proposed structure location(s), parking, setbacks to all property lines, ingress/egress to the property, driveway location & width & all easements & rights-of-way which abut the parcel.

THIS SECTION TO BE COMPLETED BY COMMUNITY DEVELOPMENT DEPARTMENT STAFF			
ZONE <u>RMF-8</u>	Maximum coverage of lot by structures <u>70%</u>		
SETBACKS: Front <u>20'</u> from property line (PL)	Permanent Foundation Required: YES <u>X</u> NO _____		
Side <u>5'</u> from PL Rear <u>10'</u> from PL	Parking Requirement <u>2</u>		
Maximum Height of Structure(s) <u>35'</u>	Special Conditions _____		
Voting District <u>E</u>	Driveway Location Approval _____		
	(Engineer's Initials)		

Modifications to this Planning Clearance must be approved, in writing, by the Community Development Department. The structure authorized by this application cannot be occupied until a final inspection has been completed and a Certificate of Occupancy has been issued, if applicable, by the Building Department (Section 305, Uniform Building Code).

I hereby acknowledge that I have read this application and the information is correct; I agree to comply with any and all codes, ordinances, laws, regulations or restrictions which apply to the project. I understand that failure to comply shall result in legal action, which may include but not necessarily be limited to non-use of the building(s).

Applicant Signature Steve Vaytilla Date 9/5/07
 Department Approval NA Date _____

Additional water and/or sewer tap fee(s) are required: YES <input checked="" type="checkbox"/> NO <input type="checkbox"/>	W/O No. <u>paid @ CUSD</u>
Utility Accounting <u>[Signature]</u>	Date <u>3-27-07</u>

VALID FOR SIX MONTHS FROM DATE OF ISSUANCE (Section 2.2.C.1 Grand Junction Zoning & Development Code)
 (White: Planning) (Yellow: Customer) (Pink: Building Department) (Goldenrod: Utility Accounting)

SITE PLAN


DAVIDSON HOMES

MESA ESTATES

2839 1/2 KELSO MESA DRIVE


GRAND JUNCTION, MESA COUNTY, COLORADO

TAX ID 2943-303-00-045 LOT 23 BLOCK 3

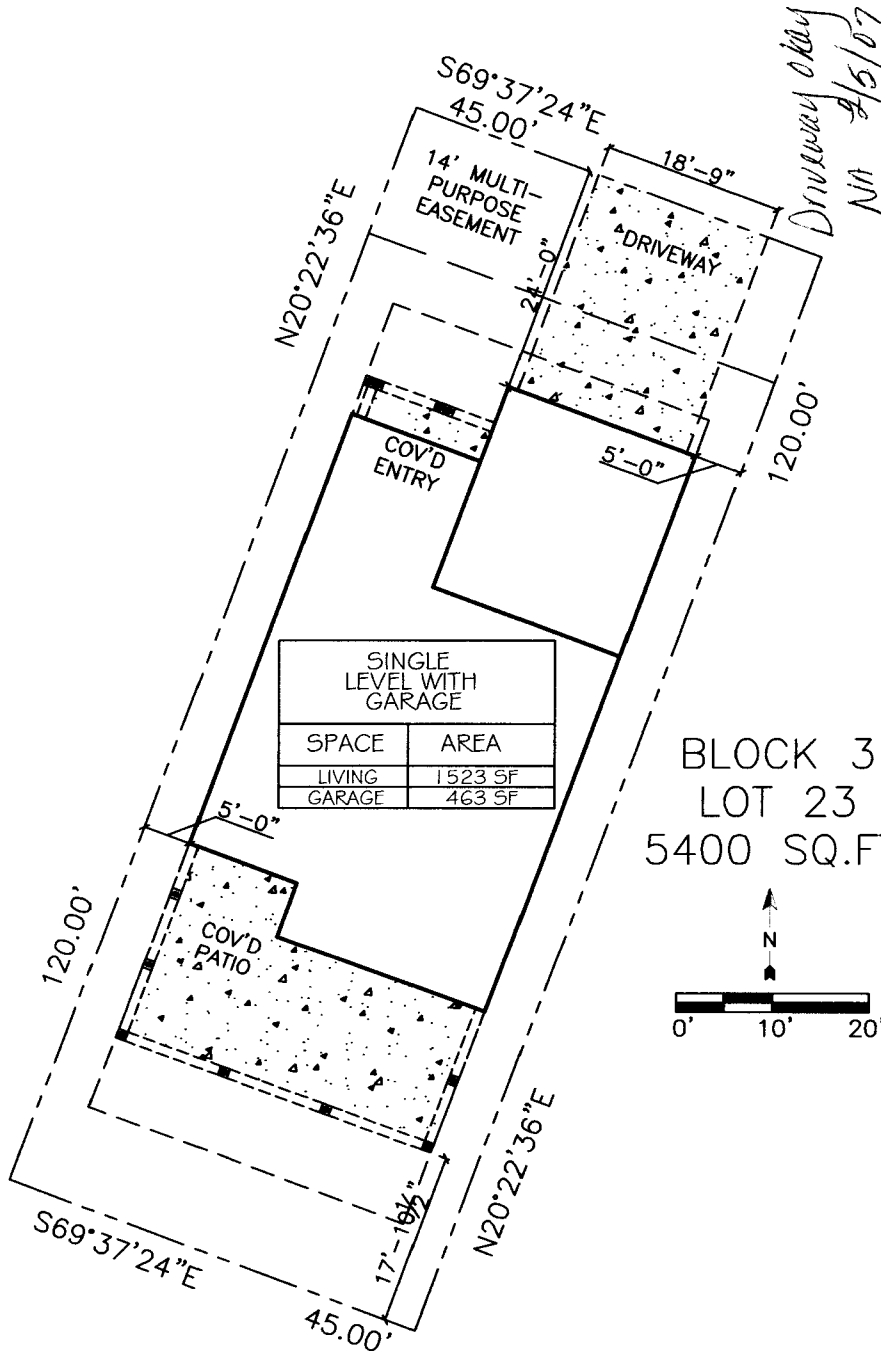

SINGLE LEVEL WITH GARAGE	
SPACE	AREA
LIVING	1523 SF
GARAGE	463 SF

BLOCK 3
LOT 23
5400 SQ.FT.

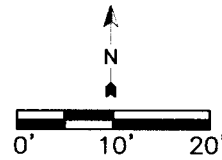

ACCEPTED NA Wendy Spurr
 ANY CHANGE OF SETBACKS MUST BE
 APPROVED BY CITY PLANNING
 DEPARTMENT TO PROPERLY
 IDENTIFY EASEMENT'S
 AND PROPERTY LINES

Driveway okay
 NA 2/5/07

RMF - 8		
Minimum Setbacks		
Front	Side	Rear
20	5	10

SITE PLAN
SCALE: 1" = 20'-0"

ACTION ELECTRIC	7174
TOPS/GAS	2071133
TOPS/MASTER	2071134
PRECISION CONSTRUCTION	2060561

1/29/2007 2:21:23 PM