
.	
FEE \$	10.00
TCP\$	Ø
CIE ¢	6

FEE\$ 10.00 TCP\$	PLANNING CLE (Single Family Residential and A Community Developm	Accessory Structures) 12 5111 51170	~
Building Address	538 Normand show	No. of Existing Bldgs No. Proposed	

Parcel No. 2943-074-04-009	Sq. Ft. of Existing Bldgs Sq. Ft. Proposed
Subdivision Cotton Wood meadows	Sq. Ft. of Lot / Parcel
Filing Block 4 Lot 9	Sq. Ft. Coverage of Lot by Structures & Impervious Surface
OWNER INFORMATION:	(Total Existing & Proposed)Height of Proposed Structure
Name Dennis Mushell	DESCRIPTION OF WORK & INTENDED USE: New Single Family Home (*check type below)
Address 538 Normandy Way	Interior Remodel Other (please specify): Addition Shed - 12 x15 1/2
City / State / Zip Grand Tub Co	Other (please specify).
APPLICANT INFORMATION:	*TYPE OF HOME PROPOSED:
Name <u>Same</u>	✓ Site Built Manufactured Home (UBC) Manufactured Home (HUD) Other (please specify):
Address	
City / State / Zip N	OTES:
Telephone <u>970-250-5337</u>	
	existing & proposed structure location(s), parking, setbacks to all on & width & all easements & rights-of-way which abut the parcel.
	MUNITY DEVELOPMENT DEPARTMENT STAFF
I IIIO OLO IION TO DE COMI LETED BI COM	
ZONE PD	Maximum coverage of lot by structures
	Maximum coverage of lot by structures
ZONE PD	
ZONE PD SETBACKS: Front 14' from property line (PL)	Permanent Foundation Required: YESNO
ZONE PD SETBACKS: Front 14' from property line (PL) Side S' from PL Rear 10' from PL Maximum Height of Structure(s) Driveway Voting District Driveway	Permanent Foundation Required: YES NO Parking Requirement Special Conditions Exempt from Permanent foundation
SETBACKS: Front from property line (PL) Side from PL Rear from PL Maximum Height of Structure(s) Voting District Driveway Location Approval (Engineer's Initials) Modifications to this Planning Clearance must be approved	Permanent Foundation Required: YES NO Parking Requirement Special Conditions Exempt from Permanent foundation in writing, by the Community Development Department. The
SETBACKS: Front from property line (PL) Side from PL Rear from PL Maximum Height of Structure(s) Voting District Driveway Location Approval (Engineer's Initials) Modifications to this Planning Clearance must be approved	Permanent Foundation Required: YESNO Parking Requirement Special Conditions
SETBACKS: Front 14' from property line (PL) Side 5' from PL Rear 10' from PL Maximum Height of Structure(s) Voting District Driveway Location Approval (Engineer's Initials) Modifications to this Planning Clearance must be approved structure authorized by this application cannot be occupied Occupancy has been issued, if applicable, by the Building Deline I hereby acknowledge that I have read this application and the	Permanent Foundation Required: YESNO Parking Requirement Special ConditionsExecut
SETBACKS: Front 14' from property line (PL) Side 5' from PL Rear 10' from PL Maximum Height of Structure(s) Voting District Driveway Location Approval (Engineer's Initials) Modifications to this Planning Clearance must be approved structure authorized by this application cannot be occupied Occupancy has been issued, if applicable, by the Building Deliand I hereby acknowledge that I have read this application and the ordinances, laws, regulations or restrictions which apply to the	Permanent Foundation Required: YESNO Parking Requirement Special ConditionsExecut
SETBACKS: Front	Permanent Foundation Required: YES NO Parking Requirement Special Conditions Exempt from Permanent foundation Permanent foundation in writing, by the Community Development Department. The until a final inspection has been completed and a Certificate of epartment (Section 305, Uniform Building Code). In information is correct; I agree to comply with any and all codes, e project. I understand that failure to comply shall result in legal on-use of the building(s).
SETBACKS: Front	Permanent Foundation Required: YES NO Parking Requirement Special Conditions Exempt from Permanent foundation in writing, by the Community Development Department. The until a final inspection has been completed and a Certificate of epartment (Section 305, Uniform Building Code). In information is correct; I agree to comply with any and all codes, are project. I understand that failure to comply shall result in legal con-use of the building(s). Date 1128 07 Date 28 07
SETBACKS: Front	Permanent Foundation Required: YES NO Parking Requirement Special Conditions Exempt from Permanent foundation in writing, by the Community Development Department. The until a final inspection has been completed and a Certificate of epartment (Section 305, Uniform Building Code). In information is correct; I agree to comply with any and all codes, are project. I understand that failure to comply shall result in legal con-use of the building(s). Date 1128 07 Date 28 07

City of Grand Junction GIS Zoning Map ©

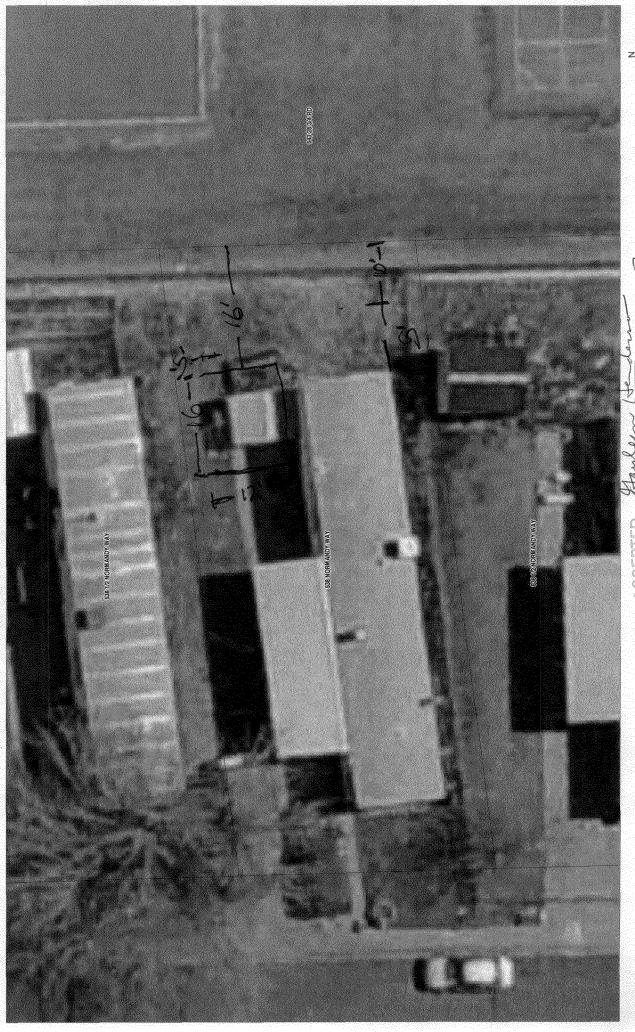

http://gis-web-f___grandjct.co.us/maps6/Zoning_Map1.mwf

Wednesday, Novembe 3, 2007 2:45 PM