

FEE \$ 10.⁰⁰ /
 TCP \$ 1539.⁰⁰ /
 SIF \$ 400.⁰⁰

PLANNING CLEARANCE
 (Single Family Residential and Accessory Structures)
Community Development Department

BLDG PERMIT NO. _____

Building Address 3138 Open Meadows Ct No. of Existing Bldgs 0 No. Proposed 1
 Parcel No. 2943-152-95-009 Sq. Ft. of Existing Bldgs 0 Sq. Ft. Proposed 2490
 Subdivision Summit View Meadows Sq. Ft. of Lot / Parcel 6449
 Filing 2 Block 1 Lot 9 Sq. Ft. Coverage of Lot by Structures & Impervious Surface (Total Existing & Proposed) 2113
 Height of Proposed Structure 25'

OWNER INFORMATION:

Name Zeck Homes, Inc
 Address 1950 Hwy 6+50
 City / State / Zip Fruita, CO 81521

DESCRIPTION OF WORK & INTENDED USE:
 New Single Family Home (*check type below)
 Interior Remodel Addition
 Other (please specify): _____

APPLICANT INFORMATION:

Name Zeck Homes, Inc.
 Address 1950 Hwy 6+50
 City / State / Zip Fruita, CO 81521
 Telephone (970) 858-0178

*TYPE OF HOME PROPOSED:
 Site Built Manufactured Home (UBC)
 Manufactured Home (HUD)
 Other (please specify): _____

NOTES: _____

REQUIRED: One plot plan, on 8 1/2" x 11" paper, showing all existing & proposed structure location(s), parking, setbacks to all property lines, ingress/egress to the property, driveway location & width & all easements & rights-of-way which abut the parcel.

THIS SECTION TO BE COMPLETED BY COMMUNITY DEVELOPMENT DEPARTMENT STAFF	
ZONE <u>RMF-8</u>	Maximum coverage of lot by structures <u>70</u>
SETBACKS: Front <u>20</u> from property line (PL)	Permanent Foundation Required: YES <u>X</u> NO _____
Side <u>5</u> from PL Rear <u>10</u> from PL	Parking Requirement <u>2</u>
Maximum Height of Structure(s) <u>35</u>	Special Conditions <u>Engineered foundation required.</u>
Voting District <u>C</u> Driveway Location Approval <u>JK</u> (Engineer's Initials)	

Modifications to this Planning Clearance must be approved, in writing, by the Community Development Department. The structure authorized by this application cannot be occupied until a final inspection has been completed and a Certificate of Occupancy has been issued, if applicable, by the Building Department (Section 305, Uniform Building Code).


I hereby acknowledge that I have read this application and the information is correct; I agree to comply with any and all codes, ordinances, laws, regulations or restrictions which apply to the project. I understand that failure to comply shall result in legal action, which may include but not necessarily be limited to non-use of the building(s).

Applicant Signature Juni Arnold Date 2-1-07
 Department Approval Raylen Henderson Date 2/5/07

Additional water and/or sewer tap fee(s) are required: YES <input checked="" type="checkbox"/> NO <input type="checkbox"/> W/O No. <u>paid @ C&V.</u>
Utility Accounting <u>Kate Cebrey</u> Date <u>2/12/07</u>

VALID FOR SIX MONTHS FROM DATE OF ISSUANCE (Section 2.2.C.1 Grand Junction Zoning & Development Code)
 (White: Planning) (Yellow: Customer) (Pink: Building Department) (Goldenrod: Utility Accounting)

3138 Open Meadows Ct
 Lot 9 Block 1
 6449 sq. ft.

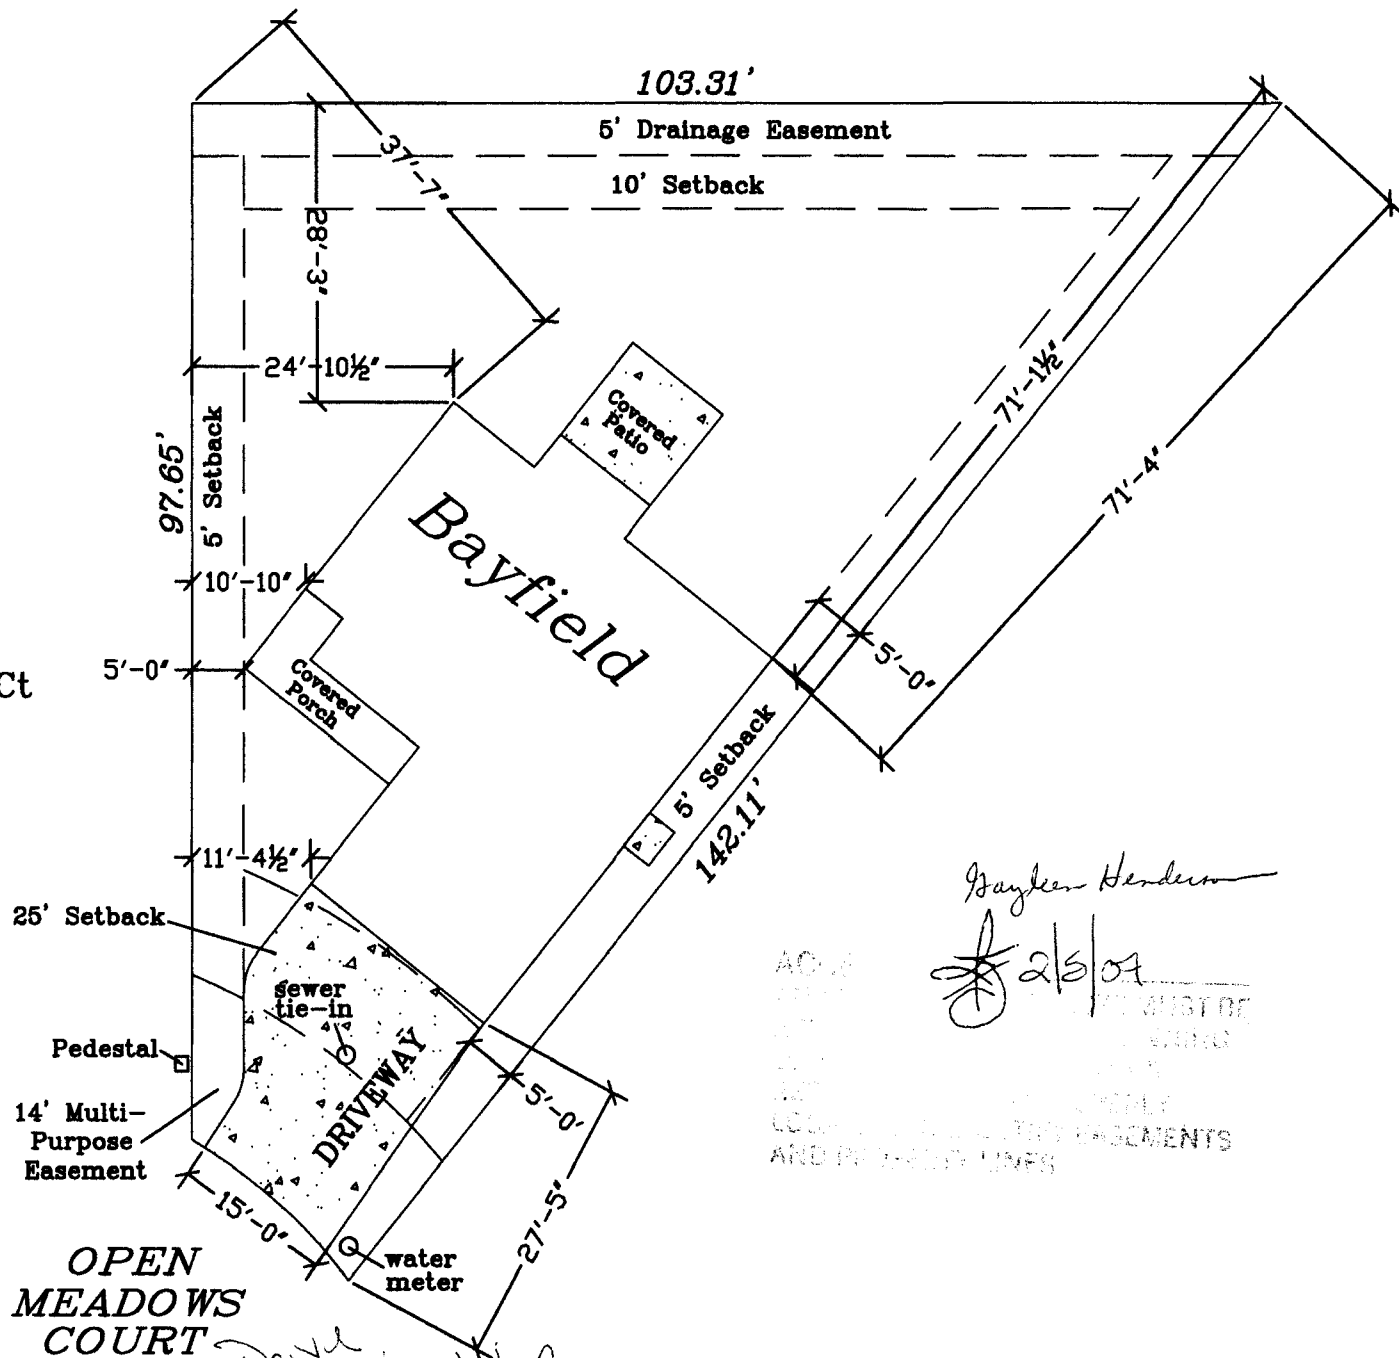

Gayleen Henderson
 2/5/07
 YOU MUST OBTAIN PERMITS FROM THE LOCAL GOVERNMENT AND UTILITY LINES

Drive OK 2/5/07

REVISION	BY

3138 Open Meadows Court
 Summit View Meadows II
 Lot 9 Block 1

Zeck Homes, Inc
 1950 Hwy 6 & 50
 Fruita, CO 81521
 (970) 858-0178



Date	11/28/06
By	MB
Scale	MAP