

Planning \$ <u>10.00</u>	Drainage \$
TCP \$	School Impact \$

BLDG PERMIT NO.
FILE # <u>SS-2007-149</u>

PLANNING CLEARANCE

(site plan review, multi-family development, non-residential development)
Grand Junction Community Development Department

No Acct - Vacant

THIS SECTION TO BE COMPLETED BY APPLICANT

BUILDING ADDRESS ~~Carpent~~ 2476 Orion Way
 SUBDIVISION Brookwillow
 FILING 2 BLK _____ LOT _____
 OWNER Darter LLC
 ADDRESS 786 Valley Ct
 CITY/STATE/ZIP GJ CO 81505
 APPLICANT Grace Homes
 ADDRESS 786 Valley Ct
 CITY/STATE/ZIP GJ CO 81505
 TELEPHONE 248-8572

TAX SCHEDULE NO. 2945-041-27-000
 SQ. FT. OF EXISTING BLDG(S) _____
 SQ. FT. OF PROPOSED BLDG(S)/ADDITONS _____
MULTI-FAMILY:
 NO. OF DWELLING UNITS: BEFORE _____ AFTER _____
 CONSTRUCTION
 NO. OF BLDGS ON PARCEL: BEFORE 0 AFTER 1
 CONSTRUCTION
 USE OF ALL EXISTING BLDG(S) residences

DESCRIPTION OF WORK & INTENDED USE:
Carpent for 10-Plex; roof only
no side enclosure

Submittal requirements are outlined in the SSID (Submittal Standards for Improvements and Development) document.

THIS SECTION TO BE COMPLETED BY COMMUNITY DEVELOPMENT DEPARTMENT STAFF

ZONE <u>PD</u> <u>per plan</u> SETBACKS: FRONT: _____ from Property Line (PL) or _____ from center of ROW, whichever is greater SIDE: _____ from PL REAR: _____ from PL MAX. HEIGHT _____ MAX. COVERAGE OF LOT BY STRUCTURES _____	LANDSCAPING/SCREENING REQUIRED: YES _____ NO _____ PARKING REQUIREMENT: _____ SPECIAL CONDITIONS: _____
--	---

Modifications to this Planning Clearance must be approved, in writing, by the Community Development Department Director. The structure authorized by this application cannot be occupied until a final inspection has been completed and a Certificate of Occupancy has been issued by the Building Department (Section 307, Uniform Building Code). Required improvements in the public right-of-way must be guaranteed prior to issuance of a Planning Clearance. All other required site improvements must be completed or guaranteed prior to issuance of a Certificate of Occupancy. Any landscaping required by this permit shall be maintained in an acceptable and healthy condition. The replacement of any vegetation materials that die or are in an unhealthy condition is required by the Grand Junction Zoning and Development Code.

Four (4) sets of final construction drawings must be submitted and stamped by City Engineering prior to issuing the Planning Clearance. One stamped set must be available on the job site at all times.


I hereby acknowledge that I have read this application and the information is correct; I agree to comply with any and all codes, ordinances, laws, regulations, or restrictions which apply to the project. I understand that failure to comply shall result in legal action, which may include but not necessarily be limited to non-use of the building(s).

Applicant's Signature [Signature] Date 10/4/07
 Department Approval [Signature] Date 10-4-07

Additional water and/or sewer tap fee(s) are required:	YES	NO <input checked="" type="checkbox"/>	W/O No. <u>No Swr/charge</u>
Utility Accounting <u>[Signature]</u>	Date <u>10/25/07</u>		

VALID FOR SIX MONTHS FROM DATE OF ISSUANCE (Section 2.2.C.1 Grand Junction Zoning and Development Code)

(White: Planning) (Yellow: Customer) (Pink: Building Department) (Goldenrod: Utility Accounting)

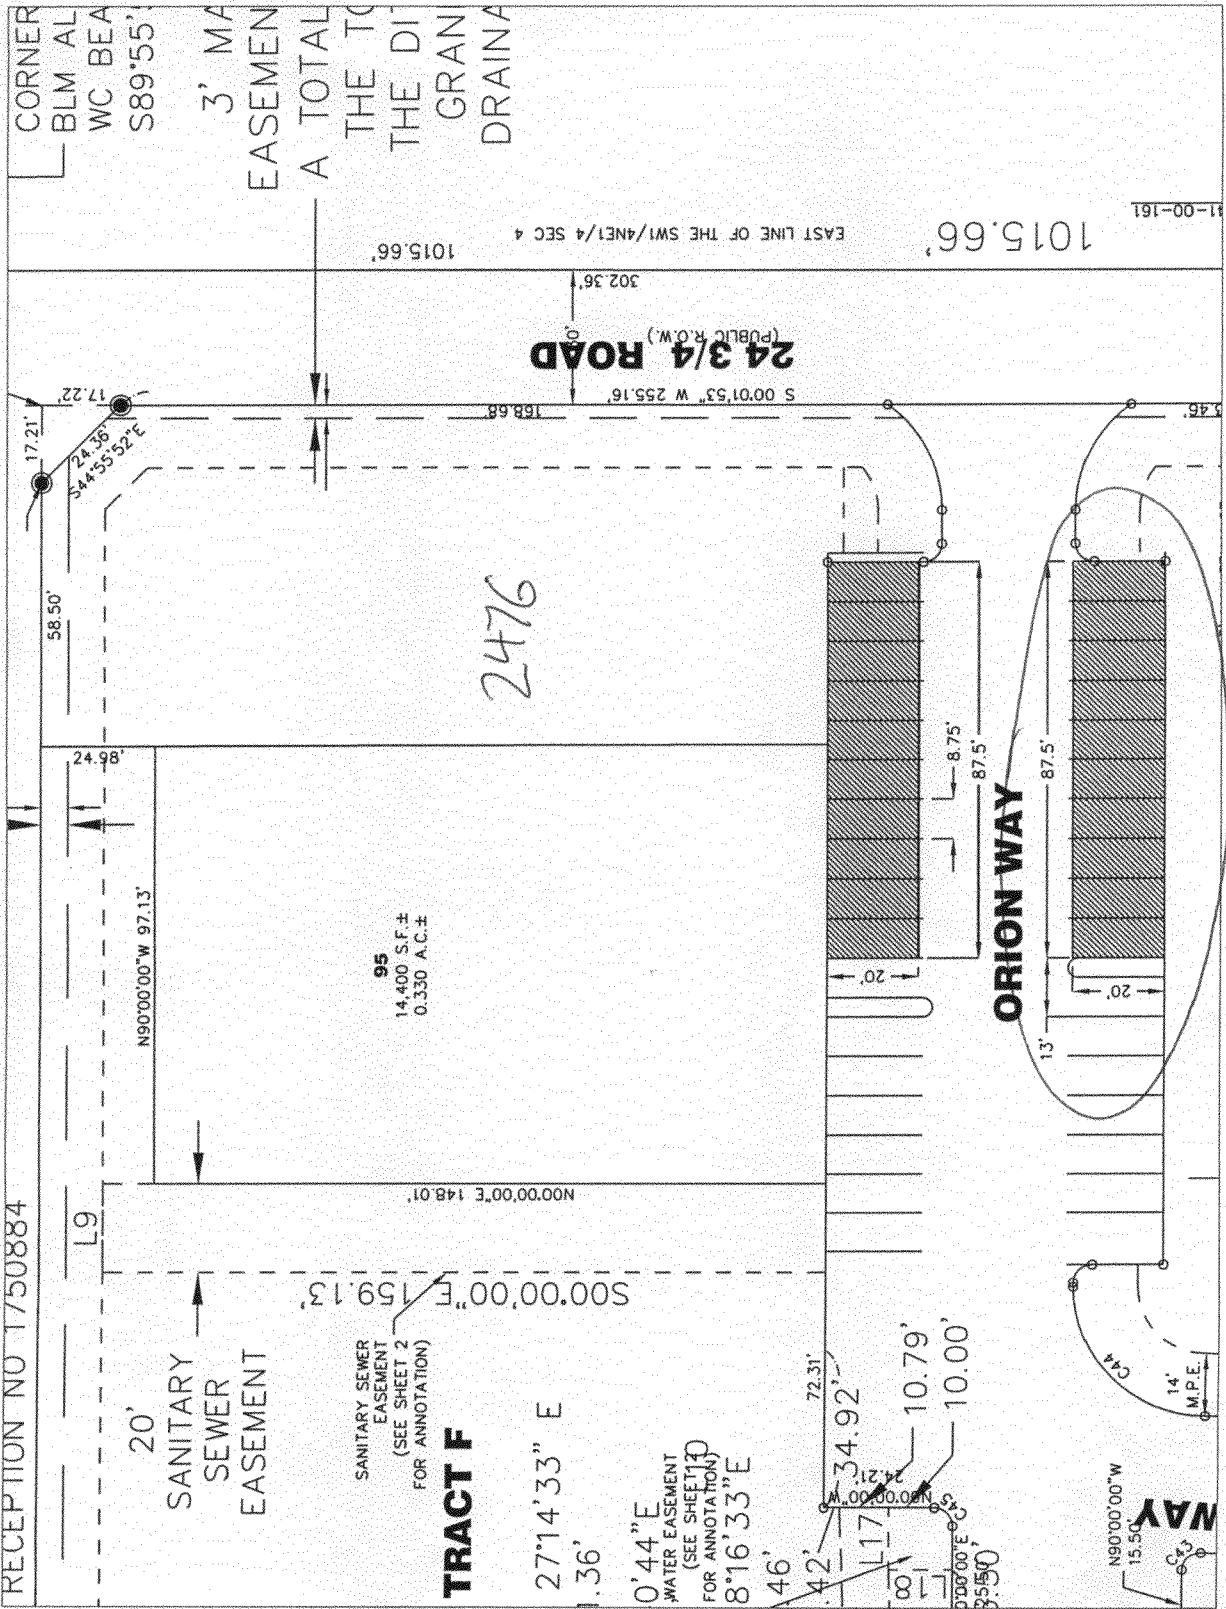

Parcel # 2945-041-27-000