

FEE \$	10.00
TCP \$	1589.00
SIF \$	460.00

**PLANNING CLEARANCE**  
(Single Family Residential and Accessory Structures)  
**Community Development Department**

BLDG PERMIT NO. \_\_\_\_\_

Building Address 2945 Red Cloud No. of Existing Bldgs 0 No. Proposed 1  
 Parcel No. 2943-173-39-004 Sq. Ft. of Existing Bldgs 0 Sq. Ft. Proposed 2612  
 Subdivision Countryplace Estates Sq. Ft. of Lot / Parcel 5416  
 Filing \_\_\_\_\_ Block 2 Lot 4 Sq. Ft. Coverage of Lot by Structures & Impervious Surface (Total Existing & Proposed) 2300  
 Height of Proposed Structure 25'

**OWNER INFORMATION:**

Name Danny Poulson  
 Address 1545 Road Ave.  
 City / State / Zip Grand Jct., CO 81501

DESCRIPTION OF WORK & INTENDED USE:  
 New Single Family Home (\*check type below)  
 Interior Remodel  Addition  
 Other (please specify): \_\_\_\_\_

**APPLICANT INFORMATION:**

Name Danny Poulson  
 Address \_\_\_\_\_  
 City / State / Zip \_\_\_\_\_  
 Telephone 250-3530

\*TYPE OF HOME PROPOSED:  
 Site Built  Manufactured Home (UBC)  
 Manufactured Home (HUD)  
 Other (please specify): \_\_\_\_\_

NOTES: \_\_\_\_\_

**REQUIRED: One plot plan, on 8 1/2" x 11" paper, showing all existing & proposed structure location(s), parking, setbacks to all property lines, ingress/egress to the property, driveway location & width & all easements & rights-of-way which abut the parcel.**

<b>THIS SECTION TO BE COMPLETED BY COMMUNITY DEVELOPMENT DEPARTMENT STAFF</b>	
ZONE <u>RMT-8</u>	Maximum coverage of lot by structures <u>70</u>
SETBACKS: Front <u>20</u> from property line (PL)	Permanent Foundation Required: YES <u>X</u> NO _____
Side <u>5</u> from PL Rear <u>10</u> from PL	Parking Requirement <u>2</u>
Maximum Height of Structure(s) <u>35</u>	Special Conditions _____
Voting District <u>C</u> Driveway Location Approval _____ (Engineer's Initials)	

Modifications to this Planning Clearance must be approved, in writing, by the Community Development Department. The structure authorized by this application cannot be occupied until a final inspection has been completed and a Certificate of Occupancy has been issued, if applicable, by the Building Department (Section 305, Uniform Building Code).

I hereby acknowledge that I have read this application and the information is correct; I agree to comply with any and all codes, ordinances, laws, regulations or restrictions which apply to the project. I understand that failure to comply shall result in legal action, which may include but not necessarily be limited to non-use of the building(s).

Applicant Signature [Signature] Date 2/22/07  
 Department Approval [Signature] Date 3/7/07

Additional water and/or sewer tap fee(s) are required:	YES <input checked="" type="checkbox"/>	NO <input type="checkbox"/>	W/O No. <u>20016</u>
Utility Accounting <u>[Signature]</u>	Date <u>3/7/07</u>		

VALID FOR SIX MONTHS FROM DATE OF ISSUANCE (Section 2.2.C.1 Grand Junction Zoning & Development Code)  
 (White: Planning) (Yellow: Customer) (Pink: Building Department) (Goldenrod: Utility Accounting)

13019

**SITE NOTES**

WATER DIVERTED FROM ITS ORIGINAL DRAINAGE PATTERN SHALL BE RETURNED TO ITS ORIGINAL COURSE BEFORE LEAVING THE PROPERTY. INTRODUCED DRAINAGE FEATURES SHALL BE NATURAL APPEARING, DESIGNED TO SIMULATE FREQUENTLY'S WALLS AND WALKERS SHALL CONFORM TO ALL DRAINAGE BASINMENTS OF THE CITY OF GRAND JUNCTION.

GUARDRAILS TO BE 36" MINIMUM IN HEIGHT.

OPEN GUARDRAILS AND STAIR RAILINGS SHALL HAVE INTERMEDIATE RAILS OR AN ORNAMENTAL PATTERN SUCH THAT A SPHERE 4 INCHES IN DIAMETER CANNOT PASS THROUGH.

INSTALL HANDRAILS AT ALL STAIRS HAVING MORE THAN TWO RISERS, UNLESS SHOWN OTHERWISE. HANDRAILS TO BE NOT LESS THAN 34 INCHES, NOR MORE THAN 38 INCHES ABOVE FINISH OF TREADS.

NOTICE TO ALL CONTRACTORS AND SUBCONTRACTORS: PROTECT NATURAL VEGETATION - TERRAIN, ROCKS, ETC. FROM STUCCO, PAINT, ROOFING FOAM, CONCRETE OR OTHER DAMAGE BY COVERING WITH PLASTIC OR AS REQUIRED. PROVIDE A 4" HIGH BARRIER WITHIN BUILDING ENVELOPE (WHEN APPLICABLE). KEEP MATERIALS AND WORKMEN WITHIN THE FENCE TO PREVENT DAMAGE TO NATURAL TERRAIN AND VEGETATION. THE COST OF RECLAIMING OR REPAIRING ANY DAMAGE DUE TO NEGLIGENCE WILL BE AT THE CONTRACTOR'S/SUBCONTRACTOR'S EXPENSE.

VERIFY PROPERTY AND BUILDING LINES AND FINISH FLOOR ELEVATIONS PRIOR TO CONSTRUCTION. CONFIRM THAT ALL UTILITIES (SEWER, POWER, WATER) ARE LOCATED AS SHOWN AND THAT SEWER TAP IS LOW ENOUGH TO SERVE ALL PLUMBING DRAINS.

DRAWINGS ARE NOT TO BE SCALED. BUILD FROM DIMENSIONS INDICATED. VERIFY ALL DIMENSIONS. NOTIFY ARCHITECT OF ANY CONFLICTS.

HOLE'S ADDRESS MARKING: A HOUSE NUMBER SHALL BE DISPLAYED IN A PROMINENT MANNER, SO THAT IT IS REASONABLY VISIBLE TO ENABLE EMERGENCY VEHICLES TO LOCATE THE RESIDENCE.

AREAS DISTURBED DURING CONSTRUCTION OF DRAINAGE FACILITIES OR UTILITY (SEWER, WATER, ELECTRIC, ETC) TRENCHES SHALL BE RESTORED TO THEIR NATURAL STATE.

ALL AREAS BETWEEN THE CONSTRUCTION FENCE AND ANY BUILDING OR SITE SHALL BE RE-LANDSCAPED TO BECOME INDISTINGUISHABLE FROM ADJACENT UNDISTURBED NATURAL DESERT AREA.

FINISH GRADE SHALL BE A MINIMUM OF 12 INCHES BELOW WOOD FRAMING AT BUILDING EXTERIOR SLOPE FINISH GRADE FOR AN ADDITIONAL 6 INCHES AWAY FROM BUILDING FOR A 10' HORIZONTAL DISTANCE.

EVERY EFFORT IS MADE TO PROVIDE COMPLETE AND ACCURATE INFORMATION. IF THERE IS ANY CONFLICTING INFORMATION OR OMISSIONS IN THE WORKING DRAWINGS OR SUPPLEMENTAL DOCUMENTS, IT IS THE GENERAL CONTRACTOR'S RESPONSIBILITY TO COORDINATE WITH THE ARCHITECT FOR A RESOLUTION.

PROVIDE SCREEN WALL AT ALL EXTERIOR MECHANICAL EQUIPMENT. SCREEN WALL TO BE AT A MIN. HEIGHT OF 10' ABOVE THE MECHANICAL EQUIPMENT, UNLESS NOTED OTHERWISE.

ALL RETAINING WALLS TO HAVE PERMITS SURROUNDED BY 3" CRUSHED GRAVEL WRAPPED IN GEOTEXTILE BEHIND WALL AND WEEDS @ 4" O.C. (TYP)

THIS IS TO BE AN EVEN SLOPE BETWEEN NEW GRADES, UNLESS OTHERWISE NOTED. MEET EXISTING GRADES AT A SLOPE OF 1" HORIZONTAL TO 1" VERTICAL TO 10' HORIZONTAL. ALL EXISTING GRADES TO BE 2" BELOW ADJACENT WALKS AND DRIVES UNLESS OTHERWISE NOTED. DETCHES TO HAVE SMOOTH CONTIGUES TO FACILITATE USE OF LAWN MOWERS.

ALL CONSTRUCTION DOCUMENTS ARE BASED ON THE ACCURACY OF THE EXISTING RECORD DRAWINGS. IT SHALL BE THE RESPONSIBILITY OF THE GENERAL CONTRACTOR, CONSTRUCTION MANAGER AND TRADE CONTRACTORS TO VERIFY EXISTING CONDITIONS AND DIMENSIONS PRIOR TO THE INSTALLATION OF ANY NEW WORK OR COMMENCEMENT OF EXISTING CONSTRUCTION. IF ANY DISCREPANCIES ARE FOUND BETWEEN THE EXISTING CONDITION AND THE CONSTRUCTION DOCUMENTS THE ARCHITECT SHALL BE NOTIFIED IMMEDIATELY.

ALL ELEVATIONS ARE TO BE FIELD VERIFIED AND APPROVED BY ARCHITECT BEFORE PROCEEDING WITH CONSTRUCTION.

CONTRACTOR SHALL REMOVE ALL VEGETATION, TREES, STUMPS, DEBRIS AND EXISTING STRUCTURES (SUCH AS PAVEMENT, SIDEWALK, BUILDING FOUNDATION, ABANDONED UTILITIES AND EXISTING FENCES) IN ALL AREAS OF DEVELOPMENT.

ALL TREES SHALL BE RESPONSIBLE TO COMPLETE SITE INVESTIGATION TO IDENTIFY SCOPE OF MATERIALS TO BE REMOVED AND NEW MATERIALS REQUIRED TO MATCH EXISTING CONSTRUCTION.


CONTRACTOR SHALL NOTIFY MISS (910-462-7171) A MINIMUM OF 10 WORKING DAYS PRIOR TO COMMENCEMENT OF WORK TO DETERMINE HOW RESPECTIVE UTILITIES WILL BE OFFSET BY CONSTRUCTION.

CONCRETE SIDEWALKS TO HAVE 3" TYPED JOINTS AT 7'-0" O.C. CONCRETE SIDEWALKS TO HAVE 3" TYPED JOINTS AT 7'-0" O.C. (MINIMUM)

**BUILDING ENVELOPE**  
**SETBACKS**  
 FRONT: 20'-0"  
 SIDE: 5'-0"  
 REAR: 10'-0"

**NOTE:**  
 7'-0" NON-COMBUSTIBLE  
 AROUND HOUSE PERIMETER

**SITE PLAN**  
 3/16" = 1'-0"

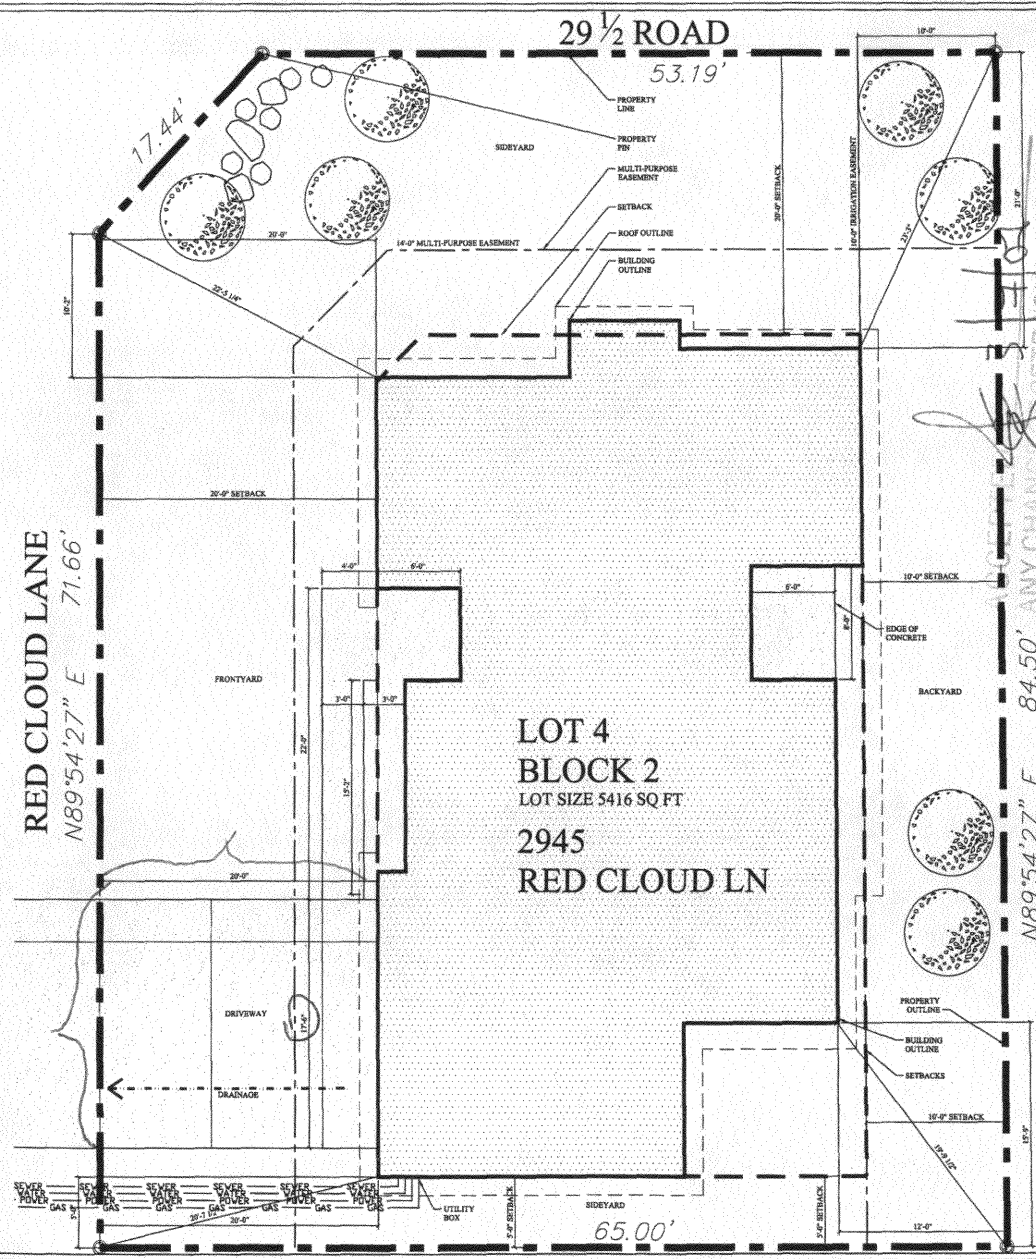

**LOT 4  
 BLOCK 2  
 LOT SIZE 5416 SQ FT  
 2945  
 RED CLOUD LN**

**ANY CHANGES TO SETBACKS MUST BE APPROVED BY THE CITY PLANNING DEPT. APPLICANTS RESPONSIBLE TO PROPERLY LOCATE AND IDENTIFY EASEMENTS AND PROPERTY LINES.**

MESA-MONUMENT CONSTRUCTION, LLC  
 DANNY POULSON (970) 250-3530

**LOT 4 BLOCK 2**  
 2945 RED CLOUD LANE  
 GRAND JUNCTION, COLORADO 81504

Milestone	Date
100% Schematic Design	Nov 22, 2006
100% Design Dev.	NA
Building Permit Set	NA
100% Const. Draw.	NA

Drawn By: C. Collier  
 Date: Nov. 22, 2006  
 Project #: 06-16-00  
 Sheet: 100% Const. Draw.

**C1.1**  
 Site Plan

COREY COLLIER, DESIGNER (303) 619-6318