

FEE \$	10 ⁰⁰
TCP \$	1581 ⁰⁰
SIF \$	460 ⁰⁰

PLANNING CLEARANCE

(Single Family Residential and Accessory Structures)
Community Development Department

BLDG PERMIT NO. _____

Lift Sta: 1, 104⁰⁰

Building Address 190 River Ridge Rd
 Parcel No. 2945-351-45-078
 Subdivision Spy Glass Ridge
 Filing 2 Block _____ Lot 199

No. of Existing Bldgs 0 No. Proposed 1
 Sq. Ft. of Existing Bldgs 0 Sq. Ft. Proposed Approx 3400 Sq Ft
 Sq. Ft. of Lot / Parcel 10891 Sq ft
 Sq. Ft. Coverage of Lot by Structures & Impervious Surface (Total Existing & Proposed) Approx 4200 Sq Ft
 Height of Proposed Structure 21'6"

OWNER INFORMATION:

Name Robert Dorsey
 Address P.O. Box 40483
 City / State / Zip Grand Jct, Co 81504

DESCRIPTION OF WORK & INTENDED USE:
 New Single Family Home (*check type below)
 Interior Remodel Addition
 Other (please specify): _____

APPLICANT INFORMATION:

Name Dorsey Custom Homes
 Address P.O. Box 40483
 City / State / Zip Grand Jct, Co 81504
 Telephone 986-1783

*TYPE OF HOME PROPOSED:
 Site Built Manufactured Home (UBC)
 Manufactured Home (HUD)
 Other (please specify): _____

REQUIRED: One plot plan, on 8 1/2" x 11" paper, showing all existing & proposed structure location(s), parking, setbacks to all property lines, ingress/egress to the property, driveway location & width & all easements & rights-of-way which abut the parcel.

THIS SECTION TO BE COMPLETED BY COMMUNITY DEVELOPMENT DEPARTMENT STAFF			
ZONE <u>RSF2 / CLUSTER</u>	Maximum coverage of lot by structures <u>30%</u>		
SETBACKS: Front <u>20'</u> from property line (PL)	Permanent Foundation Required: YES <input checked="" type="checkbox"/> NO <input type="checkbox"/>		
Side <u>10'</u> from PL Rear <u>20'</u> from PL	Parking Requirement <u>2</u>		
Maximum Height of Structure(s) <u>35'</u>	Special Conditions <u>Engineered foundation required; Grading & drainage plans req; requirements per Plat Approved w/ varied TOF</u>		
Voting District <u>E</u>	Driveway Location Approval <u>JAR</u> (Engineer's Initials)		

Modifications to this Planning Clearance must be approved, in writing, by the Community Development Department. The structure authorized by this application cannot be occupied until a final inspection has been completed and a Certificate of Occupancy has been issued, if applicable, by the Building Department (Section 305, Uniform Building Code).

I hereby acknowledge that I have read this application and the information is correct; I agree to comply with any and all codes, ordinances, laws, regulations or restrictions which apply to the project. I understand that failure to comply shall result in legal action, which may include but not necessarily be limited to non-use of the building(s).

Applicant Signature Robert Dorsey Date 12-11-06
 Department Approval JAR Judith A. Rice Date 1/04/07

Additional water and/or sewer tap fee(s) are required:	YES <input checked="" type="checkbox"/>	NO <input type="checkbox"/>	W/O No. <u>OMSD</u>
Utility Accounting	Date <u>1-4-07</u>		

VALID FOR SIX MONTHS FROM DATE OF ISSUANCE (Section 2.2.C.1 Grand Junction Zoning & Development Code)
 (White: Planning) (Yellow: Customer) (Pink: Building Department) (Goldenrod: Utility Accounting)


190 River Ridge Rd
Lot #199, Filing #2
Parcel # 2945-351-45-078

1/14/07
JAR Judith Puz
ACCEPTED
ANY CHANGES OR SETBACKS WILL BE
APPROVED BY THE CITY PLANNING
DEPT. THE APPLICANT'S
RESPONSIBILITY TO PROPERLY
LOCATE AND IDENTIFY EASEMENTS
AND PROPERTY LINES

BACK

91.98

North

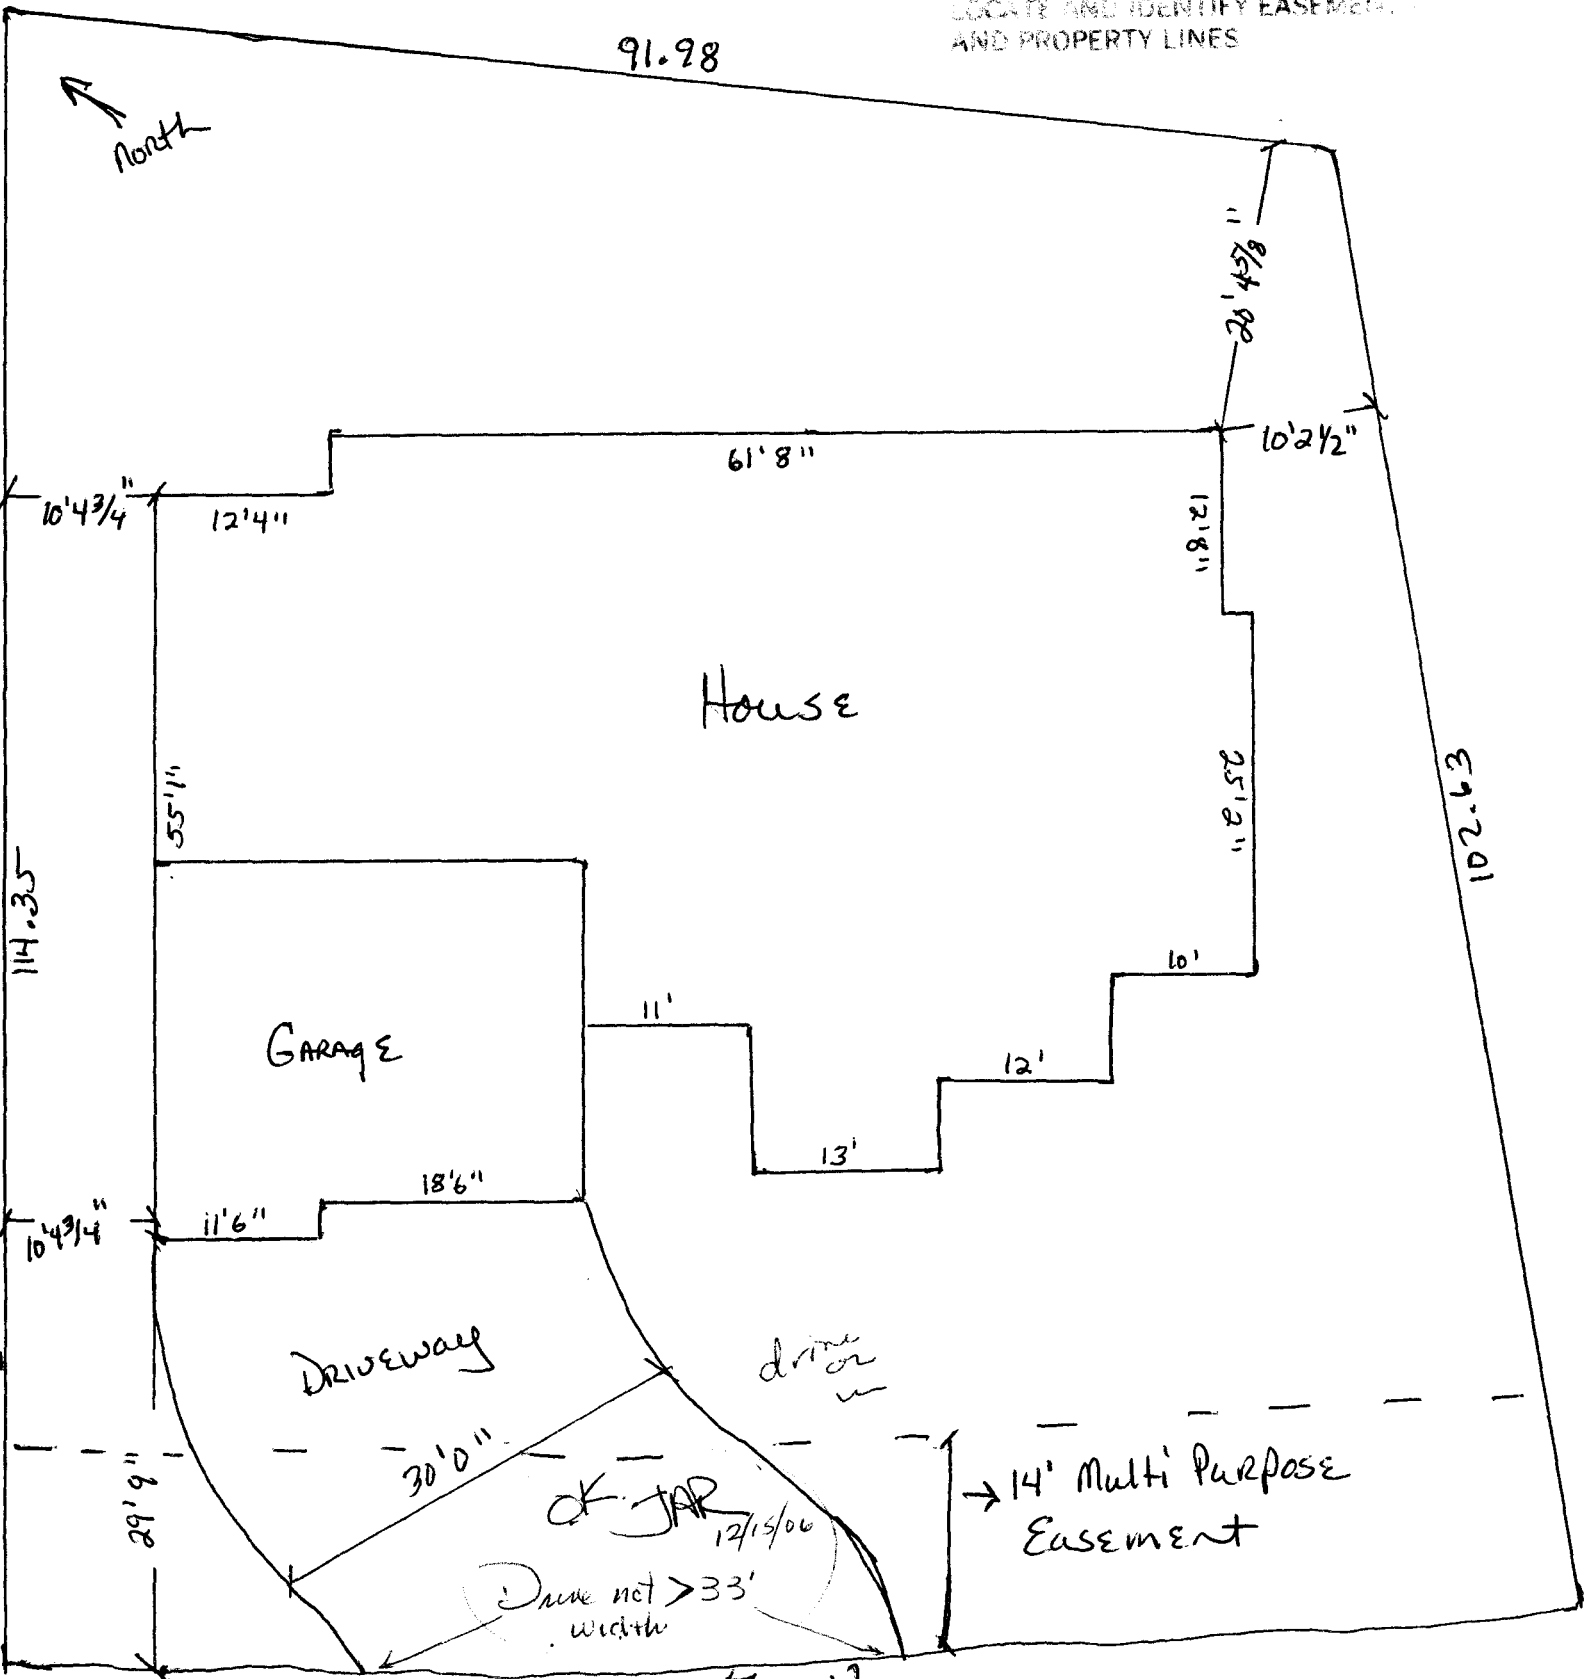

River Ridge Road (Front)