| FEE\$ | 10-     |
|-------|---------|
| TCP\$ | 1589.00 |
| SIF\$ | 4/1000  |

(White: Planning)

(Yellow: Customer)

## **PLANNING CLEARANCE**

| BI DG | PERMIT NO. |  |
|-------|------------|--|

(Single Family Residential and Accessory Structures)

## **Community Development Department**

| Building Address (012 Sufficient Way   | No. of Existing Bldgs No. Proposed I  |
|--|---|
| Parcel No. <u>2945-034-00-053</u>  | Sq. Ft. of Existing Bldgs Sq. Ft. Proposed  |
| subdivision Beahive Estates The Orchard  | Sq. Ft. of Lot / Parcel 50310 54.F4.  |
| Filing Block D Lot \$653   | Sq. Ft. Coverage of Lot by Structures & Impervious Surface  |
| OWNER INFORMATION:   | (Total Existing & Proposed) 244759. #+.  Height of Proposed Structure 19'   |
| Name Village Homes of Colorado  Address 607 28 4 Rd. Suite 122  City/State/Zip Grand Junchion, Co 81506  | DESCRIPTION OF WORK & INTENDED USE:  New Single Family Home (*check type below)  Interior Remodel Addition  Other (please specify):   |
| APPLICANT INFORMATION:   | *TYPE OF HOME PROPOSED:   |
| Name Same  | V Site Built  |
| Address  |   |
| City / State / Zip No  | OTES:   |
| Telephone 970-683-5421   |   |
| DECLUBED: One plot plan on 9 1/2" x 11" paper chawing all o  | xisting & proposed structure location(s), parking, setbacks to all  |
|  | n & width & all easements & rights-of-way which abut the parcel.  |
| property lines, ingress/egress to the property, driveway location  |   |
| property lines, ingress/egress to the property, driveway location  | n & width & all easements & rights-of-way which abut the parcel.  |
| THIS SECTION TO BE COMPLETED BY COMP   | on & width & all easements & rights-of-way which abut the parcel.  MUNITY DEVELOPMENT DEPARTMENT STAFF  |
| THIS SECTION TO BE COMPLETED BY | MUNITY DEVELOPMENT DEPARTMENT STAFF  Maximum coverage of lot by structures NO  Permanent Foundation Required: YES NO  Parking Requirement   |
| THIS SECTION TO BE COMPLETED BY | MUNITY DEVELOPMENT DEPARTMENT STAFF  Maximum coverage of lot by structures  Permanent Foundation Required: YESNO  Parking Requirement  Special Conditions Examined foundation   |
| THIS SECTION TO BE COMPLETED BY | MUNITY DEVELOPMENT DEPARTMENT STAFF  Maximum coverage of lot by structures  Permanent Foundation Required: YESNO  Parking Requirement  Special Conditions Engineer foundation  Legical  |
| THIS SECTION TO BE COMPLETED BY | MUNITY DEVELOPMENT DEPARTMENT STAFF  Maximum coverage of lot by structures  Permanent Foundation Required: YES NO  Parking Requirement  Special Conditions Excined foundation  in writing, by the Community Development Department. The until a final inspection has been completed and a Certificate of  |
| THIS SECTION TO BE COMPLETED BY | MUNITY DEVELOPMENT DEPARTMENT STAFF  Maximum coverage of lot by structures  Permanent Foundation Required: YES NO  Parking Requirement  Special Conditions  |
| THIS SECTION TO BE COMPLETED BY | MUNITY DEVELOPMENT DEPARTMENT STAFF  Maximum coverage of lot by structures  Permanent Foundation Required: YES NO  Parking Requirement  Special Conditions Foundation has been completed and a Certificate of epartment (Section 305, Uniform Building Code).  information is correct; I agree to comply with any and all codes, exproject. I understand that failure to comply shall result in legal on-use of the building(s).  Date 725  |
| THIS SECTION TO BE COMPLETED BY | MUNITY DEVELOPMENT DEPARTMENT STAFF  Maximum coverage of lot by structures  Permanent Foundation Required: YESNO  Parking Requirement  Special Conditions  Engineed  in writing, by the Community Development Department. The antil a final inspection has been completed and a Certificate of epartment (Section 305, Uniform Building Code).  information is correct; I agree to comply with any and all codes, a project. I understand that failure to comply shall result in legal on-use of the building(s).  Date 1/25/07  Date 1/25/07  Date 1/30/07 |

(Pink: Building Department)


(Goldenrod: Utility Accounting)

## PLOT PLAN FOR



LOT <u>53</u>, SUBDIVISION <u>BEEHIVE ESTATES SUBDIVISION</u>,
CITY OF GRAND JUNCTION, COUNTY OF MESA, STATE OF COLORADO
ADDRESS <u>612 SAFFRON WAY</u> / THE ORCHARD

LOT 53, AREA =  $5.036\pm$  SQ. FT. MODEL 8401 =  $2.447\pm$  SQ. FT. W/PORCH, PATIO & DRIVEWAY

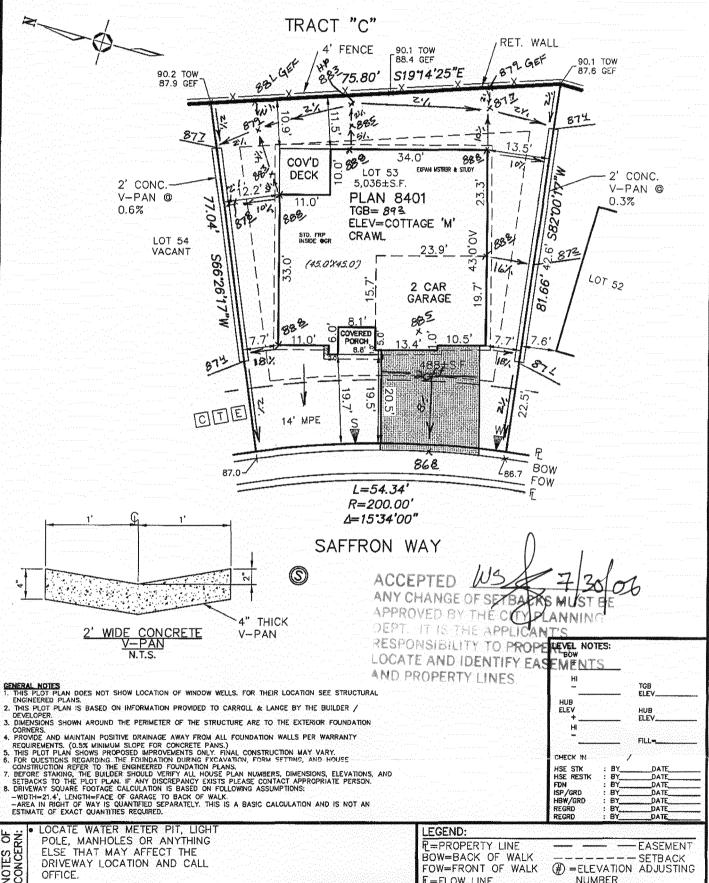



Carroll & Lange ≅

Professional Engineers & Land Surveyors 165 South Union Bivd., Suite 156 Lakewood, Colorado 80228 (303) 980-0200 CALL UTILITY NOTIFICATION CENTER OF COLORADO 1-800-922-1987 or 303-534-6700

IN METRO DENVER
CALL 2-BUSINESS DAYS IN ADVANCE BEFORE
YOU DIG, GRADE, OR EXCAVATE FOR THE
MARKING OF UNDERGROUND MEMBER UTILITIES

F=FLOW LINE
MINIMUM SETBACKS:
FRONT: 20'TO GAR /14'TO HSE EAVE

FRONT: 20'TO GAR./14'TO HSE EAVE REAR: 10' SIDE: 5' STREET SIDE: 20' MIN BETWEEN STRUCTS.: 10' SCALE: 1"=20'
DATE: 7-24-07 FRD
REV:
REV:

JOB NO: 3659