

FEE \$	10.00
TCP \$	1589.00
SIF \$	460.00

PLANNING CLEARANCE
 (Single Family Residential and Accessory Structures)
Community Development Department

BLDG PERMIT NO. _____

Building Address 582 Sinatra Way
 Parcel No. 2993-071-62-021
 Subdivision Legends East
 Filing 2 Block 1 Lot 21

No. of Existing Bldgs 0 No. Proposed 1
 Sq. Ft. of Existing Bldgs 0 Sq. Ft. Proposed 1611
 Sq. Ft. of Lot / Parcel 5793.10 SQ FT.
 Sq. Ft. Coverage of Lot by Structures & Impervious Surface (Total Existing & Proposed) 2621 SQ FT.
 Height of Proposed Structure 17'

OWNER INFORMATION:

Name Legend Partners
 Address P.O. Box 1765
 City / State / Zip Grand Junction CO 81502

DESCRIPTION OF WORK & INTENDED USE:

- New Single Family Home (*check type below)
- Interior Remodel Addition
- Other (please specify): _____

APPLICANT INFORMATION:

Name Legend Partners
 Address P.O. Box 1765
 City / State / Zip Grand Junction, CO 81502
 Telephone 970-244-9986 #17

***TYPE OF HOME PROPOSED:**

- Site Built Manufactured Home (UBC)
- Manufactured Home (HUD)
- Other (please specify): _____

NOTES: _____

REQUIRED: One plot plan, on 8 1/2" x 11" paper, showing all existing & proposed structure location(s), parking, setbacks to all property lines, ingress/egress to the property, driveway location & width & all easements & rights-of-way which abut the parcel.

THIS SECTION TO BE COMPLETED BY COMMUNITY DEVELOPMENT DEPARTMENT STAFF			
ZONE <u>R-8</u> ED ^{br+}	Maximum coverage of lot by structures <u>70%</u>		
SETBACKS: Front <u>20'</u> from property line (PL)	Permanent Foundation Required: YES <input checked="" type="checkbox"/> NO <input type="checkbox"/>		
Side <u>5'</u> from PL Rear <u>10'</u> from PL	Parking Requirement <u>2</u>		
Maximum Height of Structure(s) <u>35'</u>	Special Conditions <u>Engineered foundations</u>		
Voting District <u>"D"</u> Driveway Location Approval <u>JK</u> <u>required</u> (Engineer's Initials)			


Modifications to this Planning Clearance must be approved, in writing, by the Community Development Department. The structure authorized by this application cannot be occupied until a final inspection has been completed and a Certificate of Occupancy has been issued, if applicable, by the Building Department (Section 305, Uniform Building Code).

I hereby acknowledge that I have read this application and the information is correct; I agree to comply with any and all codes, ordinances, laws, regulations or restrictions which apply to the project. I understand that failure to comply shall result in legal action, which may include but not necessarily be limited to non-use of the building(s).

Applicant Signature [Signature] Date 11-16-07
 Department Approval [Signature] Date 11-21-07

Additional water and/or sewer tap fee(s) are required: YES <input checked="" type="checkbox"/> NO <input type="checkbox"/>	W/O No. <u>207601</u>
Utility Accounting <u>[Signature]</u>	Date <u>11/21/07</u>

582 Sinatra Way

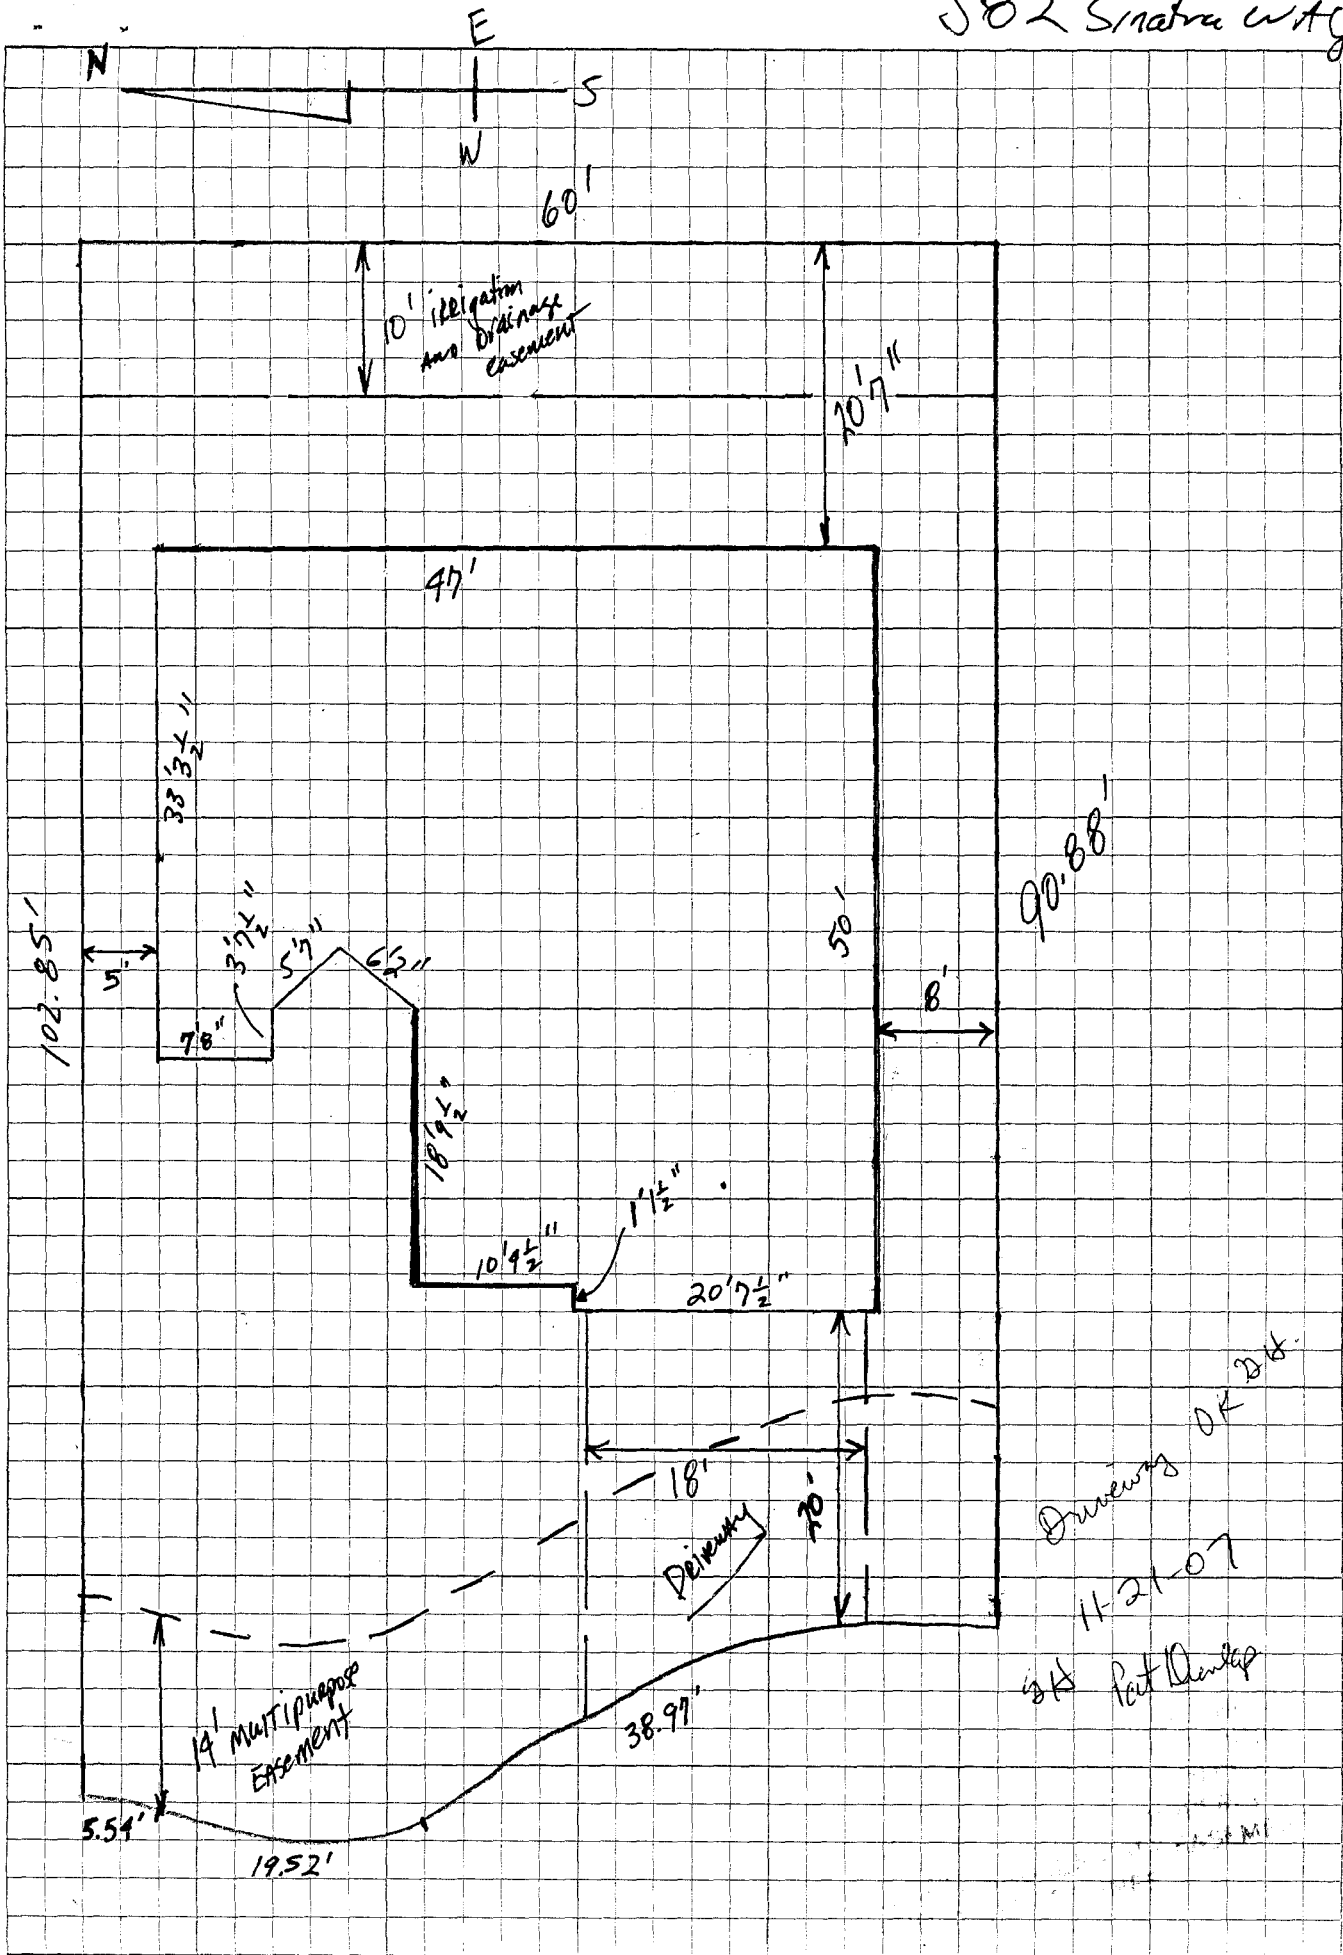

Drawings OK SH
11-21-07
SH Part Develop