

FEE \$ 10⁰⁰
 TCP \$ 1589⁰⁰
 SIF \$ 460⁰⁰

PLANNING CLEARANCE

(Single Family Residential and Accessory Structures)
Community Development Department

BLDG PERMIT NO. _____

Building Address 2452 Theresa Ln.
 Parcel No. 2945 - 041-27-051
 Subdivision Brookwillow
 Filing _____ Block _____ Lot 51

No. of Existing Bldgs 0 No. Proposed 1
 Sq. Ft. of Existing Bldgs N/A Sq. Ft. Proposed 1365
 Sq. Ft. of Lot / Parcel _____
 Sq. Ft. Coverage of Lot by Structures & Impervious Surface (Total Existing & Proposed) _____
 Height of Proposed Structure _____

OWNER INFORMATION:

Name Darter LLC
 Address 786 Valley Ct.
 City / State / Zip GT CO 81505

DESCRIPTION OF WORK & INTENDED USE:

New Single Family Home (*check type below)
 Interior Remodel Addition
 Other (please specify): _____

APPLICANT INFORMATION:

Name Grace Homes
 Address 786 Valley Ct.
 City / State / Zip GT CO 81505
 Telephone 248-8522

***TYPE OF HOME PROPOSED:**

Site Built Manufactured Home (UBC)
 Manufactured Home (HUD)
 Other (please specify): _____

NOTES: _____

REQUIRED: One plot plan, on 8 1/2" x 11" paper, showing all existing & proposed structure location(s), parking, setbacks to all property lines, ingress/egress to the property, driveway location & width & all easements & rights-of-way which abut the parcel.

THIS SECTION TO BE COMPLETED BY COMMUNITY DEVELOPMENT DEPARTMENT STAFF			
ZONE <u>PP</u> <i>per site plan</i>	Maximum coverage of lot by structures <u>per plan</u>		
SETBACKS: Front <u>20'</u> from property line (PL)	Permanent Foundation Required: YES <input checked="" type="checkbox"/> NO <input type="checkbox"/>		
Side <u>per plan</u> from PL Rear <u>per plan</u> from PL	Parking Requirement <u>2</u>		
Maximum Height of Structure(s) <u>per plan</u>	Special Conditions <u>refer to 12/19/06 site plan</u>		
Voting District <u>B</u>	Driveway Location Approval <u>JAR</u> <small>(Engineer's Initials)</small>	<u>FP-2005-144</u>	

Modifications to this Planning Clearance must be approved, in writing, by the Community Development Department. The structure authorized by this application cannot be occupied until a final inspection has been completed and a Certificate of Occupancy has been issued, if applicable, by the Building Department (Section 305, Uniform Building Code).

I hereby acknowledge that I have read this application and the information is correct; I agree to comply with any and all codes, ordinances, laws, regulations or restrictions which apply to the project. I understand that failure to comply shall result in legal action, which may include but not necessarily be limited to non-use of the building(s).


Applicant Signature [Signature] Date 1/29/07
 Department Approval JAR Date 4/30/07

Additional water and/or sewer tap fee(s) are required: YES <input checked="" type="checkbox"/> NO <input type="checkbox"/>	W/O No. <u>20200</u>
Utility Accounting <u>[Signature]</u>	Date <u>4/30/07</u>

VALID FOR SIX MONTHS FROM DATE OF ISSUANCE (Section 2.2.C.1 Grand Junction Zoning & Development Code)
 (White: Planning) (Yellow: Customer) (Pink: Building Department) (Goldenrod: Utility Accounting)

ACCEPTED *DMR* ~~DMR~~
 ANY CHANGE OF SETBACKS MUST BE
 APPROVED BY THE CITY PLANNING
 DEPARTMENT. THE CITY'S
 RESPONSIBILITY IS TO PROPERLY
 LOCATE AND IDENTIFY EASEMENTS
 AND PROPERTY LINES.

BK. 849
 PG. 494

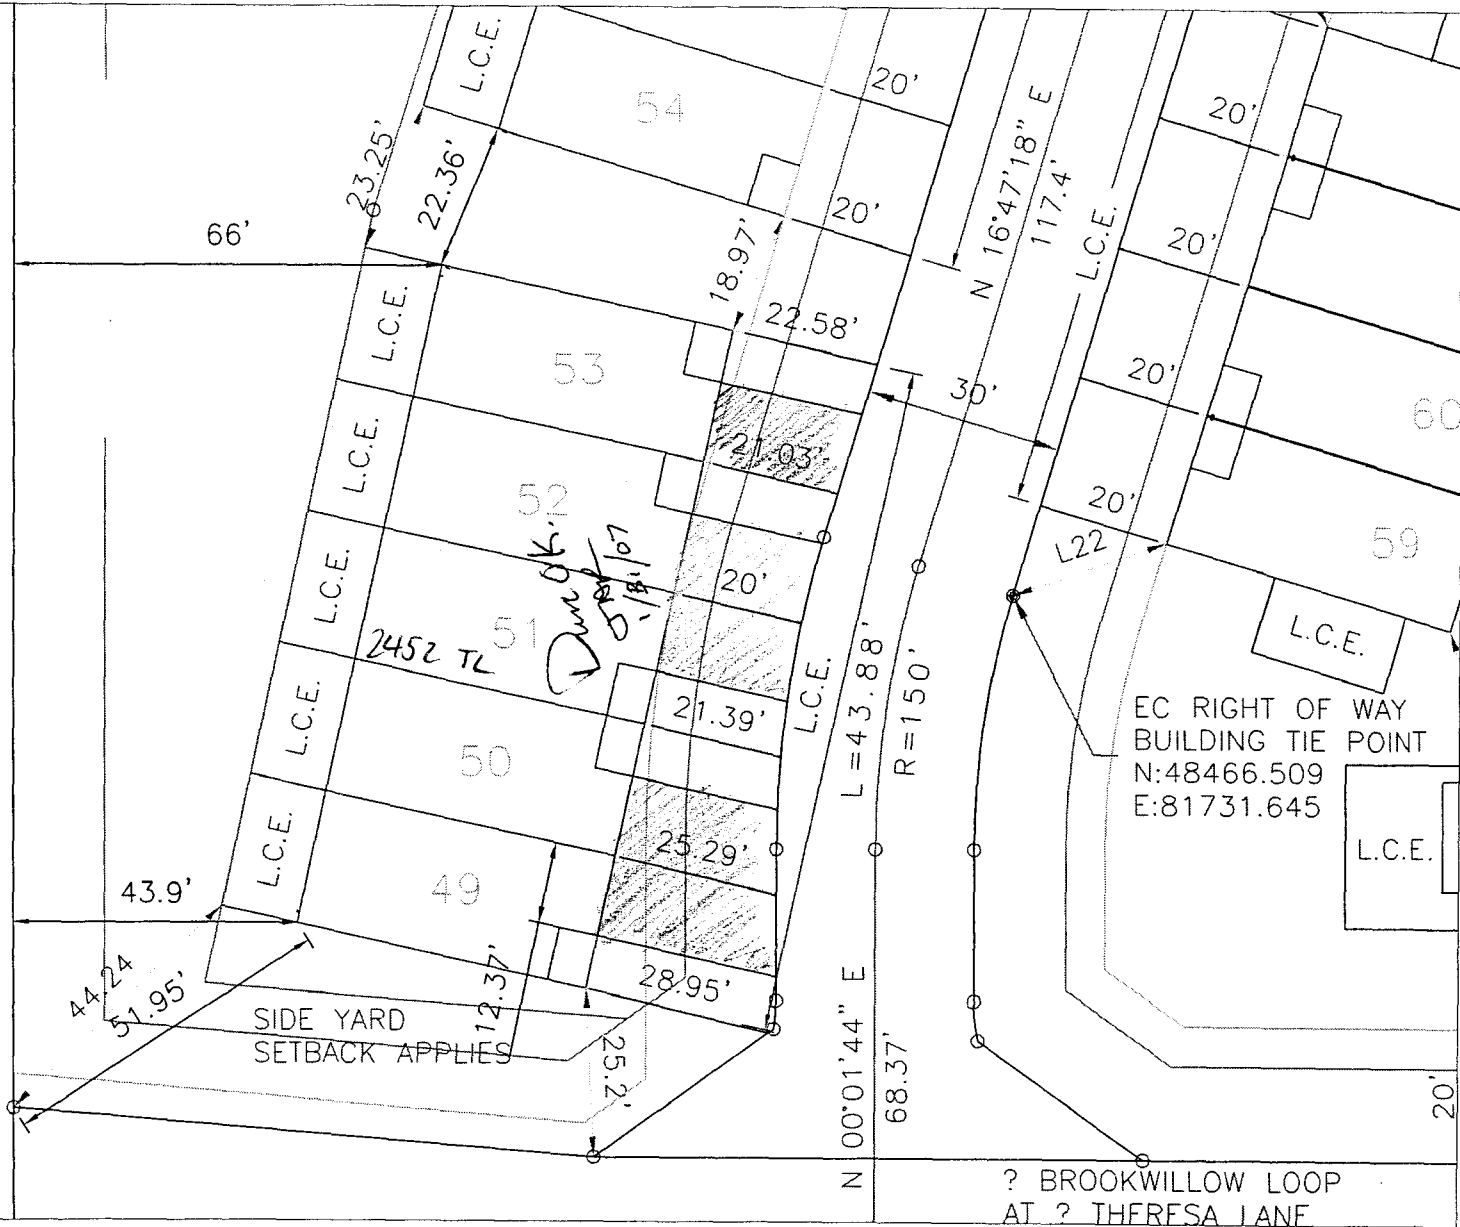

? BROOKWILLOW LOOP
 AT ? THERESA LANE

2452 Theresa Ln. Lot 51